


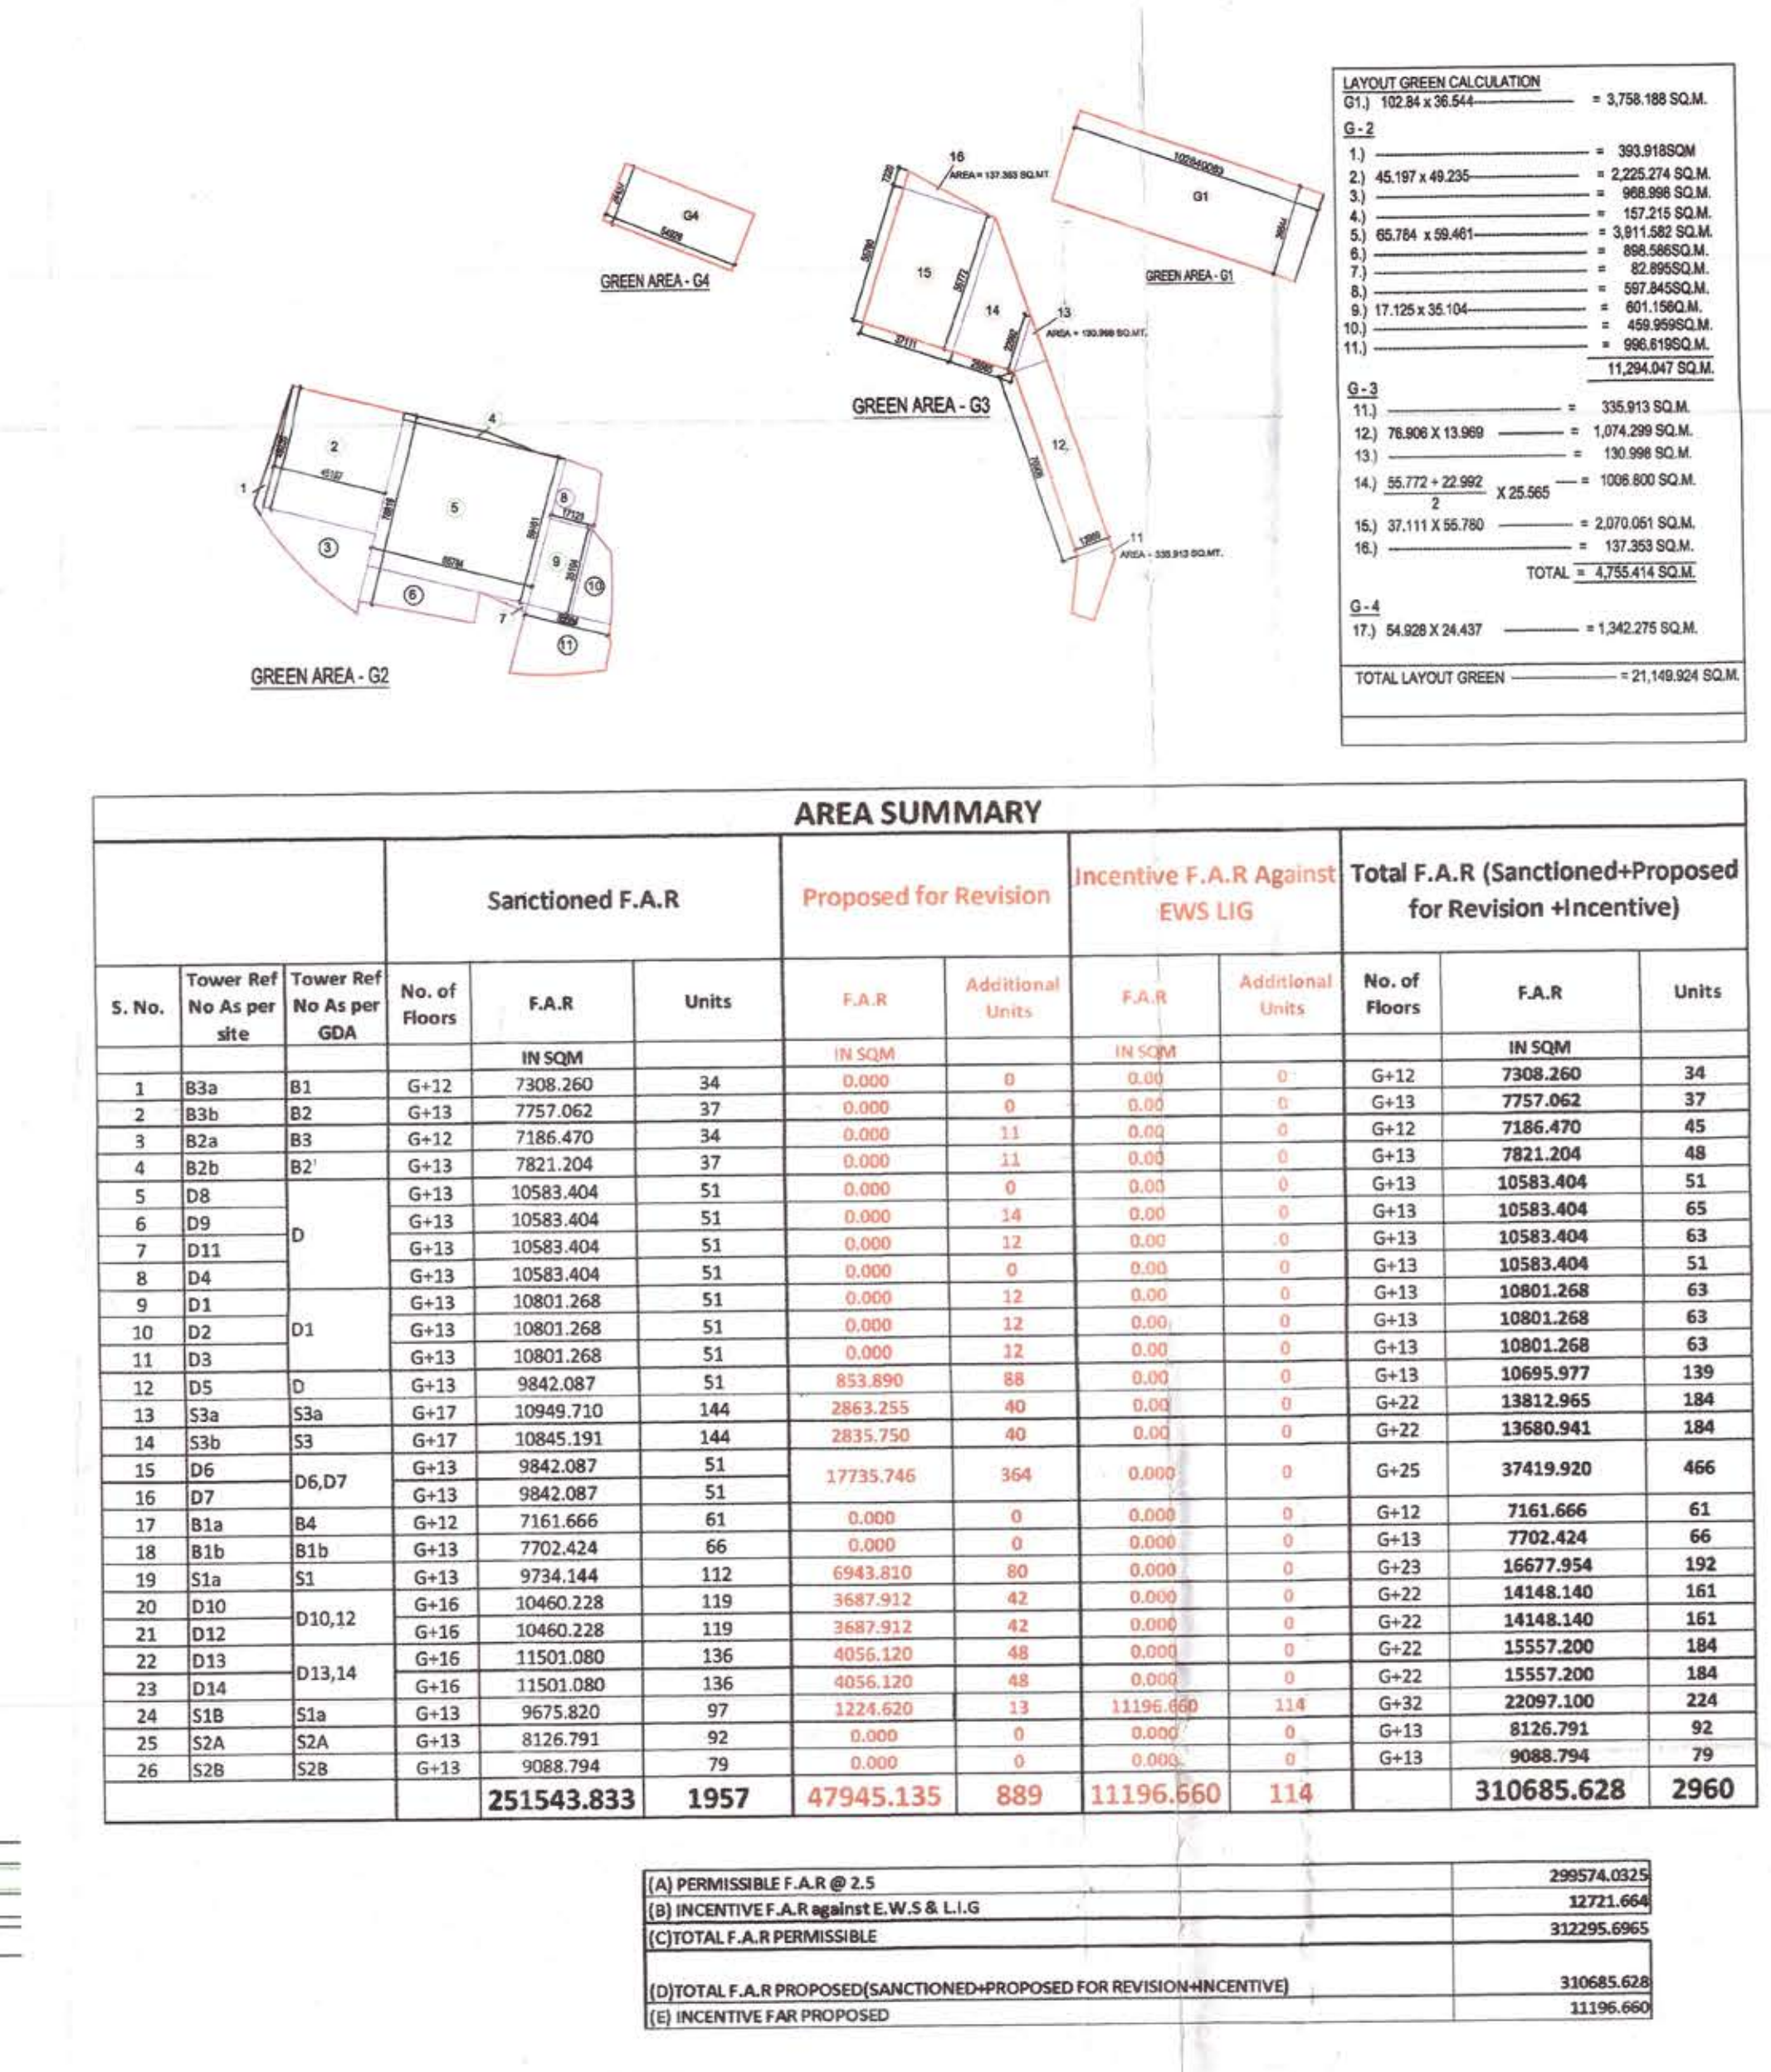

KEY PLAN

The key plan shows the project area (highlighted in yellow) situated between the main road to Kanpur and the Integrated Construction zone. It also indicates the proximity to Residential University High Density and Agriculture Land. The L.M.C Land is shown in green. A north arrow is located at the bottom right.

LEGEND :-

BOUNDARY LINE _____	[Red dashed line symbol]
LAYOUT GREEN (L.G.) _____	[Green hatched box symbol]
KHASRA BOUNDARY _____	[Black outline box symbol]
KHASRA NUMBER _____	[Blue hatched box symbol]
L.M.C LAND _____	[Green solid box symbol]
LAND UNDER ACQUISITION _____	[White box symbol]

TOWERS UNDER REVISION _____	[Light blue hatched box symbol]
COMPLETED / UNDER CONSTRUCTION (sanctioned) _____	[Yellow hatched box symbol]
TOWERS WITH INCENTIVE FAR _____	[Dark blue solid box symbol]

SECTION PLAN

SECTION DETAILS



सर्व निवास
वाणिज्यिक विभाग, महाराष्ट्र
वाणिज्यिक
खण्ड-२
मुंबई
अवर अफिसर
मुंबई

SITE PLAN & AREA DETAILS

SCALE: DATE: DRAWING NO. NORTH

NTS **AP/10.D/GZ/04/REPL/SP/01/13** N

TOWN PLANNER/ARCHITECT

BURGA DESIGNERS
ANAND KUMAR AGGARWAL
REG. No. CA/08/06/7773
Pho G-104, SECTOR-41, NOIDA
99-9810072146, 0125-4357100



ARCHITECT

OWNER SIGN.

OWNER:-

ANSAI PROPERTIES & INFRASTRUCTURE LTD.(CONSORTIUM)

CONSULTANTS:

Rashi Gupta
Architect, Town Planner,
Noida.