


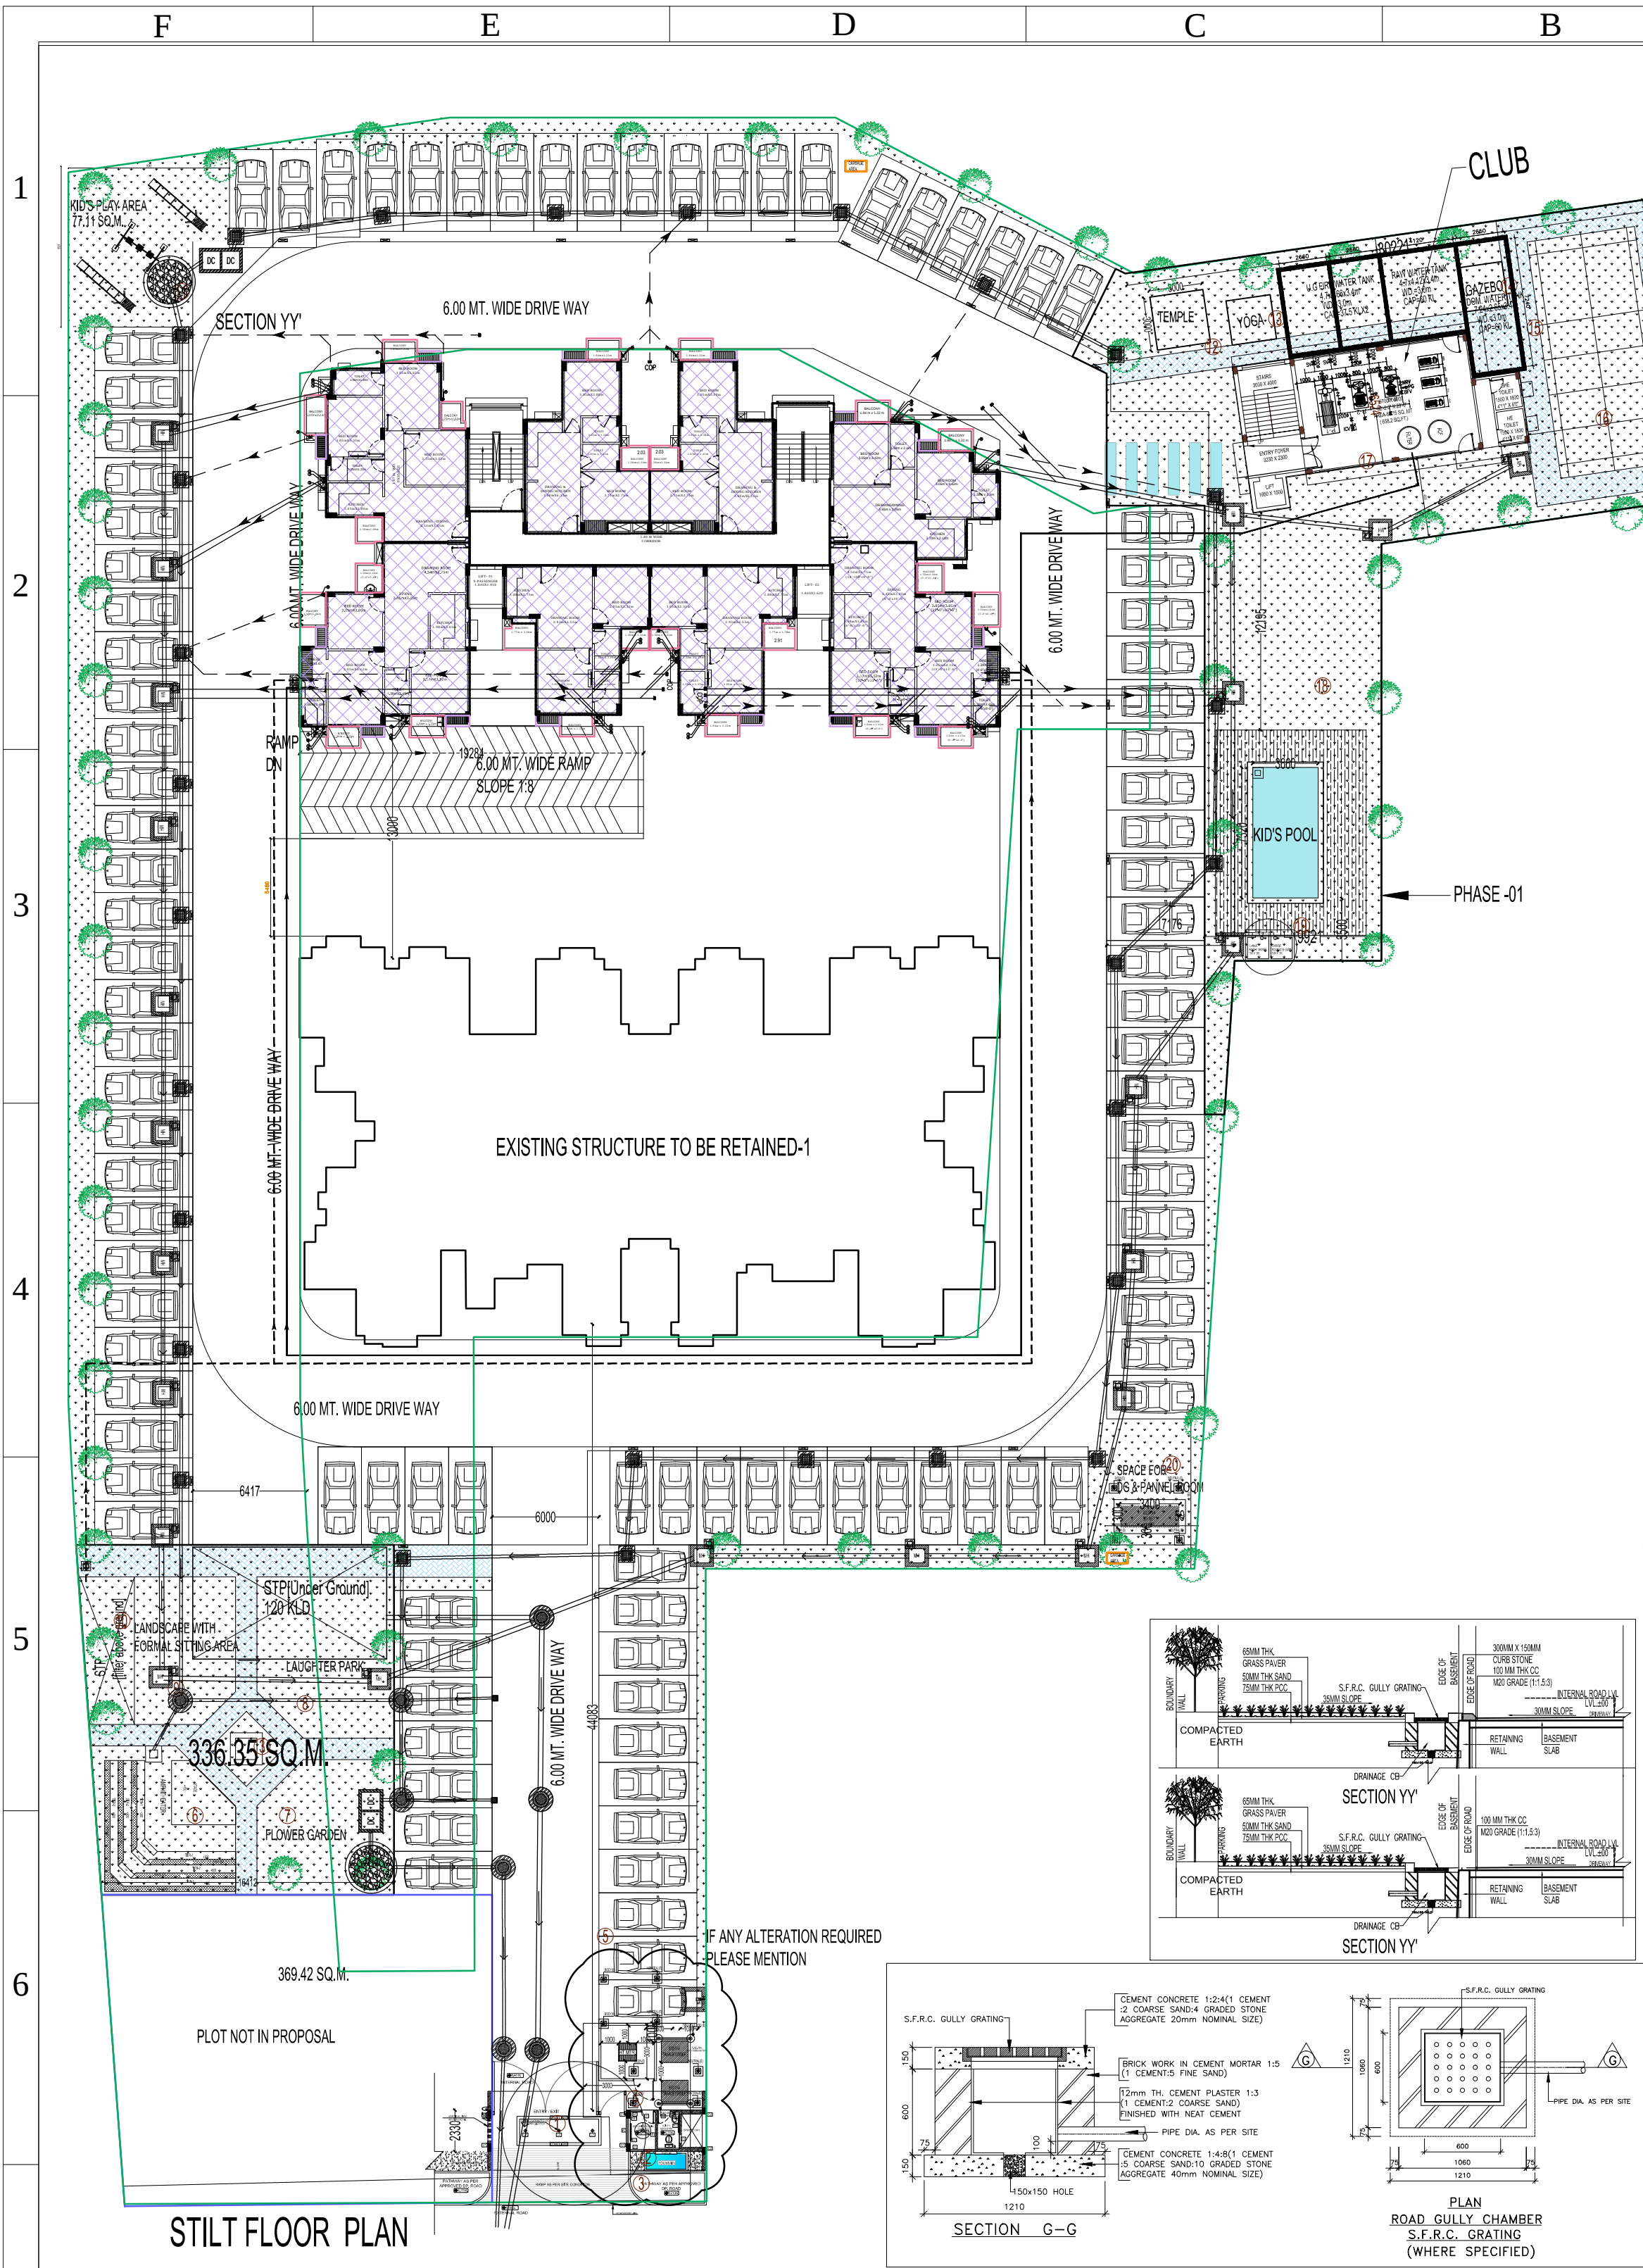

LEGEND:-	
	SEWER LINE
	DRAIN LINE
	CB CATCH BASIN (600X600)
	MANHOLE 900X800
	MANHOLE 910Ø
	RAIN WATER HARVESTING
	DE-SILTING CHAMBER
	GROUND LEVEL
	INVERT LEVEL
	CONNECTION LEVEL
	200Ø L=7.0 S=150 DWS RISER PIPE
	FWS RISER PIPE
	VC VALVE CHAMBER (300X300)

REFERENCE DRAWINGS:			
S.No	DRAWING NO.	REV.	TITLE
5.		0	
4.		0	
3.		0	
2.		0	
1.		1	
2			
1			
0	SUBMISSION AS-BUILT-DRAWING		
D	SUBMISSION FOR GFC		
A	SUBMISSION FOR REVIEW		
REV	DESCRIPTION	DSGN	DRWN
REVISION DETAILS			

CLIENT:
M/S.RUDRA BHAWAN NIRMAL LLP.
RUDRA HOUSE, 15/63 CIVIL LINES KANPUR
KANPUR UP 208001 IN
THROUGH ITS AUTHORIZED SINGTORY-----
MR.ANAND KUMAR AGRAWAL
S/O. LATE. ASHOK KUMAR AGRAWAL
C.K. 65/159 A, PIYARI KALA CHOWK,
VARANASI.

ARCHITECTURE & SERVICES (IN HOUSE):

RUDRA REAL ESTATE PRIVATE LTD.
ADD. 1st Floor, 15/63, RUDRA HOUSE,
CIVIL LINES, KANPUR, KANPUR NAGAR,
UTTAR PRADESH, 208001
Contact : 0512 - 2304003
email : arpan.mishra@rudra.net.in

NNC DESIGN INTERNATIONAL
CONSULTING STRUCTURAL ENGINEERS
G-70, 2nd Floor, JASWANT PLAZA, NEAR KALINDI KUNJ
MAIN SARITA VIHAR ROAD, OKHLA, NEW DELHI-110055
PHONE NO. : +91-11-26949734/5/6/7/8 FAX: 26949735
E-Mail : nnc_consultants@hotmail.com
Web : www.nncdesigninternational.com

PROJECT :-
PROPOSED RESIDENTIAL GROUP HOUSING AT ARAZI
NO.1061,1062,1063,1064,1065,1066,1067, & 1101 MAUZA-
DAREHKU, PARGANA- KASWAAR RAJA, TEHSIL -
RAJATALAB DISTT.- VARANASI

CIVIL & MEP CONSULTANT
MSC and Associates
301-306, Pankaj Tower L.S.C
Mayur Vihar Phase-1 Delhi 110091
Phone: 9810276455; 01145610113
E-mail:mscandassociates@yahoo.co.uk
mscingemierie@gmail.com

TITLE :-	
EXTERNAL PHE LAYOUT	
BUILDING : RESIDENTIAL TOWER	
JOB No.:	DATE
NAME	SIGN
DATE	PROJECTION
DSGN	Hukom Rowat
DRWN	10.10.2023
CHKD	M.K
APPD	MSC
DRG.No.:	SCALE
MS-C-RDR-IVARANASI-1-PHE-01	1:200
REV:	0