


12.0 MT. WIDE ROAD

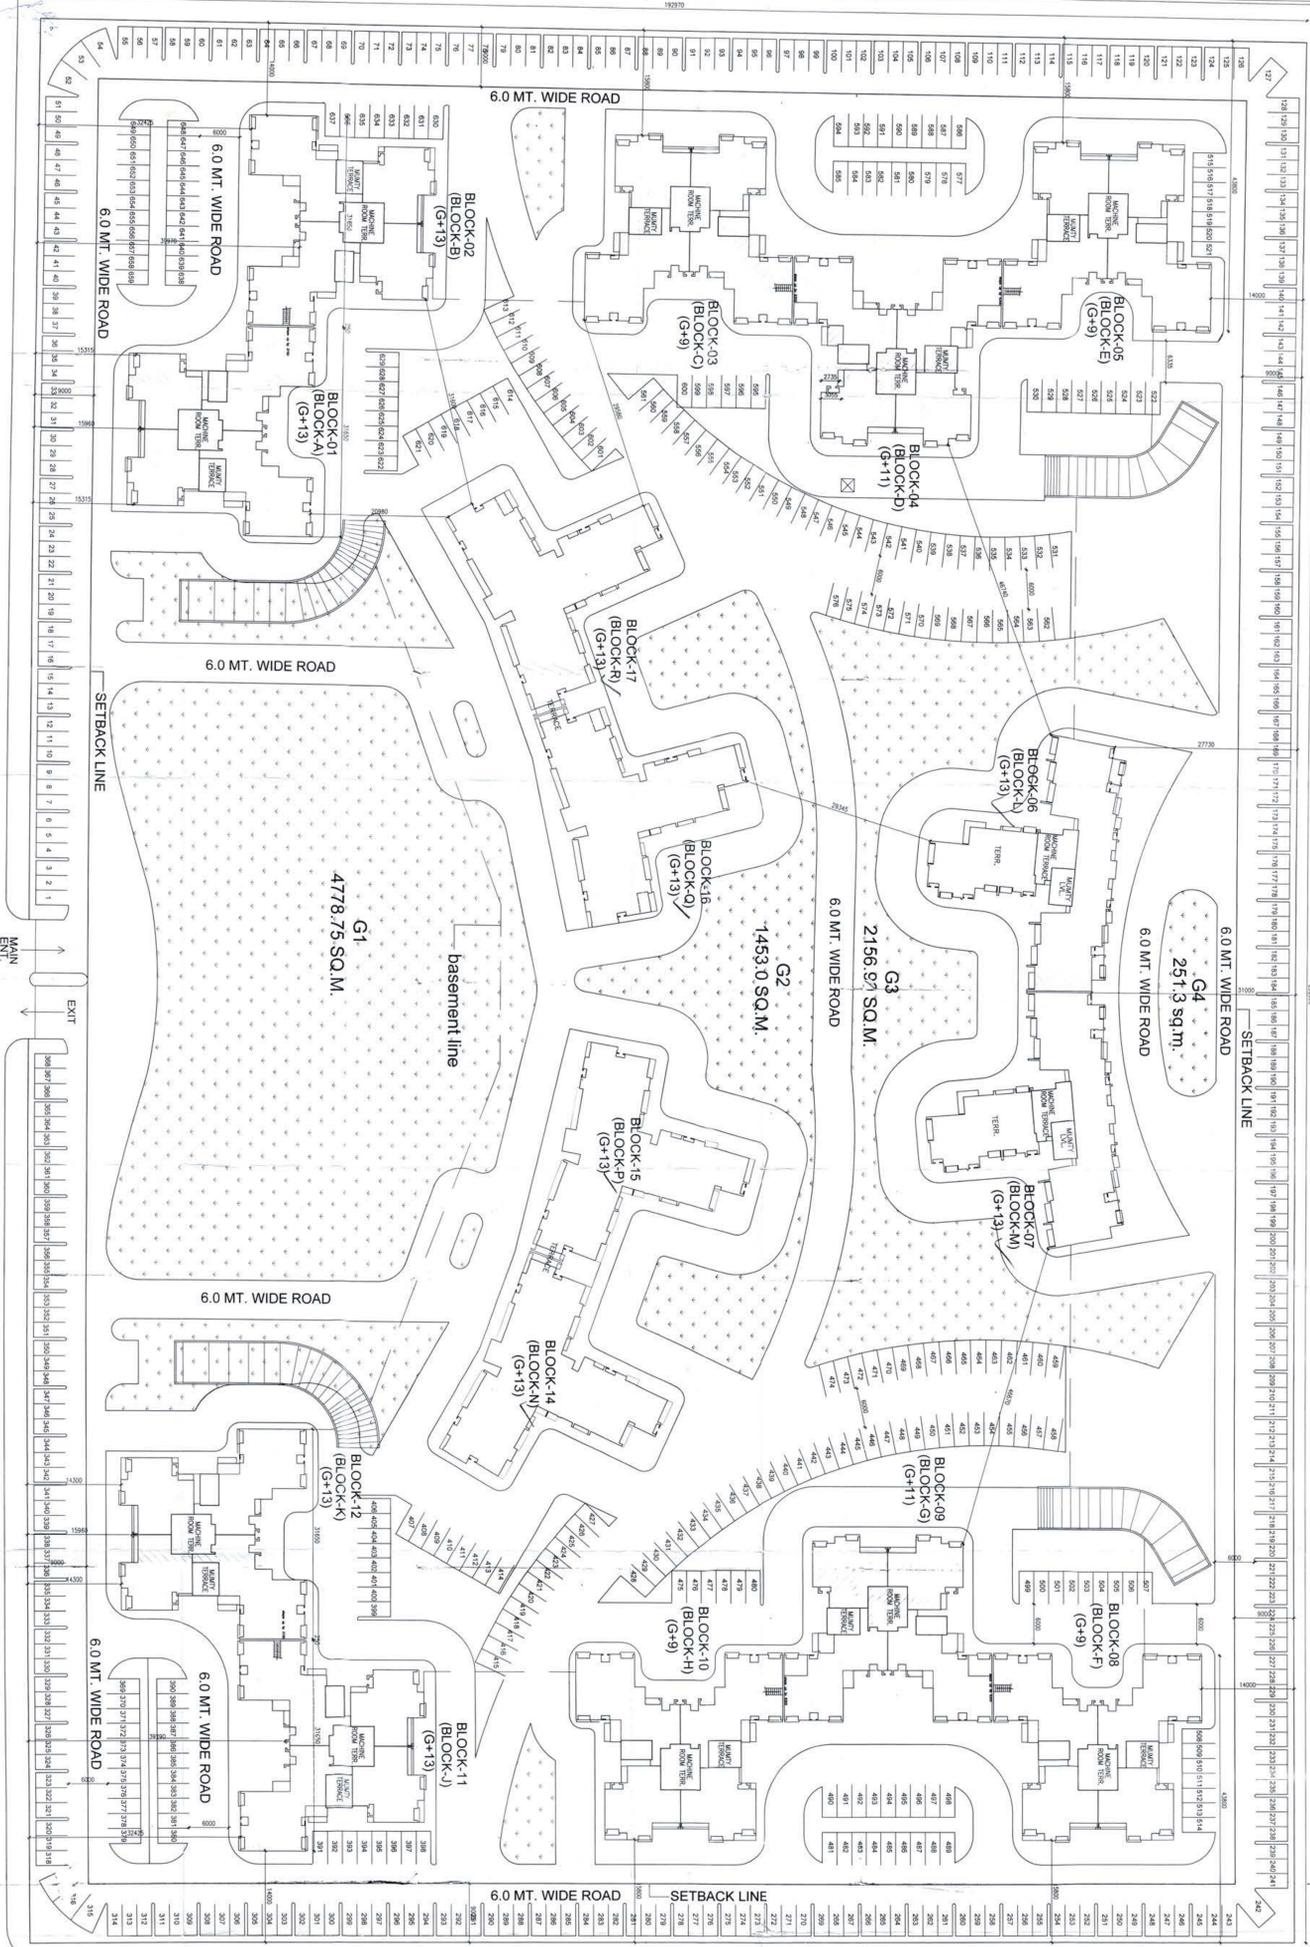

CALCULATIONS OF AREAS


Table with 4 columns: Sl. No., Plot Area, No./% (sq.m, acres, ha), and Area. Includes rows for F.O.T. AREA, PERMISSIBLE FAR ON PLOT AREA, PERMISSIBLE DENSITY ON PLOT AREA, and PARKING CALCULATIONS.

AREA OF CELEBRITY GARDEN (PLOT-2, SECTOR-B)

Table with 10 columns: BLOCK NAME, GROUND COVERAGE, APPROVED AS BUILT, TOTAL F.A.R. PROPOSED, ADDITIONAL F.A.R. APPROVED EXISTING, ADDITIONAL F.A.R. PROPOSED, TOTAL ADDITIONAL F.A.R., TOTAL ADDITIONAL COMPUNDING AREA, and NO. OF FLATS. Lists blocks from BLOCK-1 to BLOCK-17.

DETAILED CALCULATION OF GREEN

Table with 4 columns: Name, Area (in Sq.m), G1, G2, G3, G4, and TOTAL. Lists green areas G1 (4778.75), G2 (1453.00), G3 (2156.99), G4 (251.3), and TOTAL (8640.04).

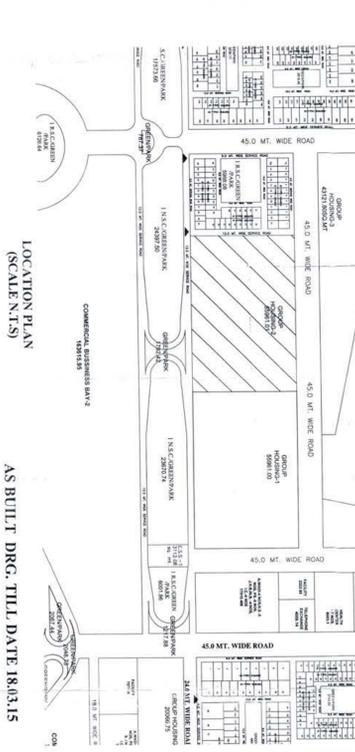

CELEBRITY GARDEN
OWNERS: ANSAL PROPERTIES & INFRASTRUCTURE LTD.
CONSULTANT: REPL
AS BUILT DRG. TILL DATE 18.03.15

Large table titled 'AREA OF CELEBRITY GARDEN (PLOT-2, SECTOR-B)' with columns for NAME, ADDRESS, FLOOR AREA, and various area calculations for each block.

PROJECT: COMPOUNDING CLUM
PROPOSING DRAWING: OF GROUP HOUSING
(CELEBRITY GARDEN)
ON PLOT-2 (13.83 ACRES)
AT SOCKET-1, SECTOR-B,
SUSHANT GOLF CITY, PUNE-40
TOWNSHIP, LUCKNOW.