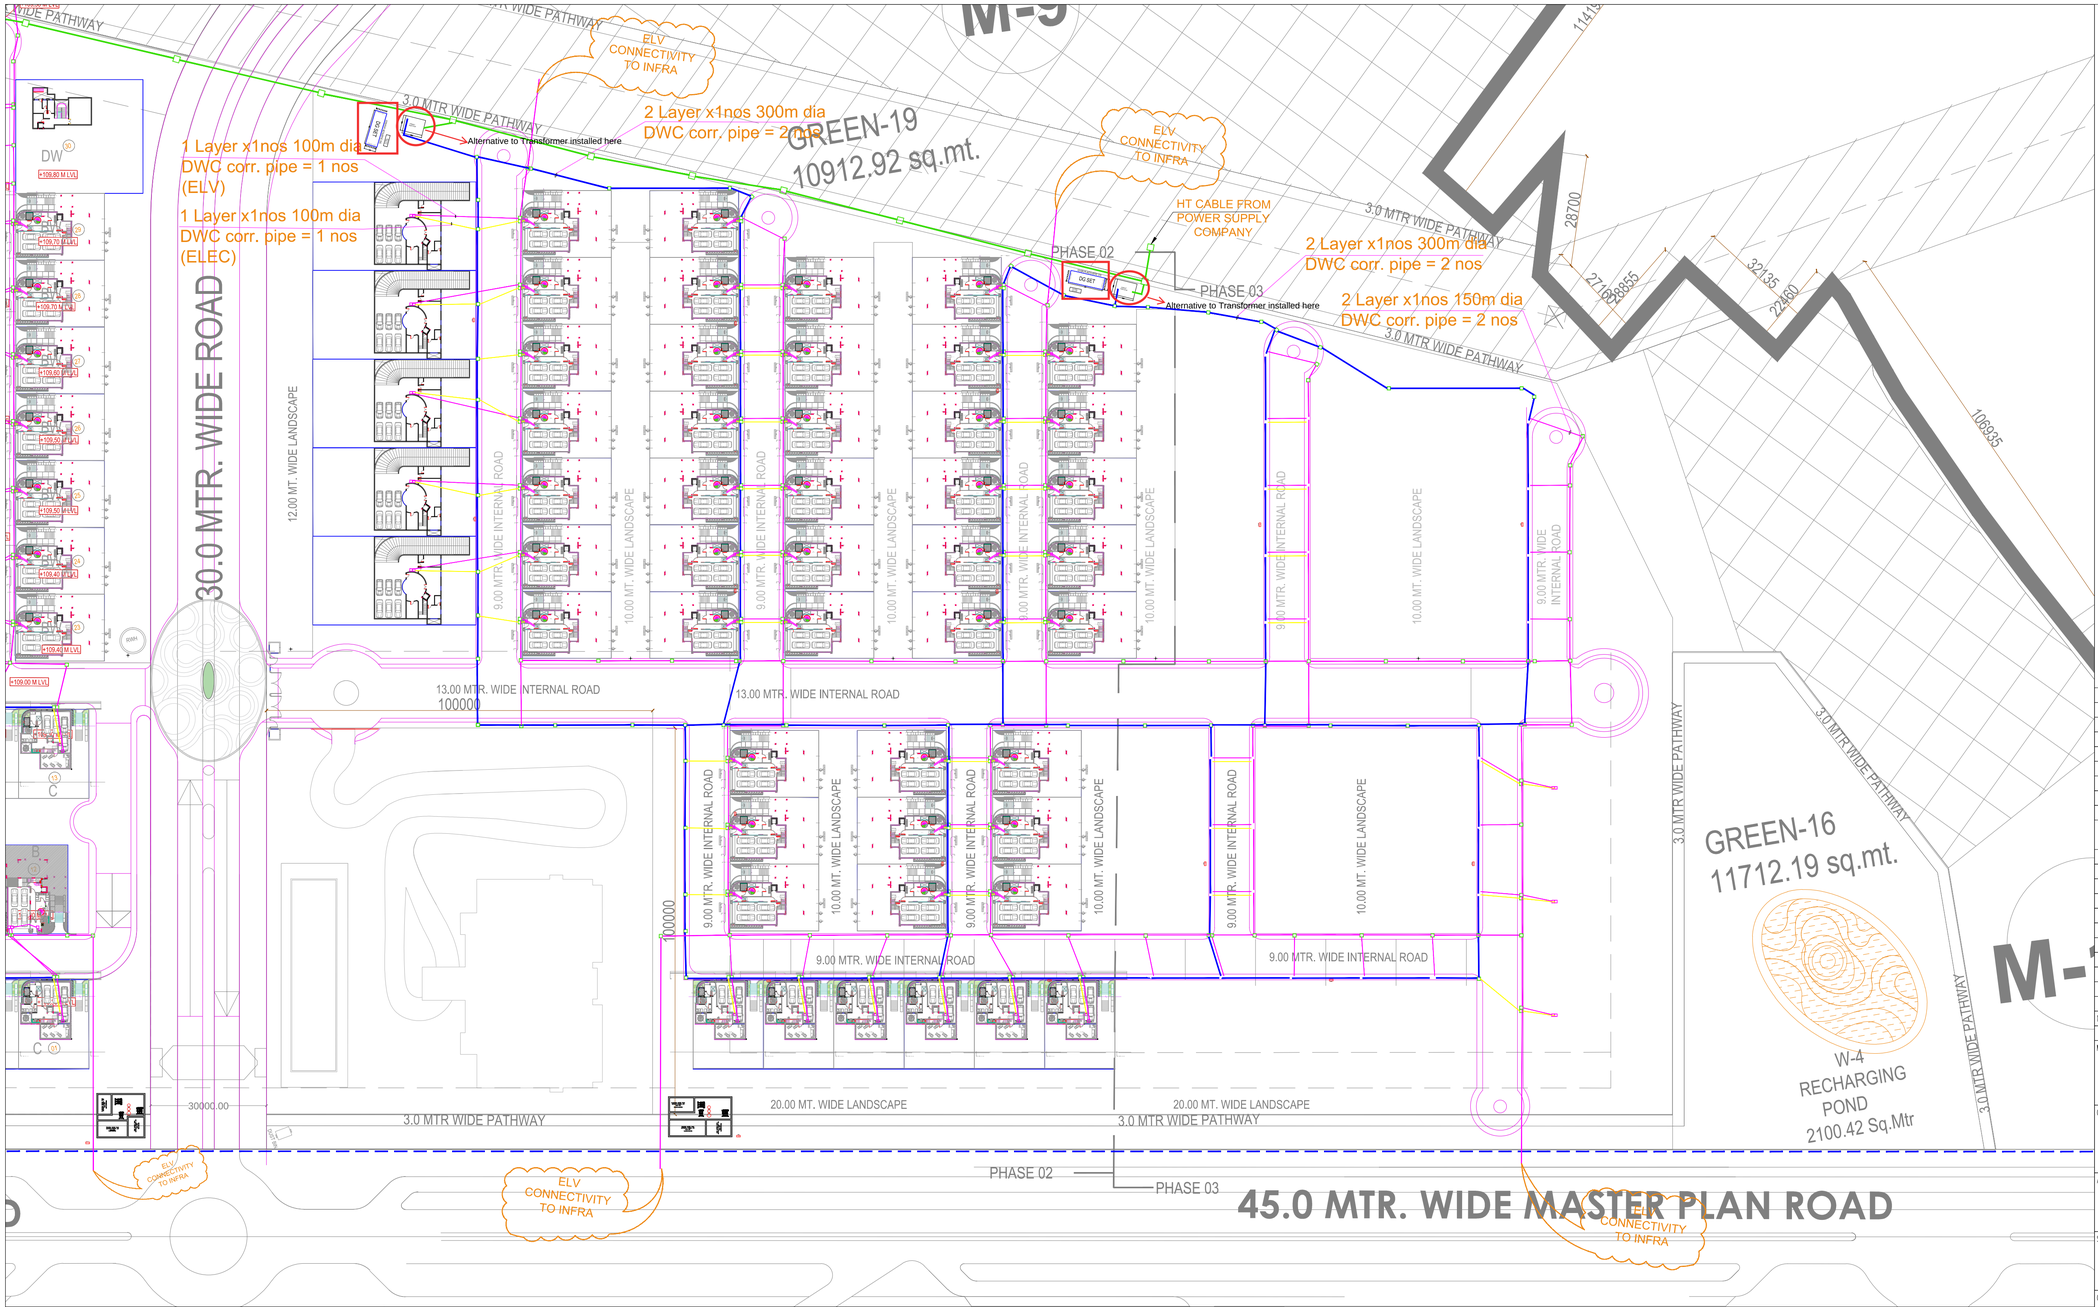

SR.NO	DESCRIPTION	LEGENDS
01	SOIL PIPE	
02	STORM WATER PIPE	
03	900mm X 450mm SEWAGE CHAMBER	
04	600mm/900mm SEWAGE CIRCULAR MANHOLE	
05	STORM WATER CHAMBER 650x650mm	
06	600mm/900mm STORM WATER CIRCULAR MANHOLE	

LEGEND:- ELECTRICAL

SR.NO	DESCRIPTION	LEGENDS
01	300MM 2NOS ELECTRICAL DWC corr PIPE BELOW 1200MM FROM GROUND	
02	HT 300MM ELECTRICAL DWC corr PIPE BELOW 1200MM FROM GROUND	
03	150mm 2NOS ELV DWC corr PIPE BELOW 1200MM FROM GROUND	
04	100mm 1NOS DWC corr PIPE FOR ELECTRICAL CABLE BELOW 1200MM FROM GROUND	
05	100mm 1NOS DWC corr PIPE FOR ELV CABLE BELOW 1200MM FROM GROUND	
06	(L)750mmX750mm (D)1200mm CHAMBER	
07	(L)750mmX750mm (D)900mm ELECTRICAL CHAMBER	
08	(L)750mmX750mm (D)750mm ELV CHAMBER	
09	FEEDER PILLAR (1 TO 24)	FP

LEGEND:- ELECTRICAL

3 PH METER	3–PHASE METER
	MAIN DISTRIBUTION BOARD
	ELV DISTRIBUTION BOARD
	ELECTRICAL CUTOUT
	ELV CUTOUT

COMMENTS :		APPROVAL :	✓
DD		TENDER COPY :	
GFC :		AS BUILT :	

REFERENCE DRAWINGS

DATE	DESCRIPTION	DWG. No.

No.	DATE	DESCRIPTION	DRN	CHK
R2	24–06–2022	ISSUED FOR APPROVAL	MYB	SM
R1	21–02–2022	ISSUED FOR APPROVAL	ZH	SM

REVISIONS

MEP CONSULTANTS

M/s. CHETTIAR CONSULTING ENGINEERS.
SHRI SAI CORPORATE PARK, 304, THIRD FLOOR, NEW LINK ROAD
MAHAKALI TEMPLE ROAD, NEAR VASANT GALAXY B
LAXMI NAGAR, GOREGAON (WEST), MUMBAI 400 063
TEL.: +91 22 28767600 Email: info@cce.net.in

CONSULTANT ARCHITECTS

RCC-CONSULTANT
SERVICE-CONSULTANT
PROJECT_ARCH

ARCHITECT

Architect Hafeez Contractor

STRUCTURAL

JW STRUCTURE
JW CONSULTANTS LLP

CLIENT

SHALIMAR ONEWORLD

PROJECT

SHALIMAR VILLA

DRAWING TITLE

ELECTRICAL & ELV MASTER LAYOUT

SERVICE	ELECTRICAL			
NORTH	NORTH–1	LEVEL	SITE PLAN	
		SIGN_BY		
DRAWN BY	MYB	CHECKED	SM	NO
SCALE	NTS	DATE	APPROVED	SL-163

DRAWING–NO

SL-163-ELEC-100

REV.	R2	REV. DATE	24.06.2022