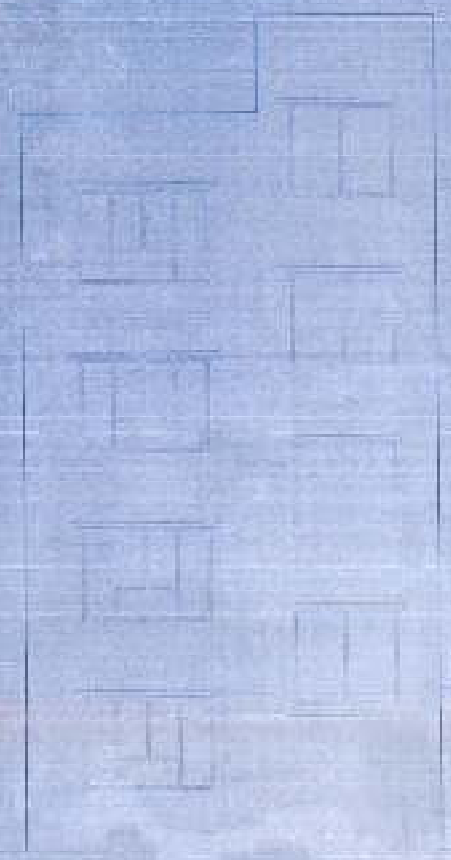

SIDE B ELEVATION

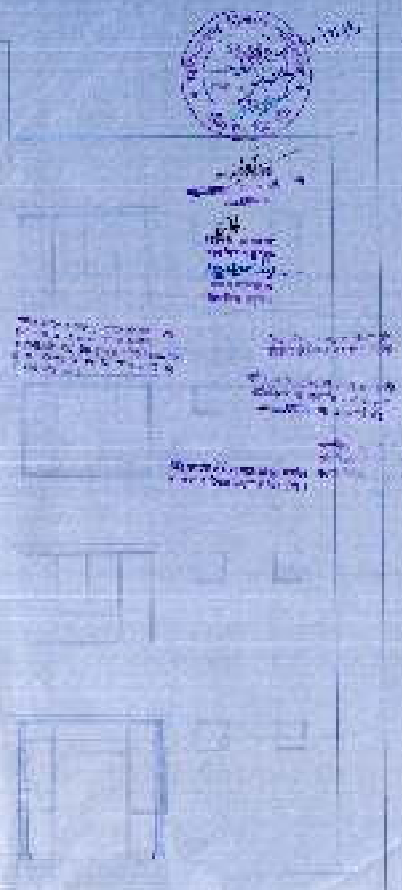

SIDE A ELEVATION

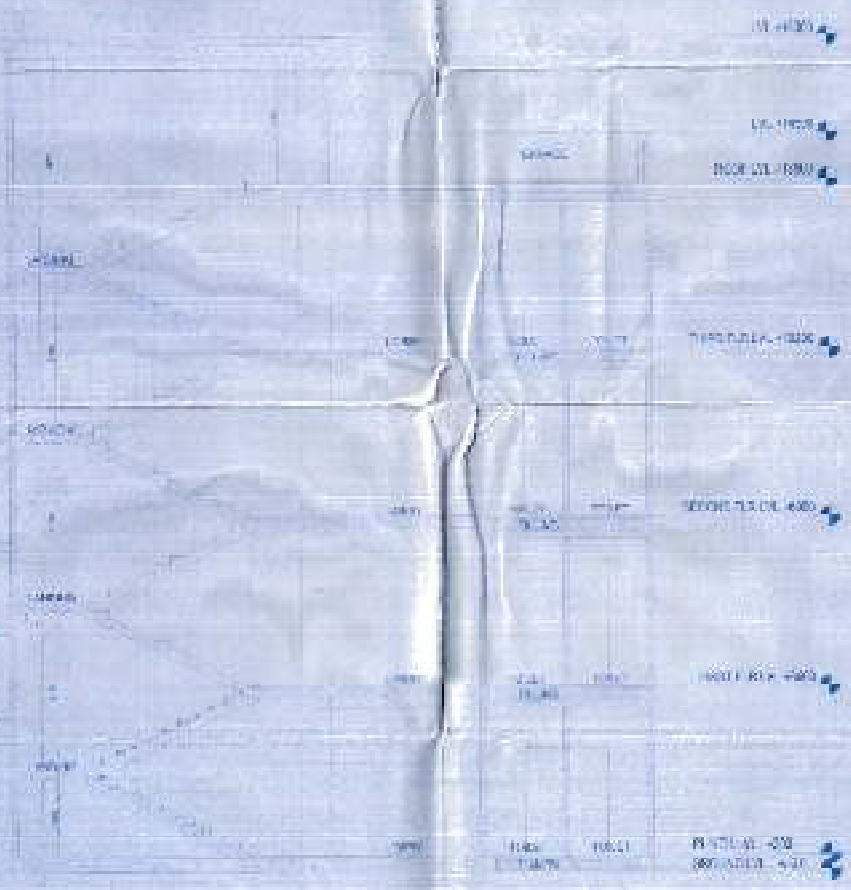

SECTION AA'

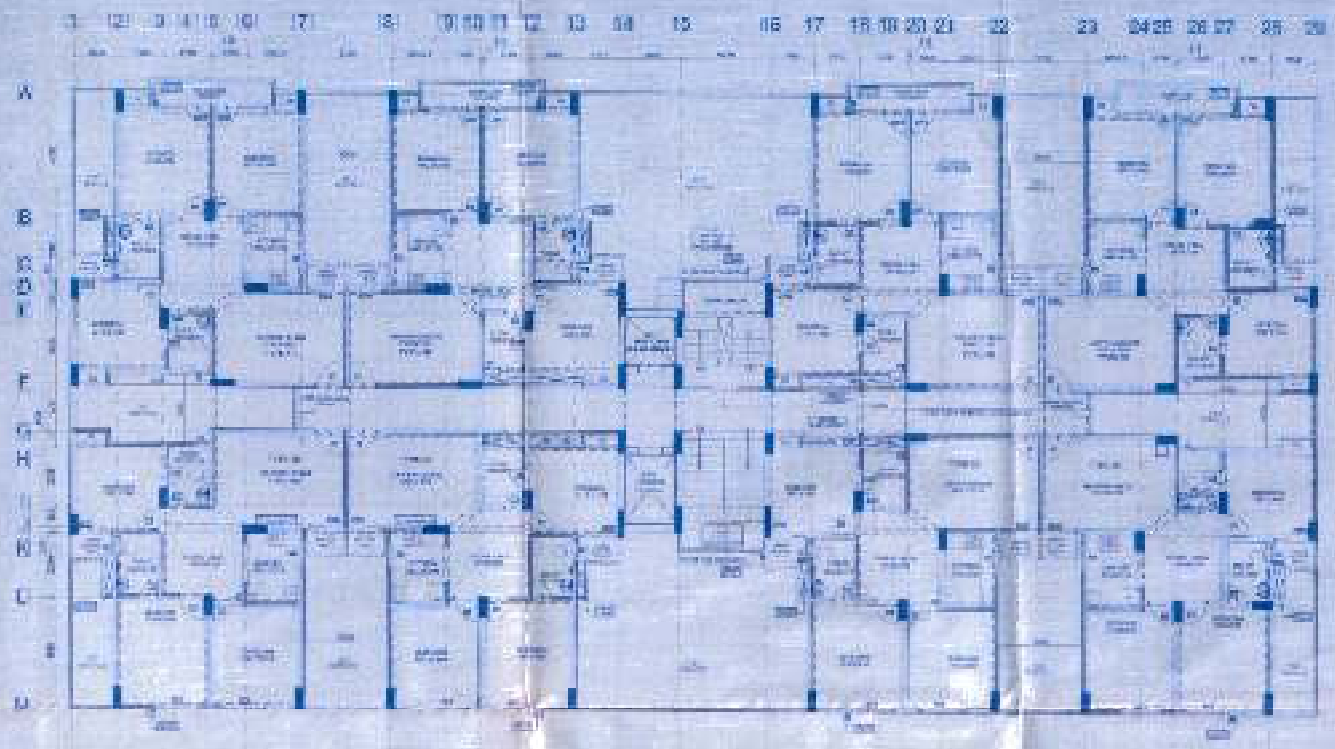

FIRST FLOOR PLAN

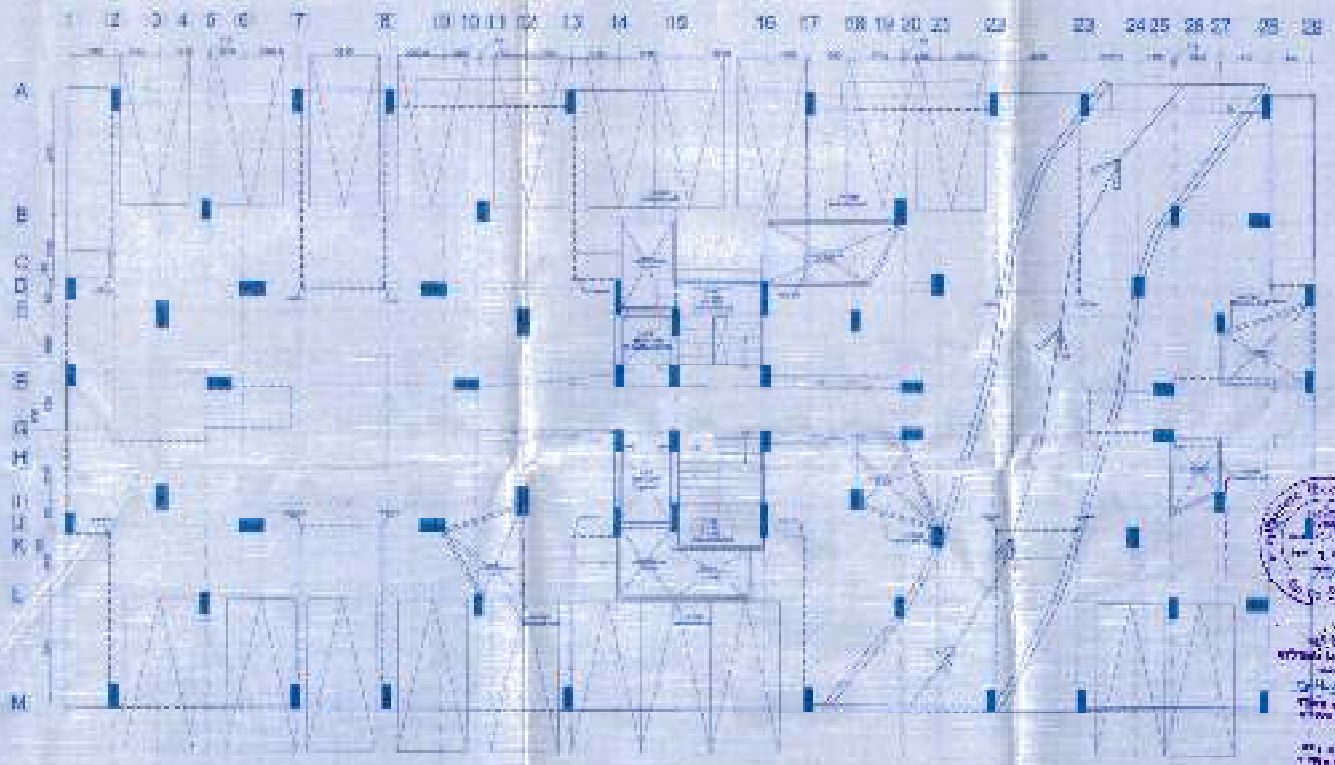

PLINTH PLAN

OPENING SCHEDULE OF DOORS & WINDOWS				
S.NO.	TYPE	SIZE (MM)	SILL (MM)	LINTEL
1	D.W1	[illegible]	[illegible]	[illegible]
2	D.W2	[illegible]	[illegible]	[illegible]
3	D	[illegible]	[illegible]	[illegible]
4	D1	[illegible]	[illegible]	[illegible]
5	D2	[illegible]	[illegible]	[illegible]
6	W	[illegible]	[illegible]	[illegible]
7	W1	[illegible]	[illegible]	[illegible]
8	V	[illegible]	[illegible]	[illegible]
9	V1	[illegible]	[illegible]	[illegible]

PLINTH FLOOR PLAN

ARG

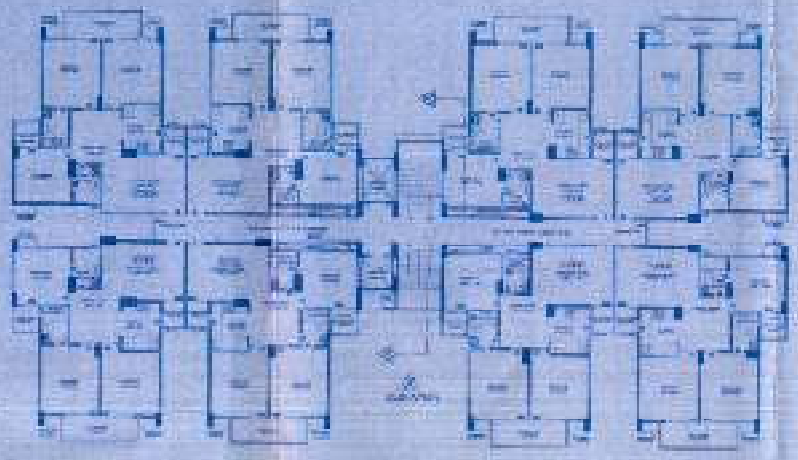

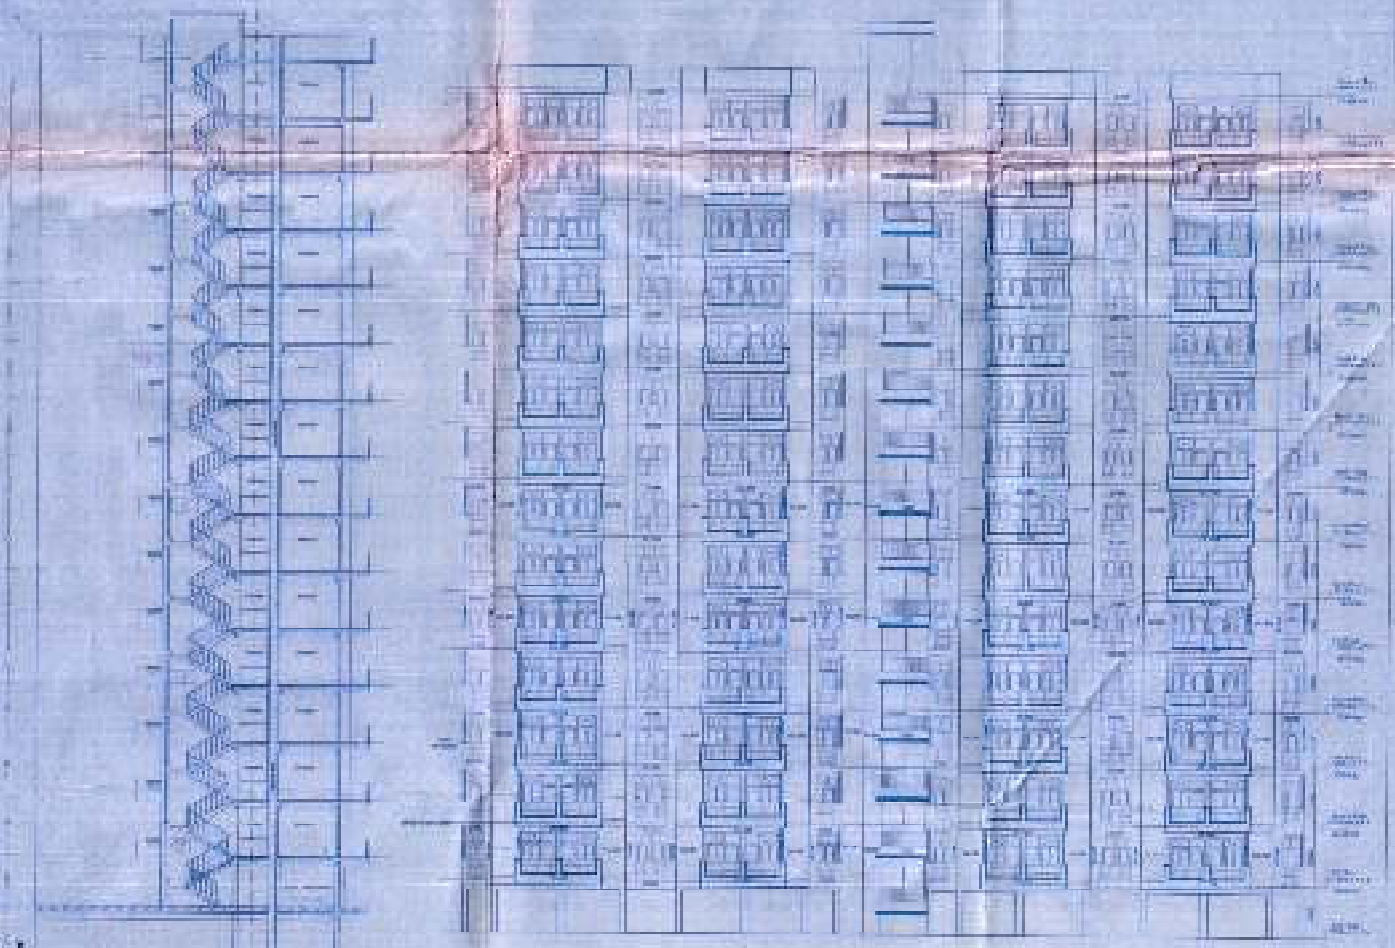

FRONT ELEVATION

SECTION - AA

PROJECT :

ADDITION & ALTERATION IN SANCTIONED DRAWING FOR GROUP HOUSING "DIKSHA" RESIDENCY" AT KHASRA NO. [illegible] AT VILLAGE BOURAKALAN GHAZIABAD (UP)

OWNER :

M/s. [illegible] INFRASTRUCTURE PVT. LTD. [illegible]

DRAWING TITLE

ELEVATION & SECTION (BLOCK - C)

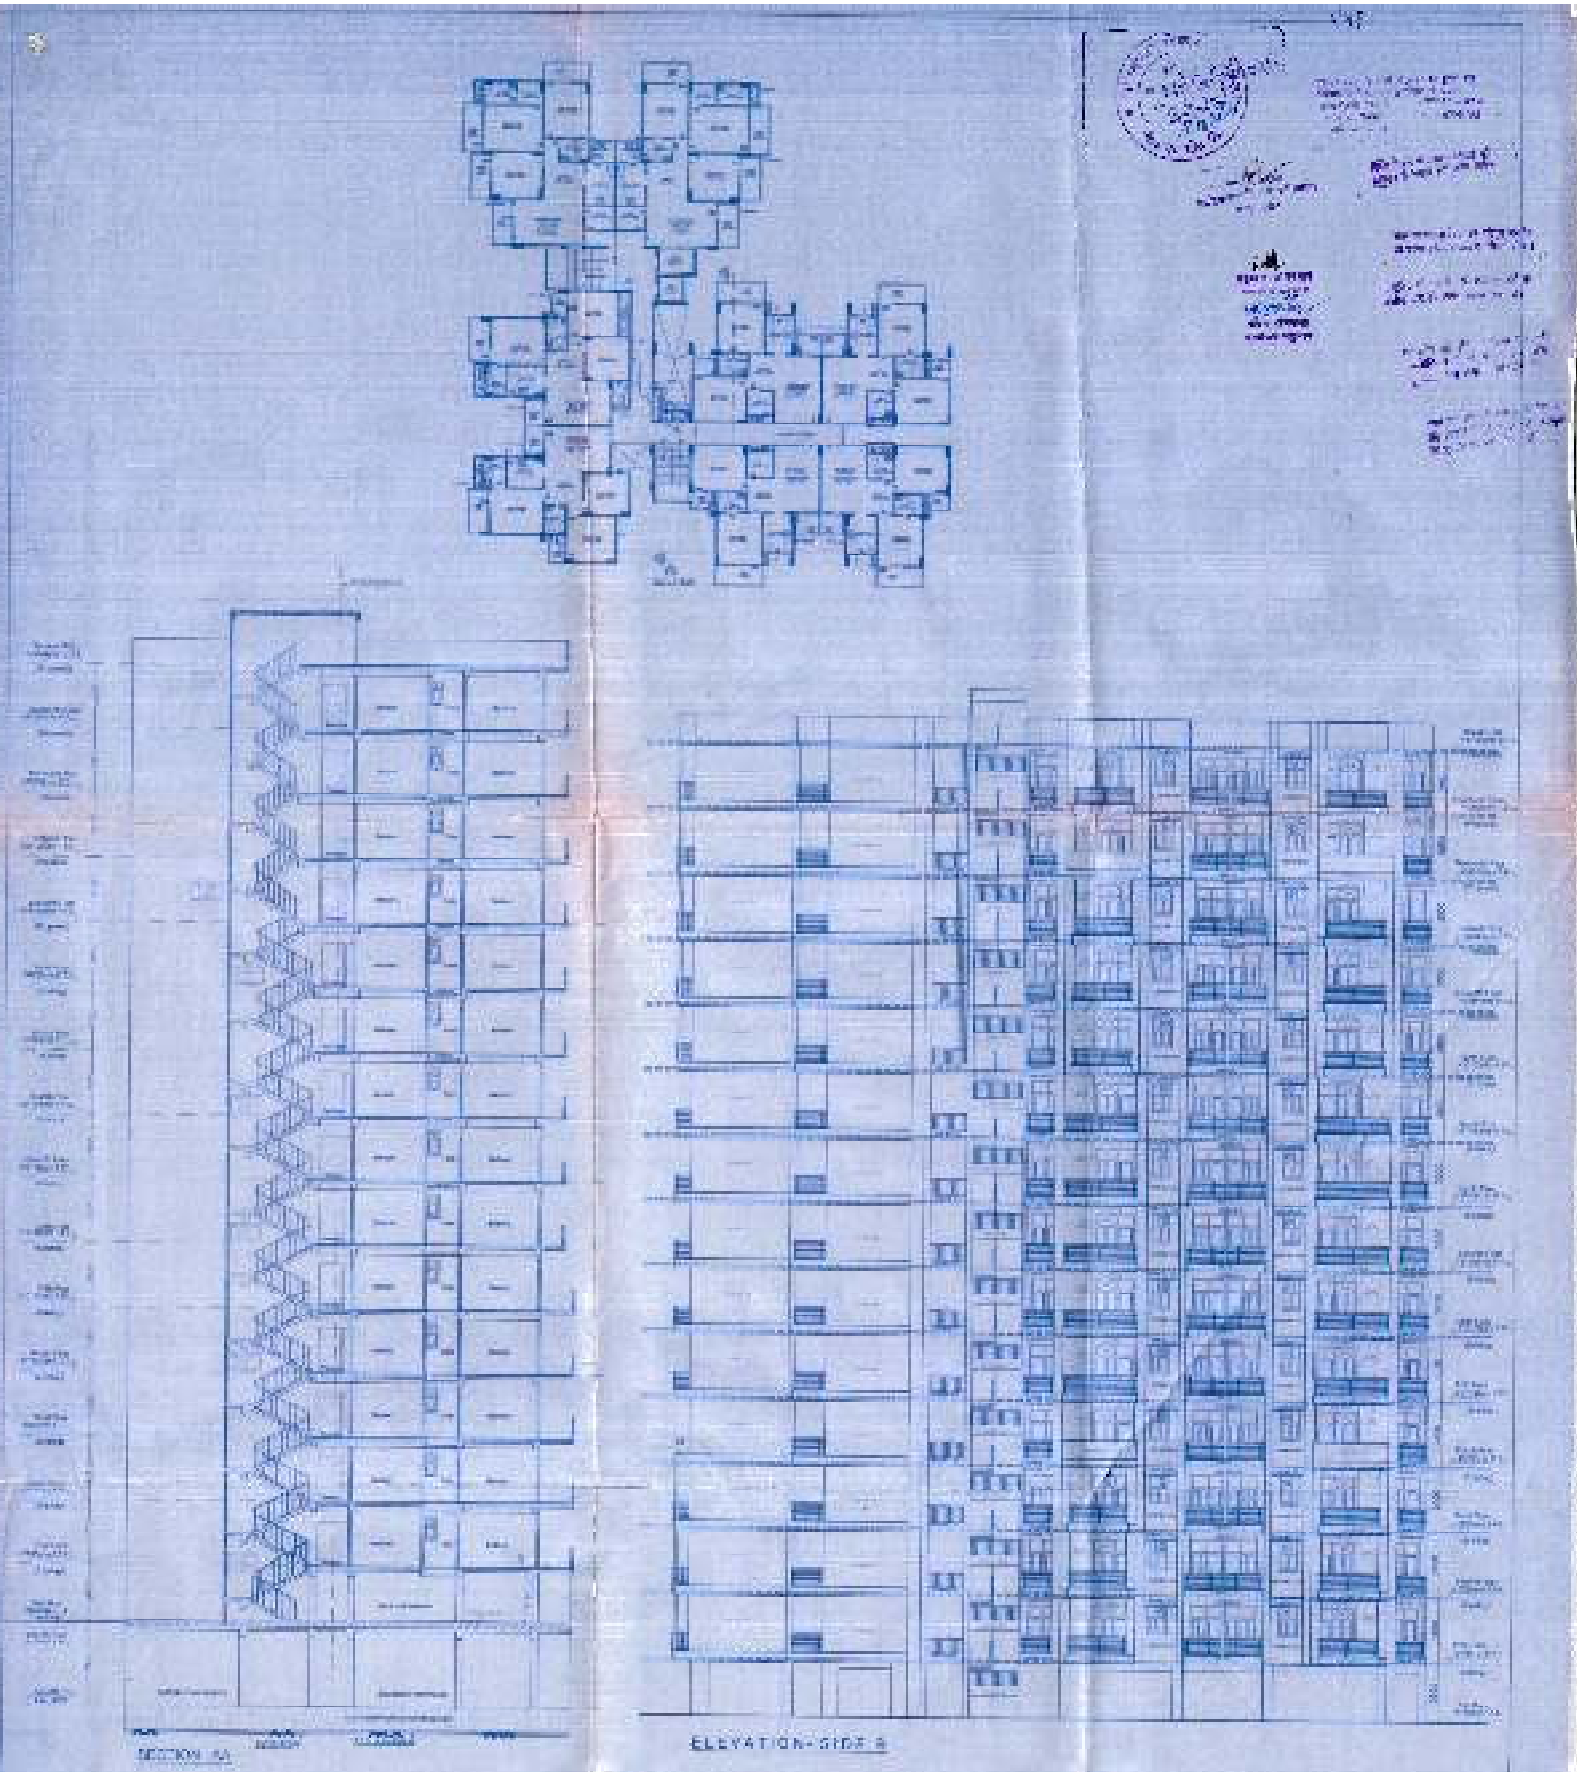

PROJECT :

ADDITION & ALTERATION IN SUBMISSION DRAWING FOR GROUP HOUSING "FORTUNE RESIDENCY" AT PHASE-II NO. 1123, 1118 AT VILLAGE KOORNAGAR GHAZIABAD (U.P.)

OWNER:

M/s. VASU INFRASTRUCTURE PVT. LTD.
AND OTHERS

DRAWING TITLE

ELEVATION & SECTION
(BLOCK - A)

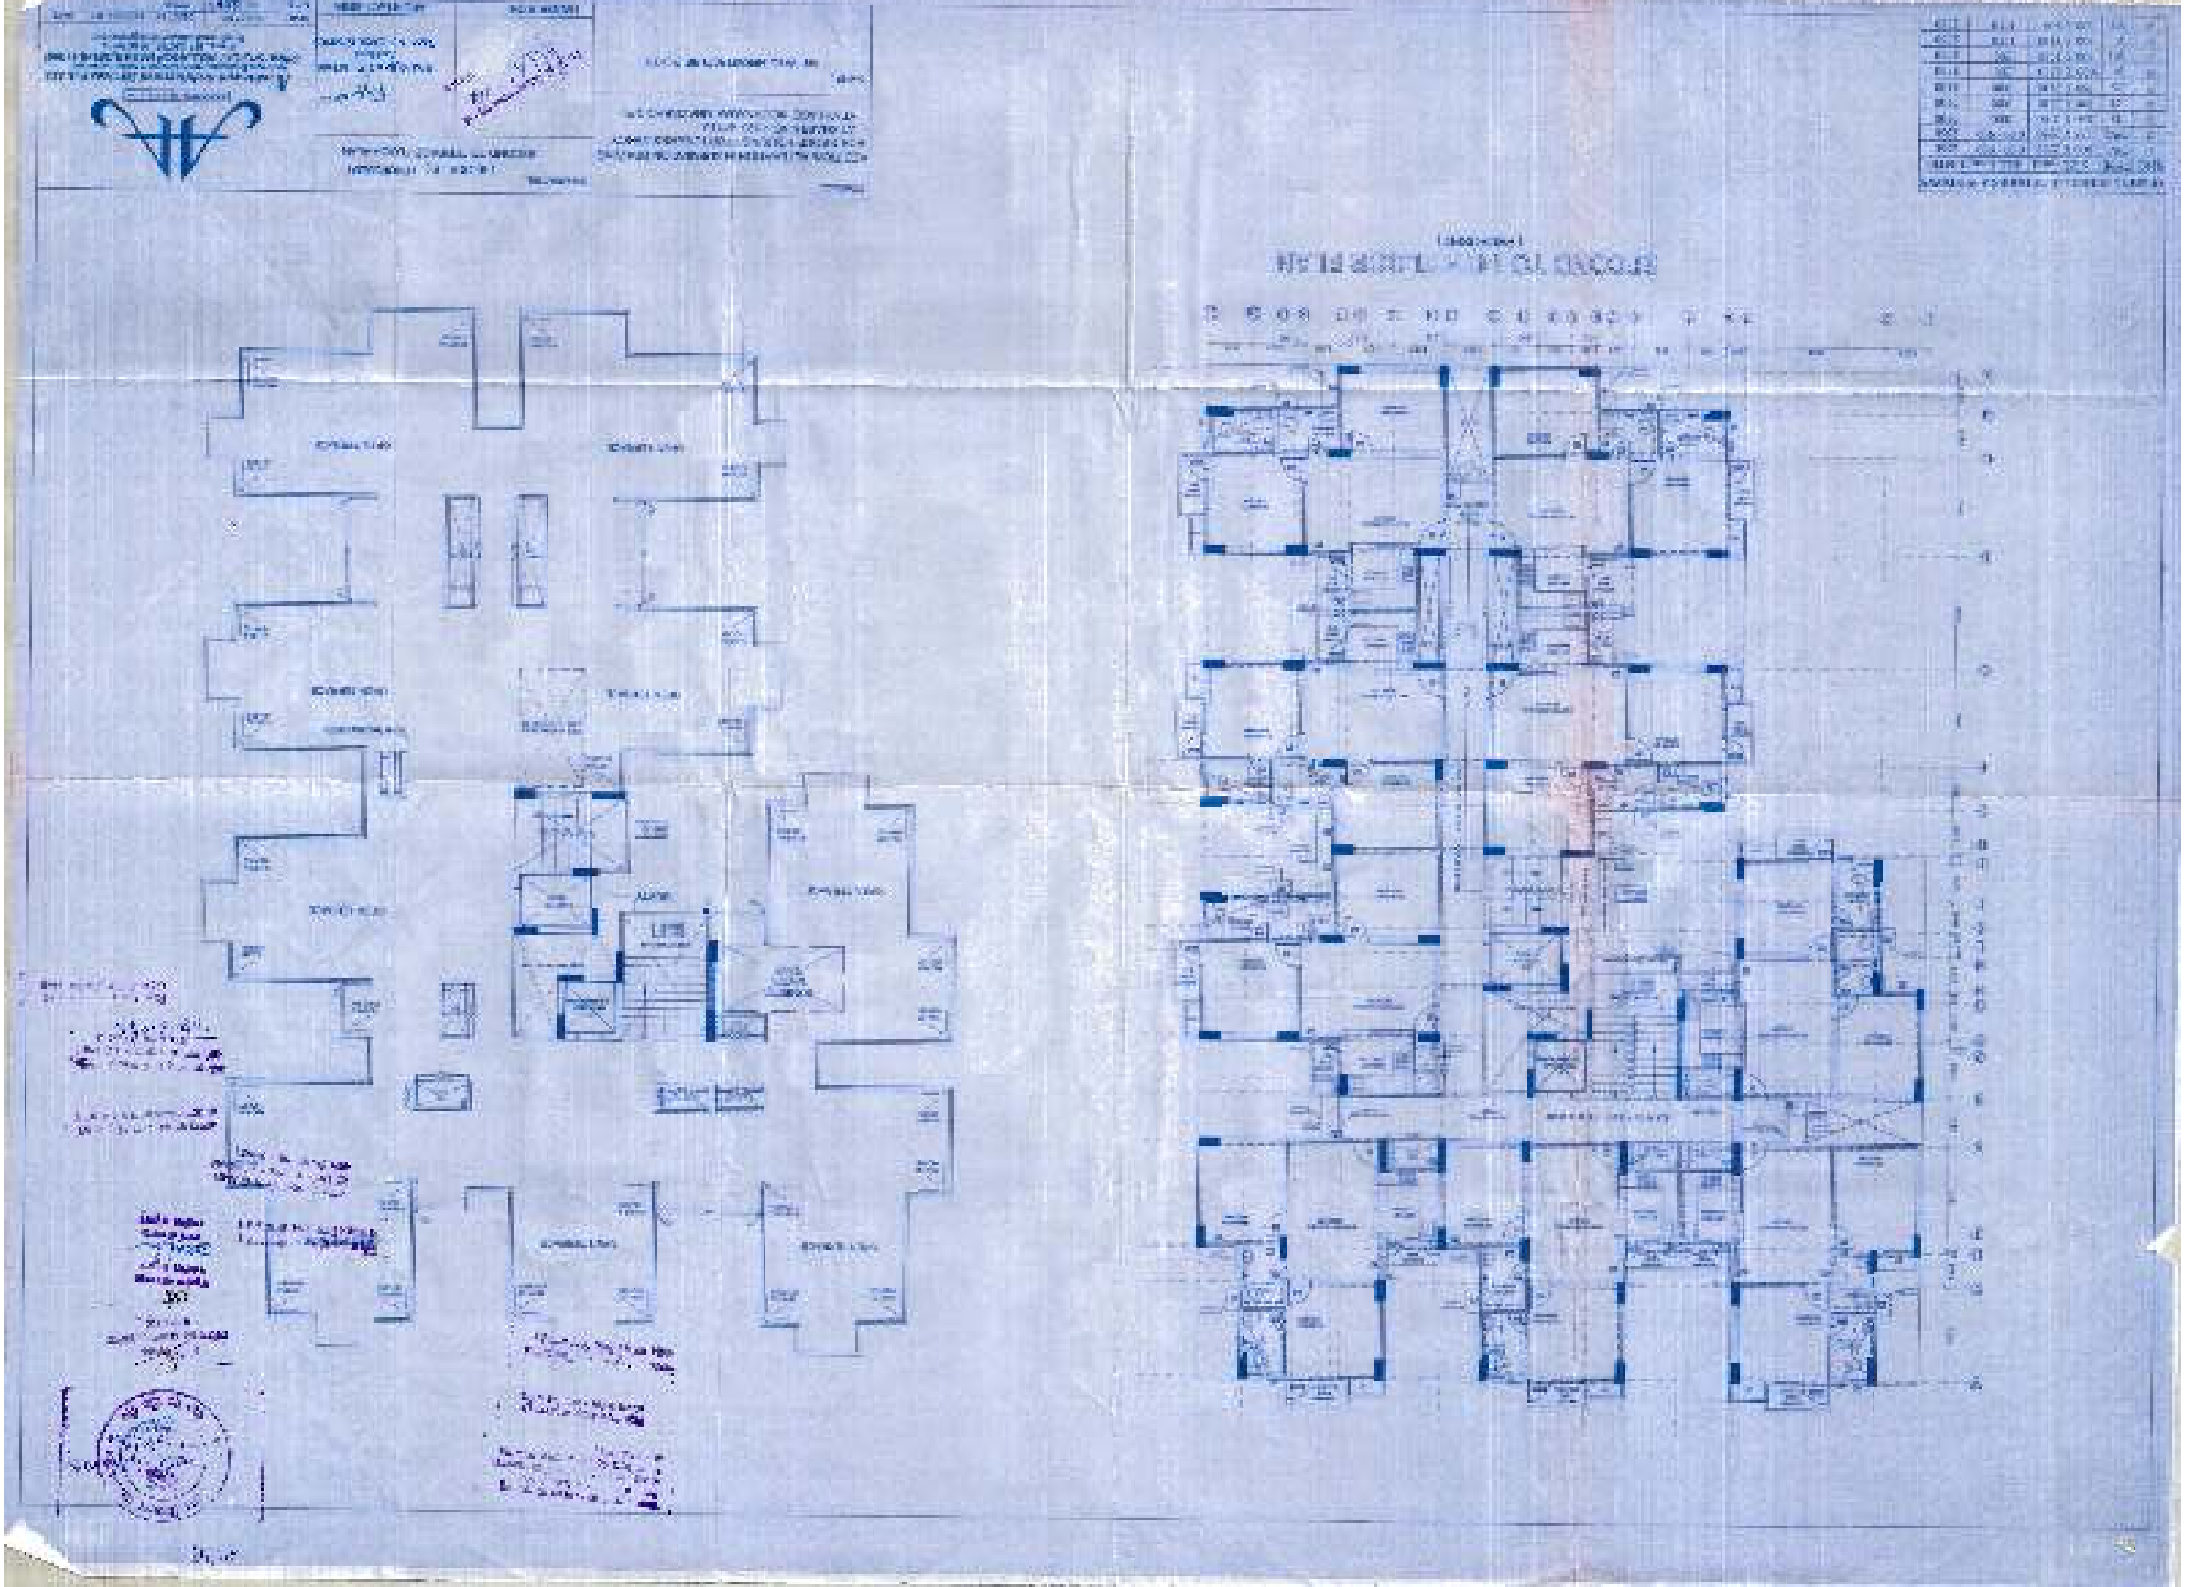

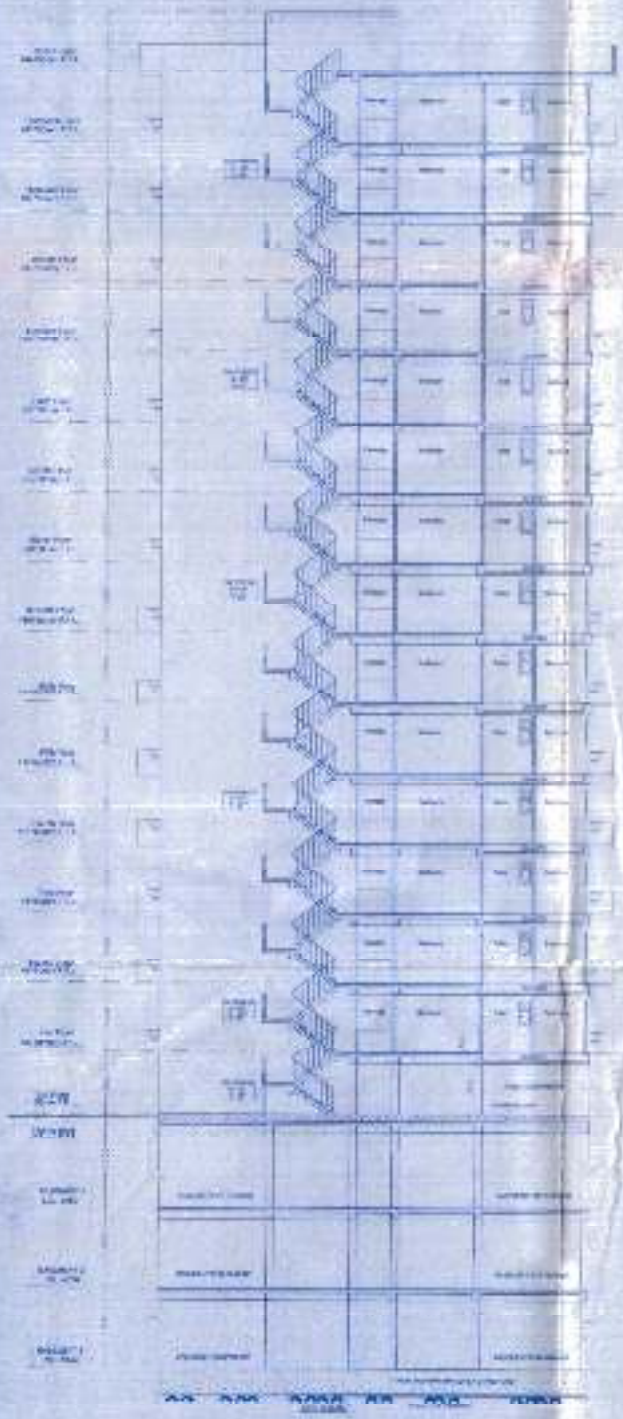

SECTION - A-A

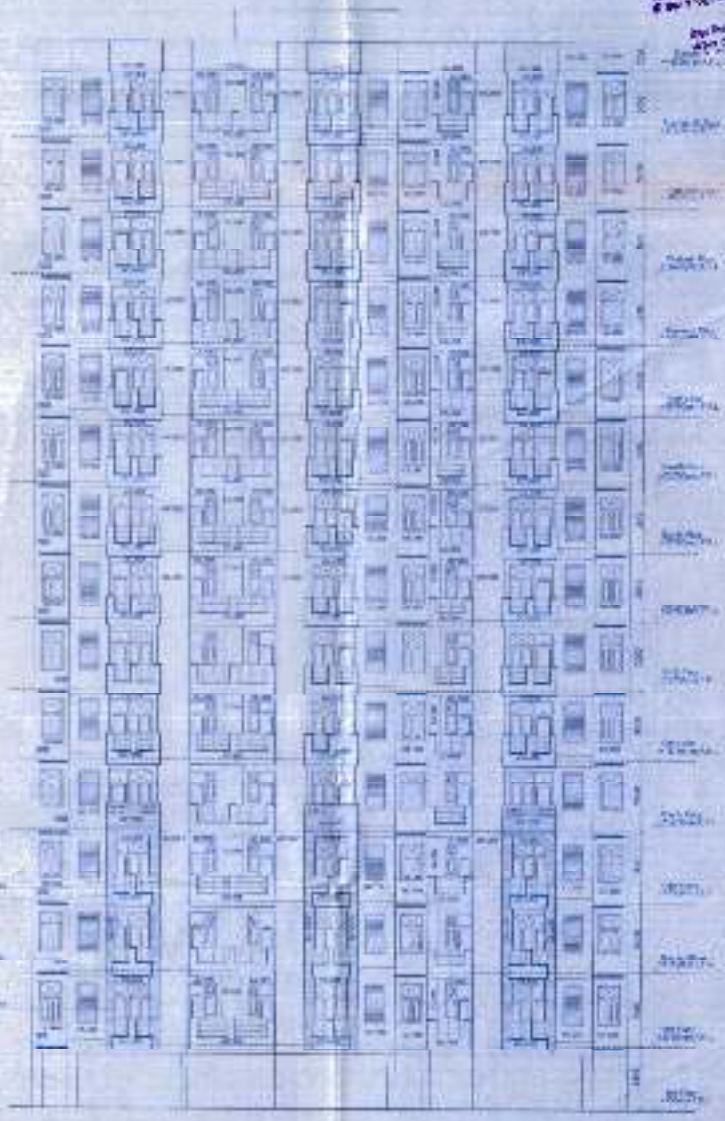

ELEVATION

PROJECT	OWNER:		DRAWING TITLE	
MULTI UNIT RESIDENTIAL ELEVATION IN SUBMISSION DRAWING FOR GROUP HOUSING - FORTUNE RESIDENCY [illegible] AT VILLAGE NOORNAGAR GHAZIABAD (UP)	M/s. VASU INFRASTRUCTURE PVT. LTD. AND OTHERS		ELEVATION & SECTION (BLOCK - E)	

AREA STATEMENT

S.No	FLOORS	AREA IN SQ.FT	UNITS
1	[illegible]		
	[illegible]		
	[illegible]		
	[illegible]		
2	FIRST FLOOR	[illegible]	12
3	SECOND FLOOR	[illegible]	11
4	THIRD FLOOR	[illegible]	12
5	FOURTH FLOOR	[illegible]	12
6	[illegible]	[illegible]	12
7	SIXTH FLOOR	[illegible]	11
8	SEVENTH FLOOR	[illegible]	12
9	EIGHTH FLOOR	[illegible]	12
10	NINTH FLOOR	[illegible]	12
	TOTAL	[illegible]	92

TYPE -C1

TYPE -C

TYPE -A

TYPE -B

TYPE -C2

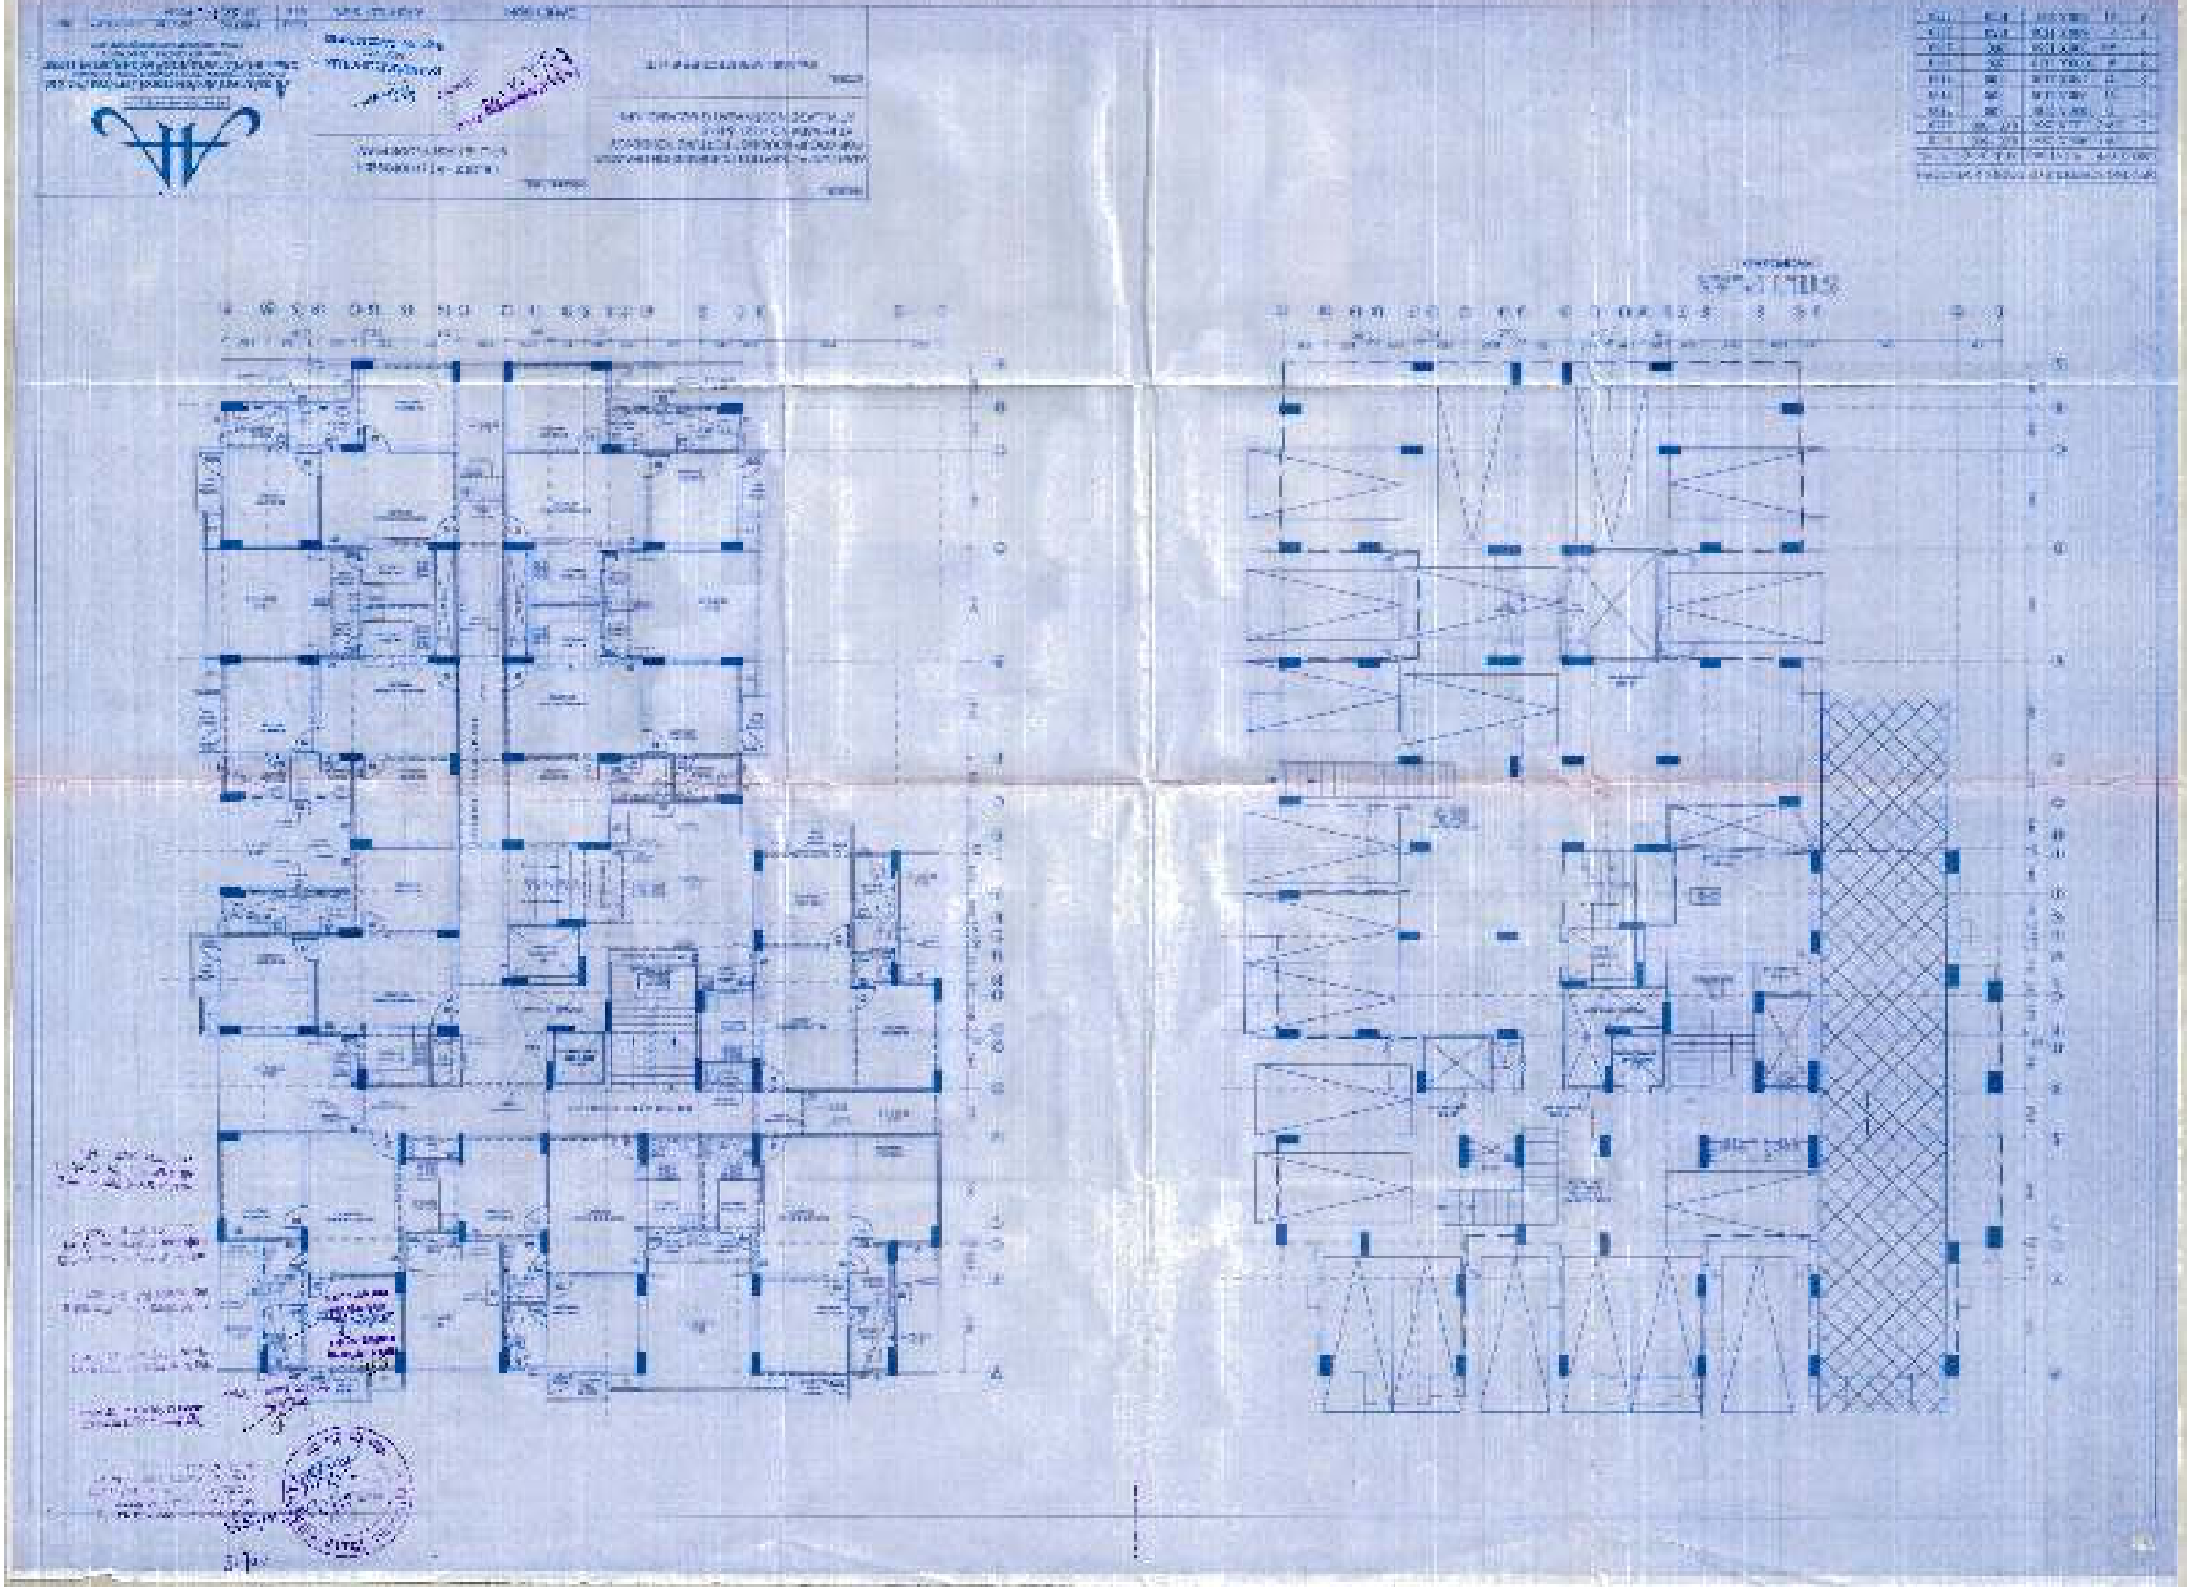

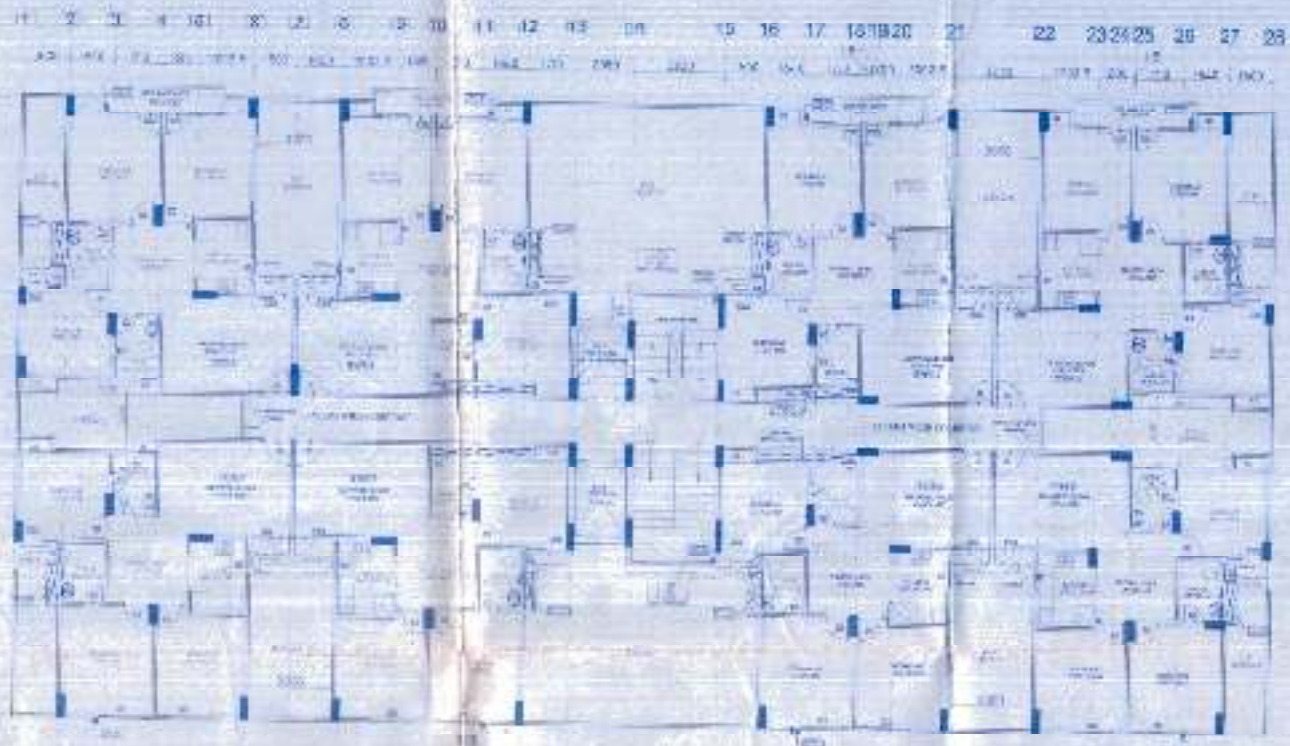

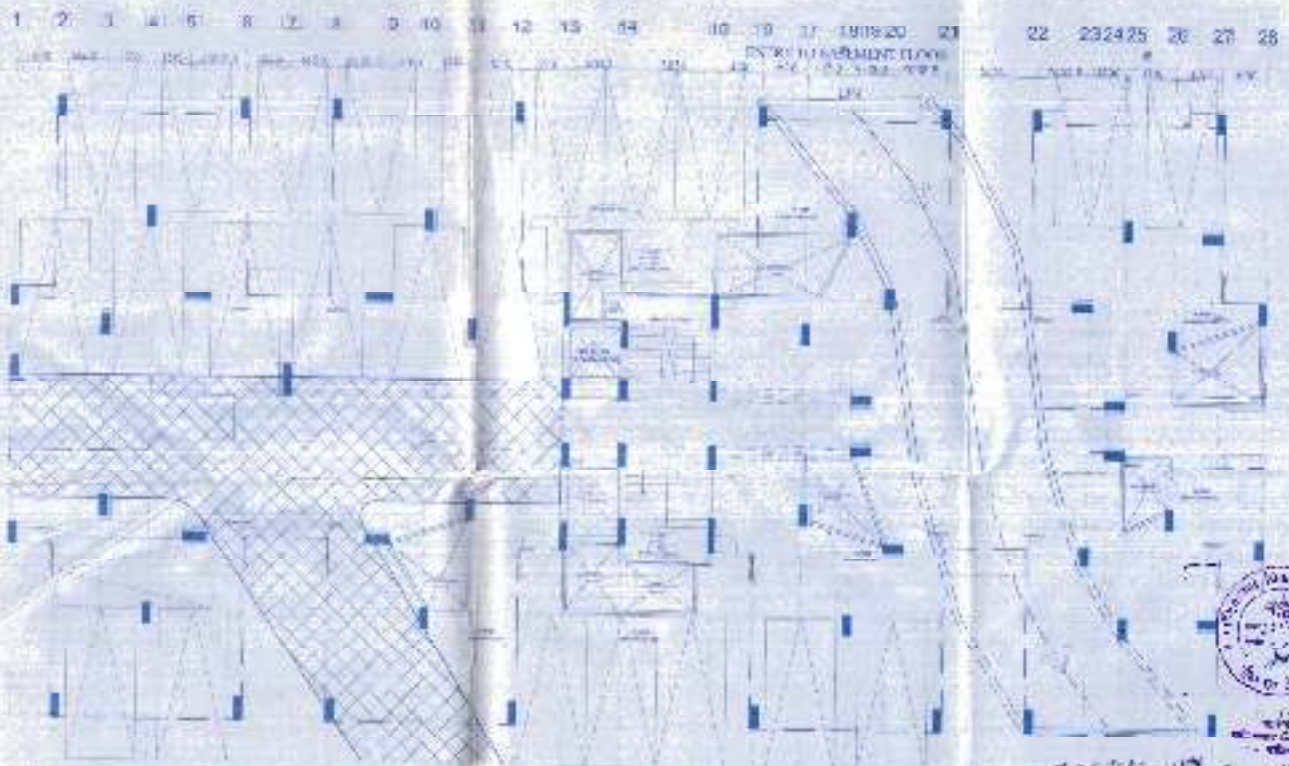

DOOR SCHEDULE OF GROUND FLOOR				
DOOR TYPE				

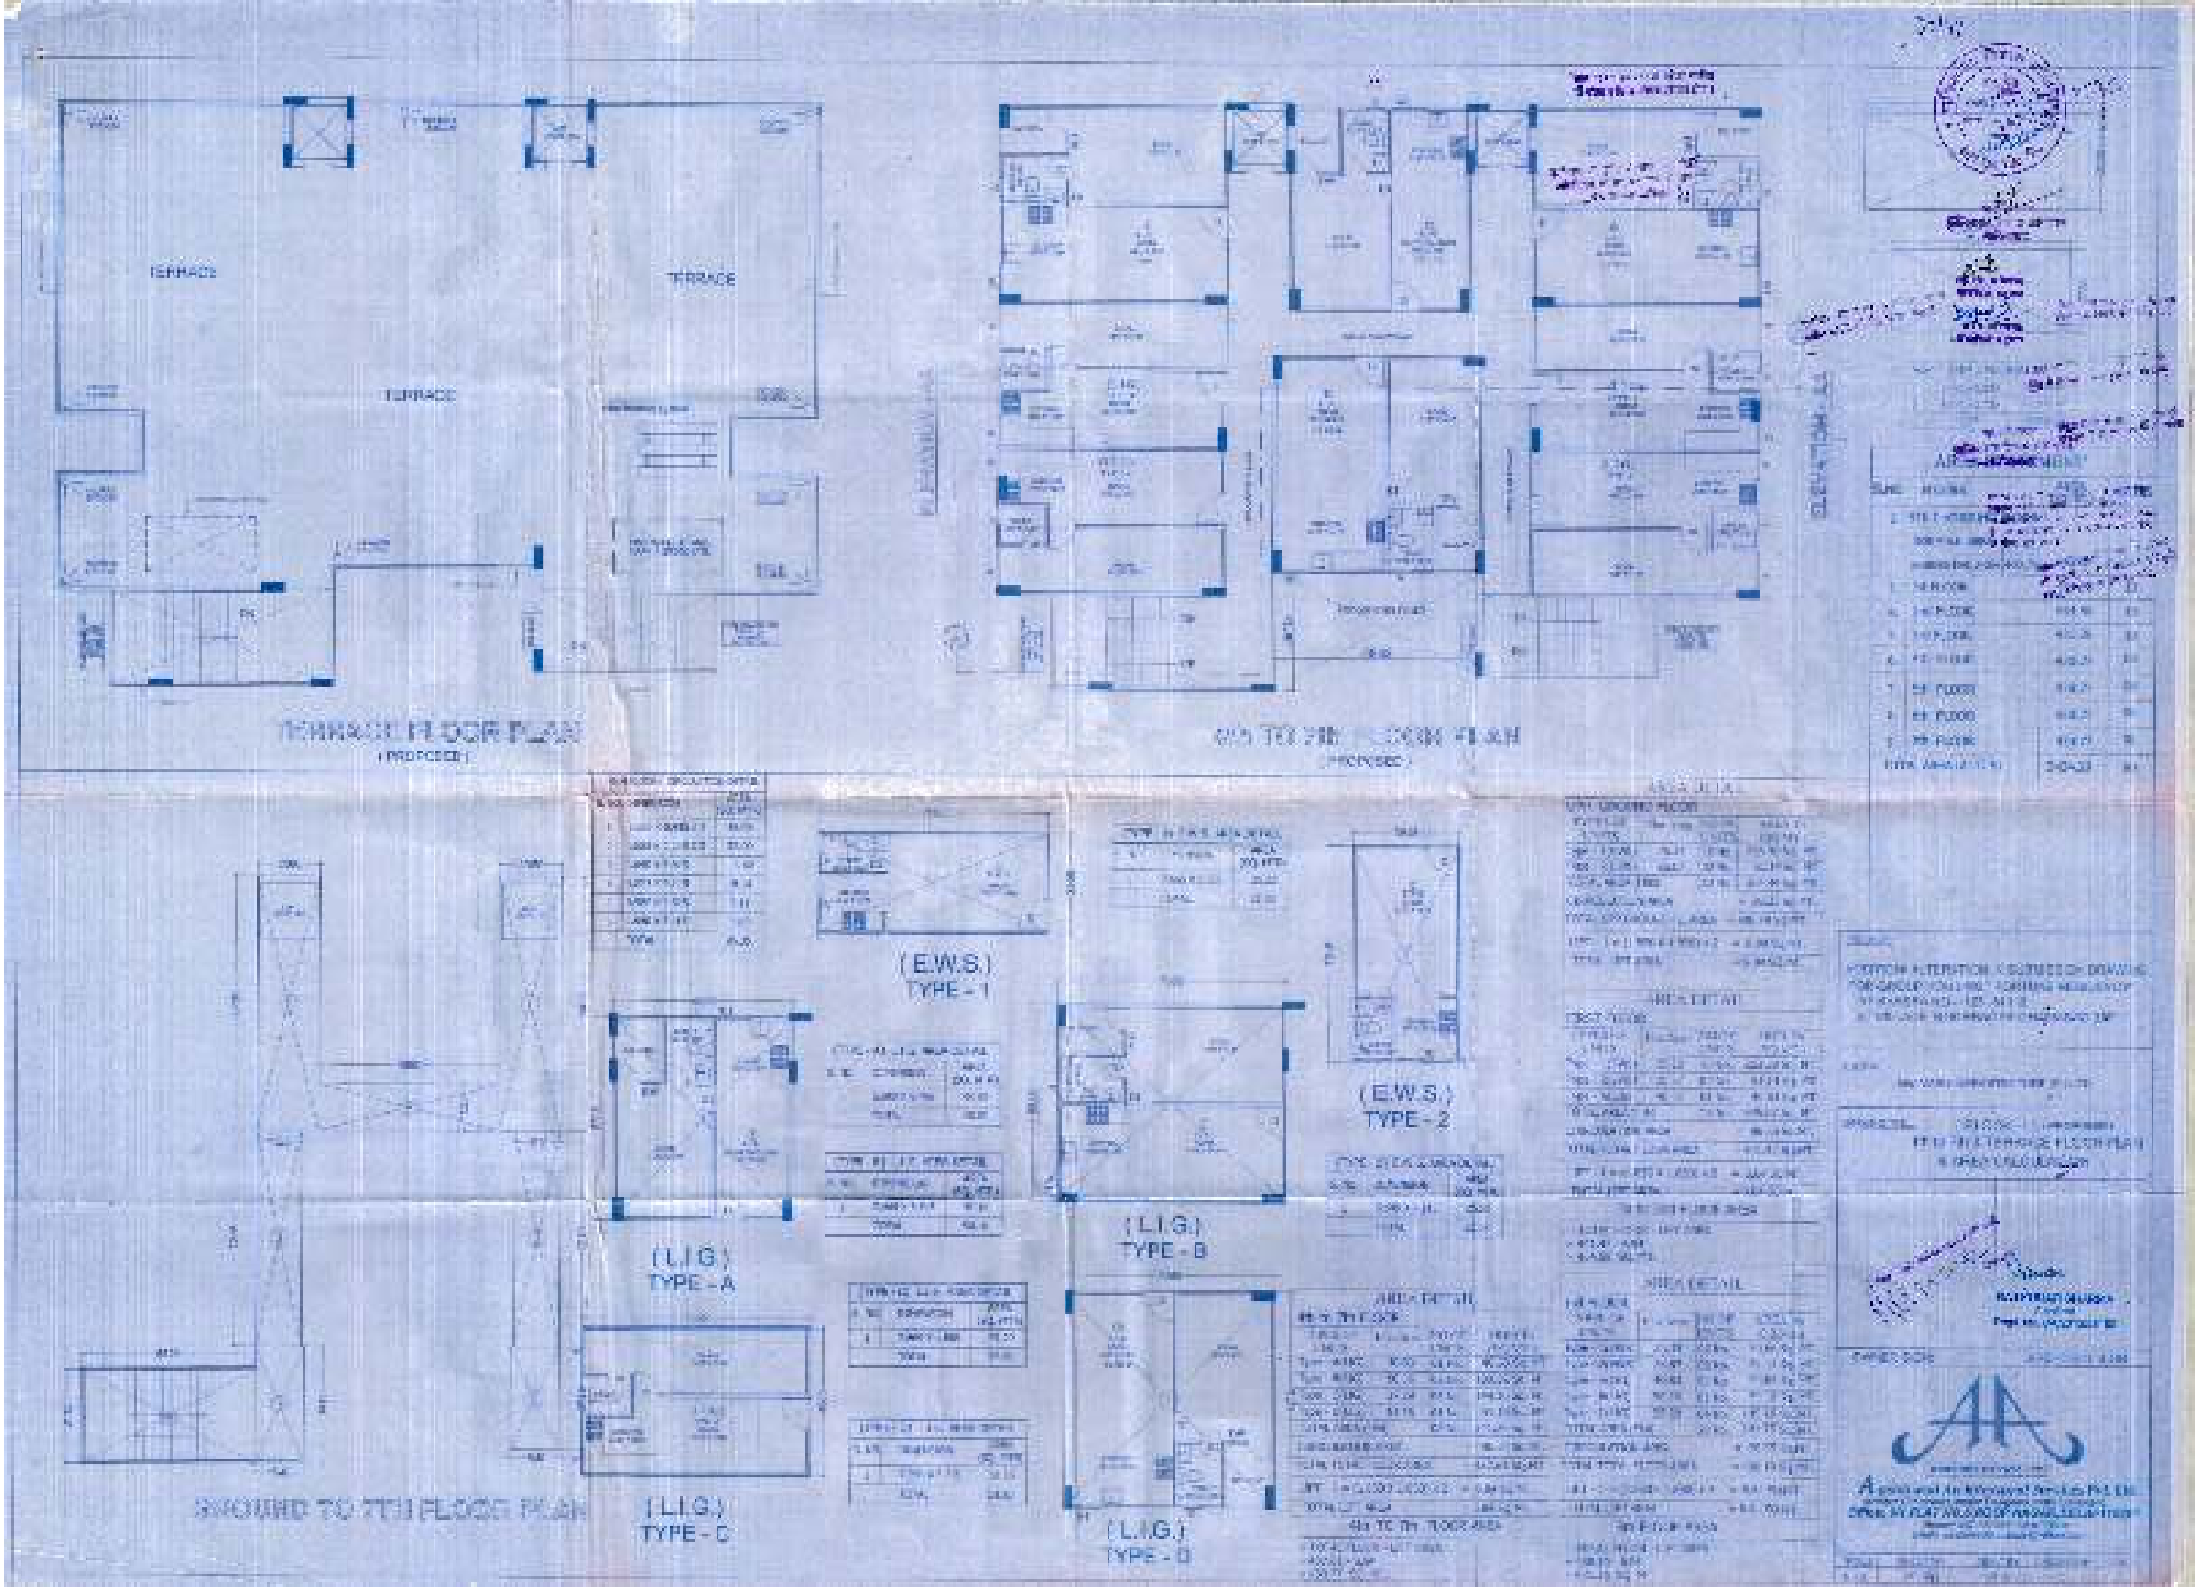
TERRACE
TERRACE
TERRACE
TERRACE FLOOR PLAN
(PROPOSED)
(E.W.S.)
TYPE - 1
(E.W.S.)
TYPE - 2
(L.I.G.)
TYPE - A
(L.I.G.)
TYPE - B
(L.I.G.)
TYPE - C
(L.I.G.)
TYPE - D

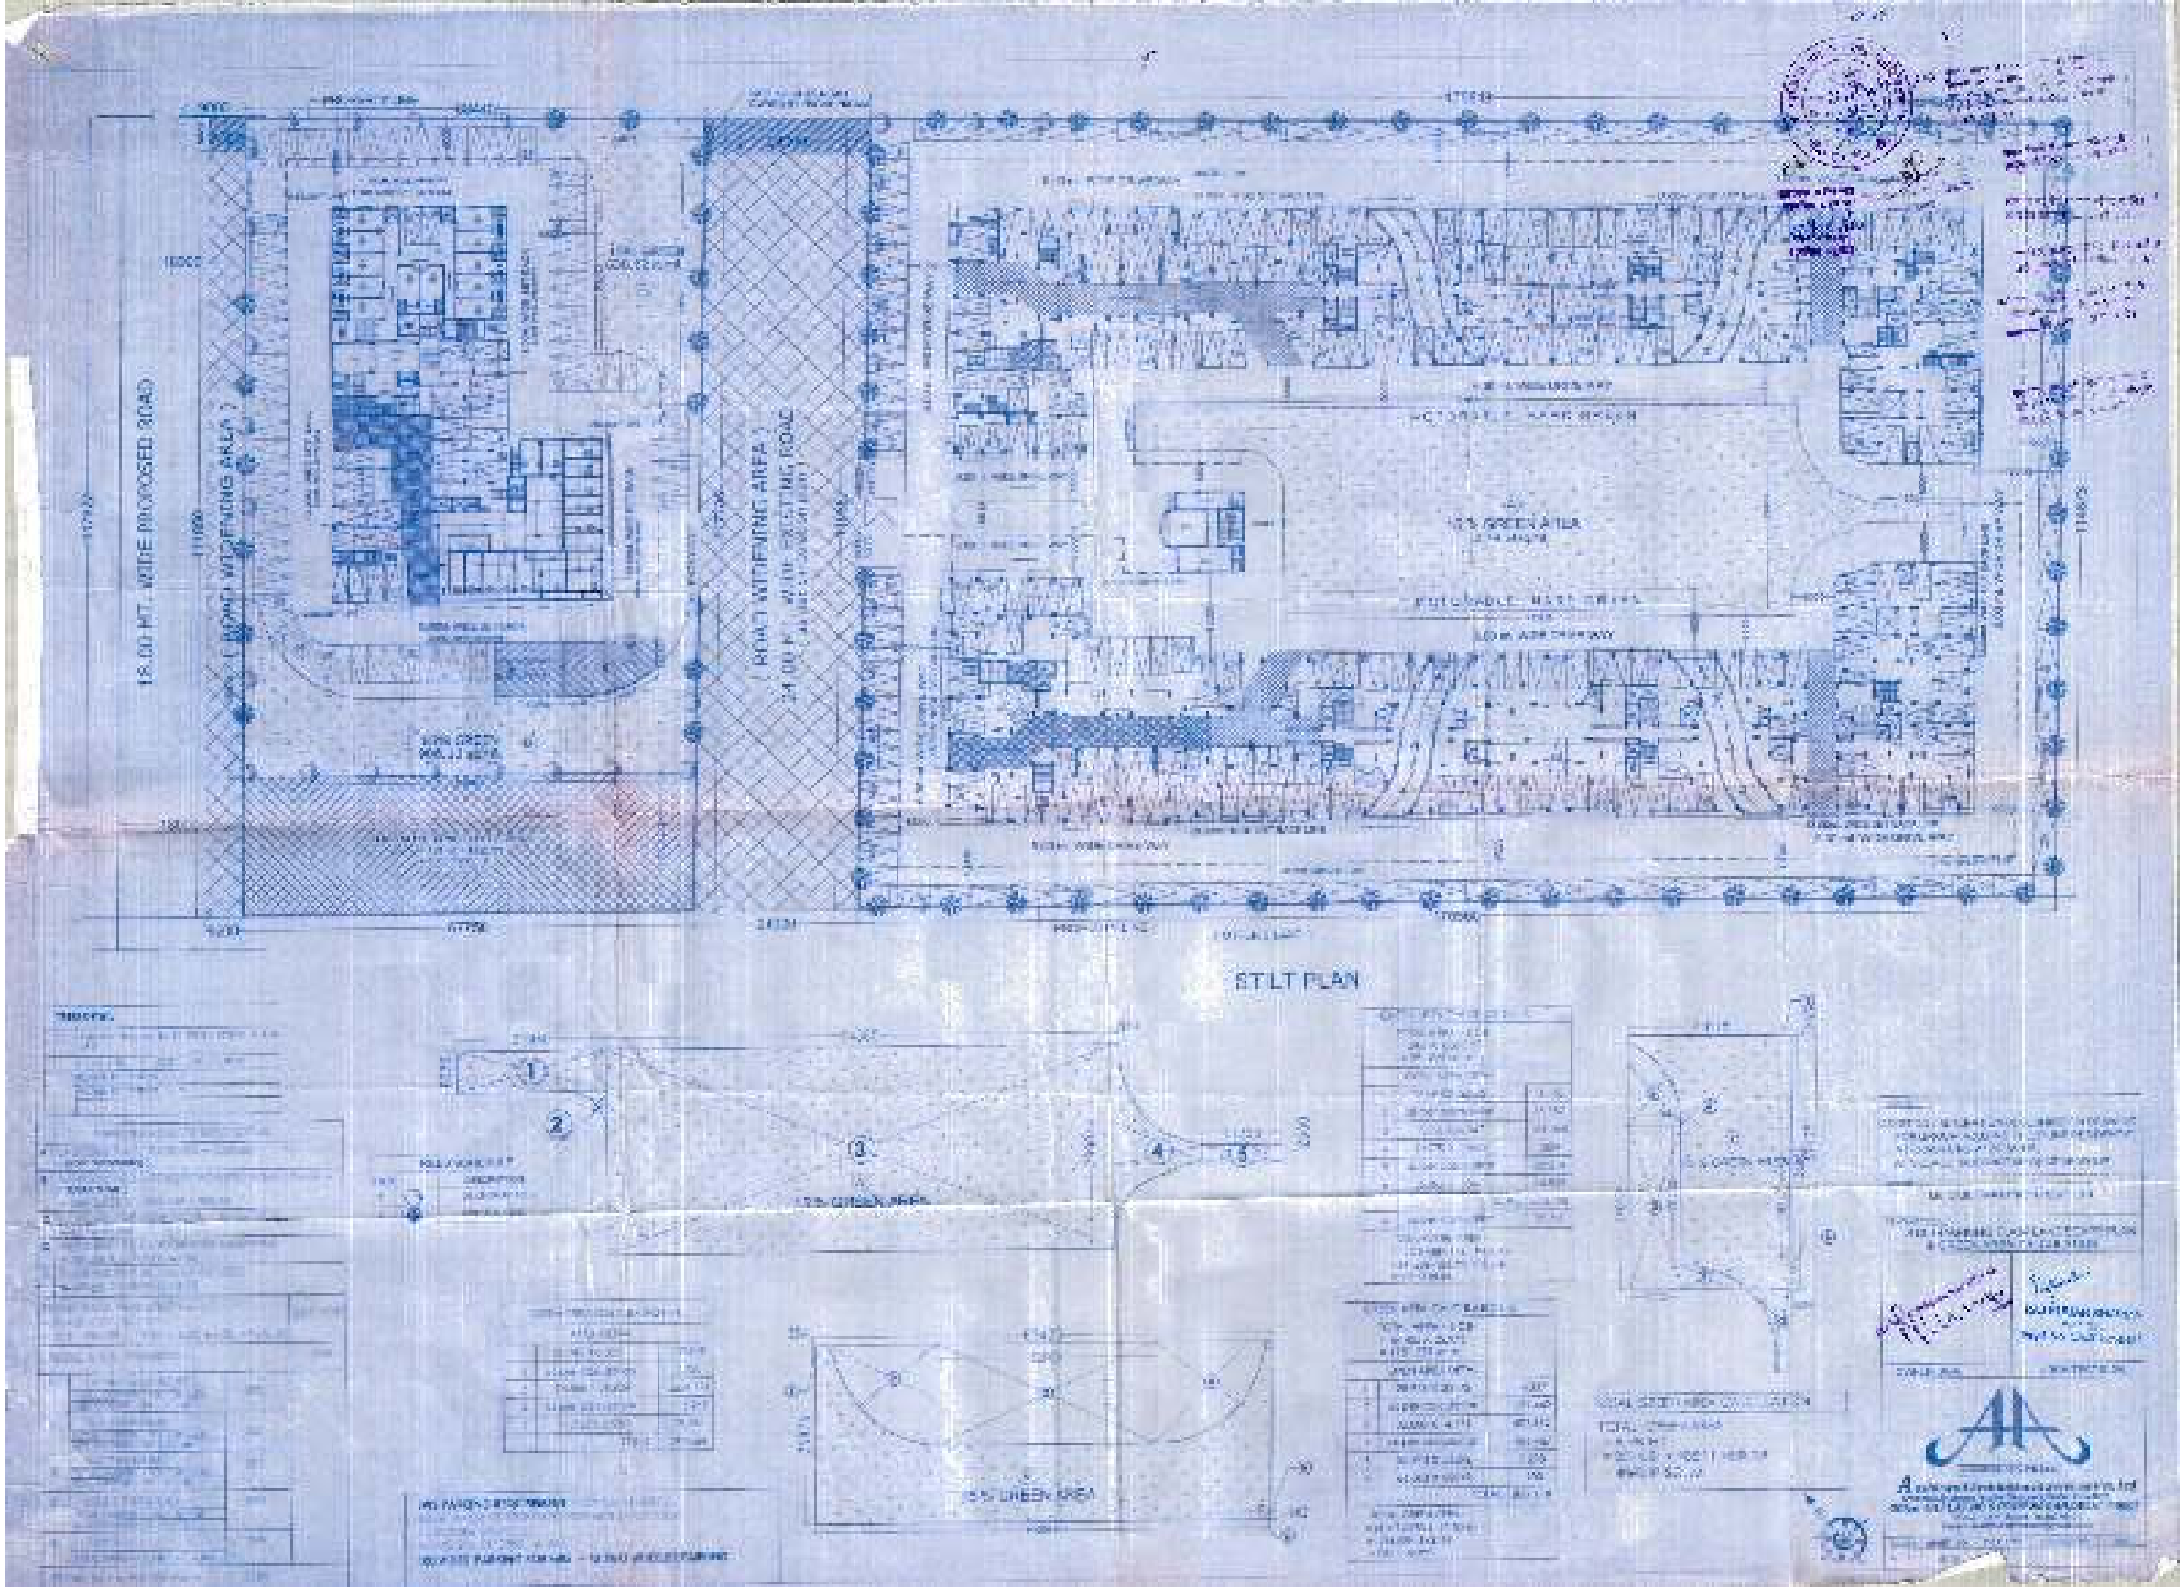
18.00 MT. WIDE PROPOSED ROAD
(ROAD WIDENING AREA)
(ROAD WIDENING AREA)
24.00 M. WIDE EXISTING ROAD
STILT PLAN

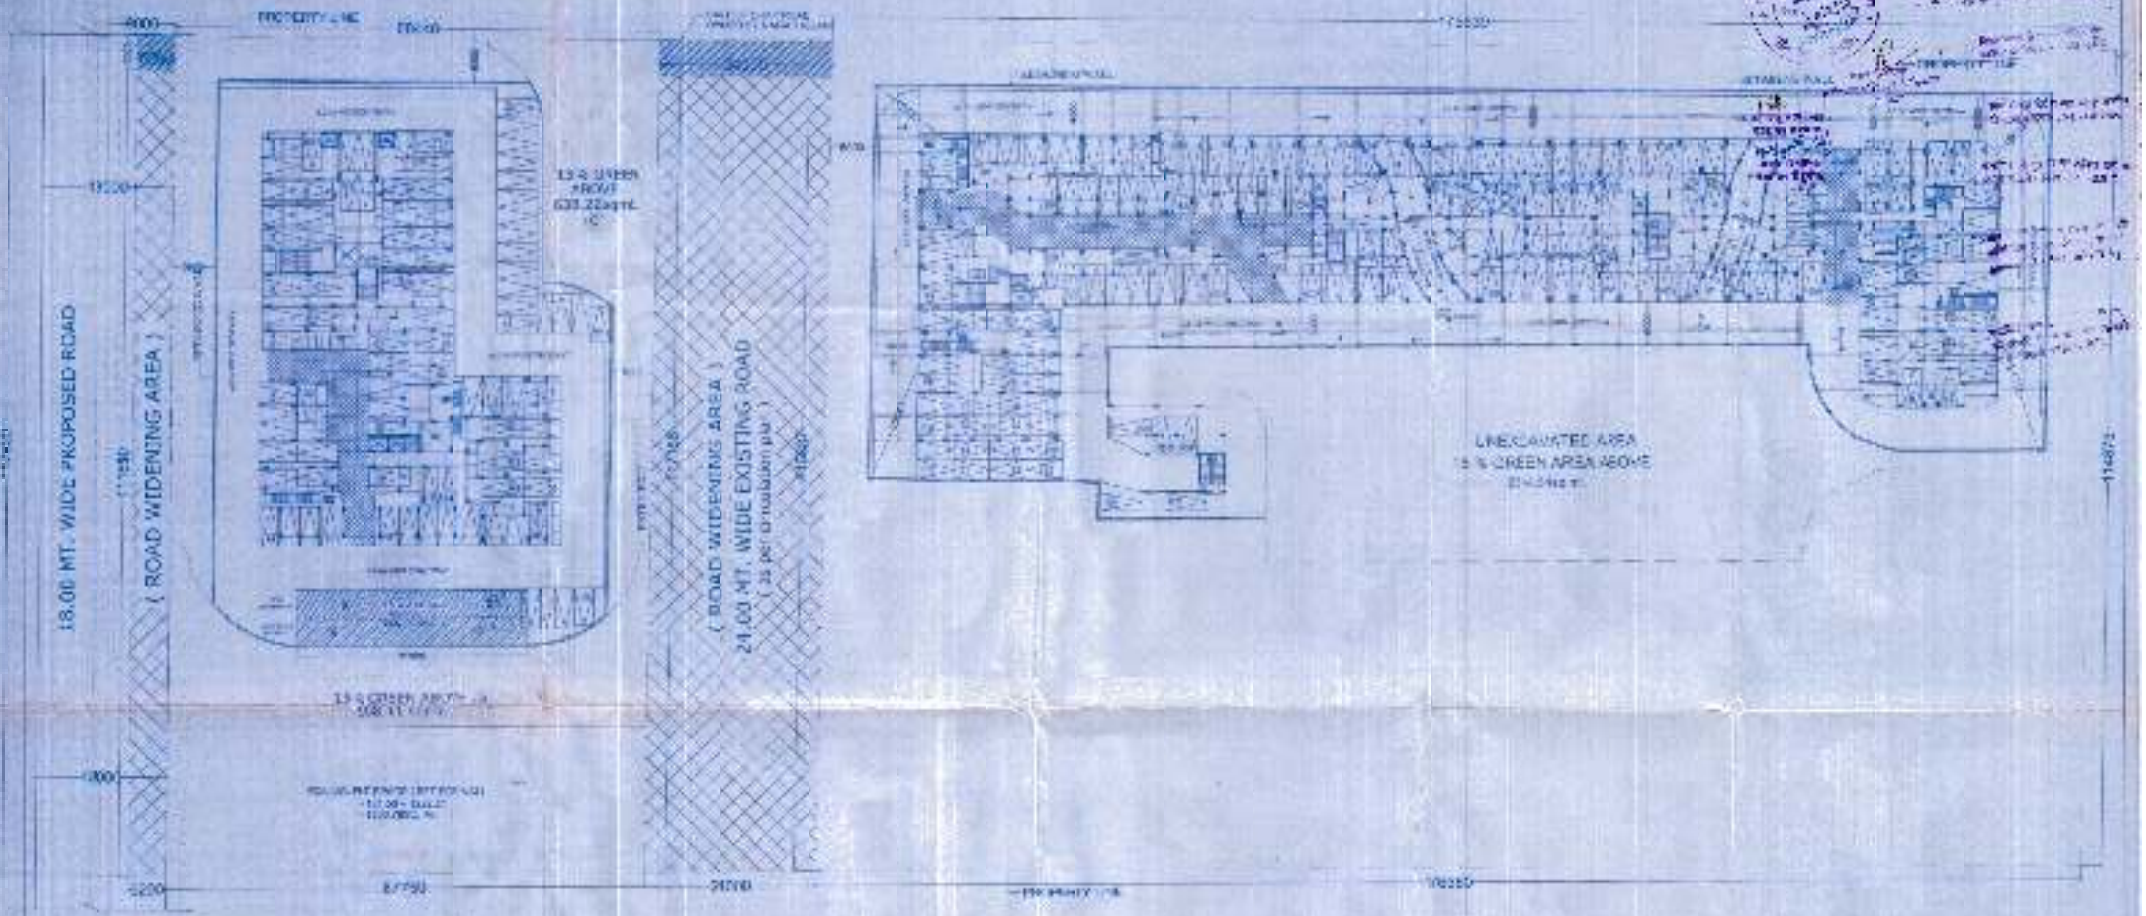

THIRD BASEMENT FLOOR PLAN

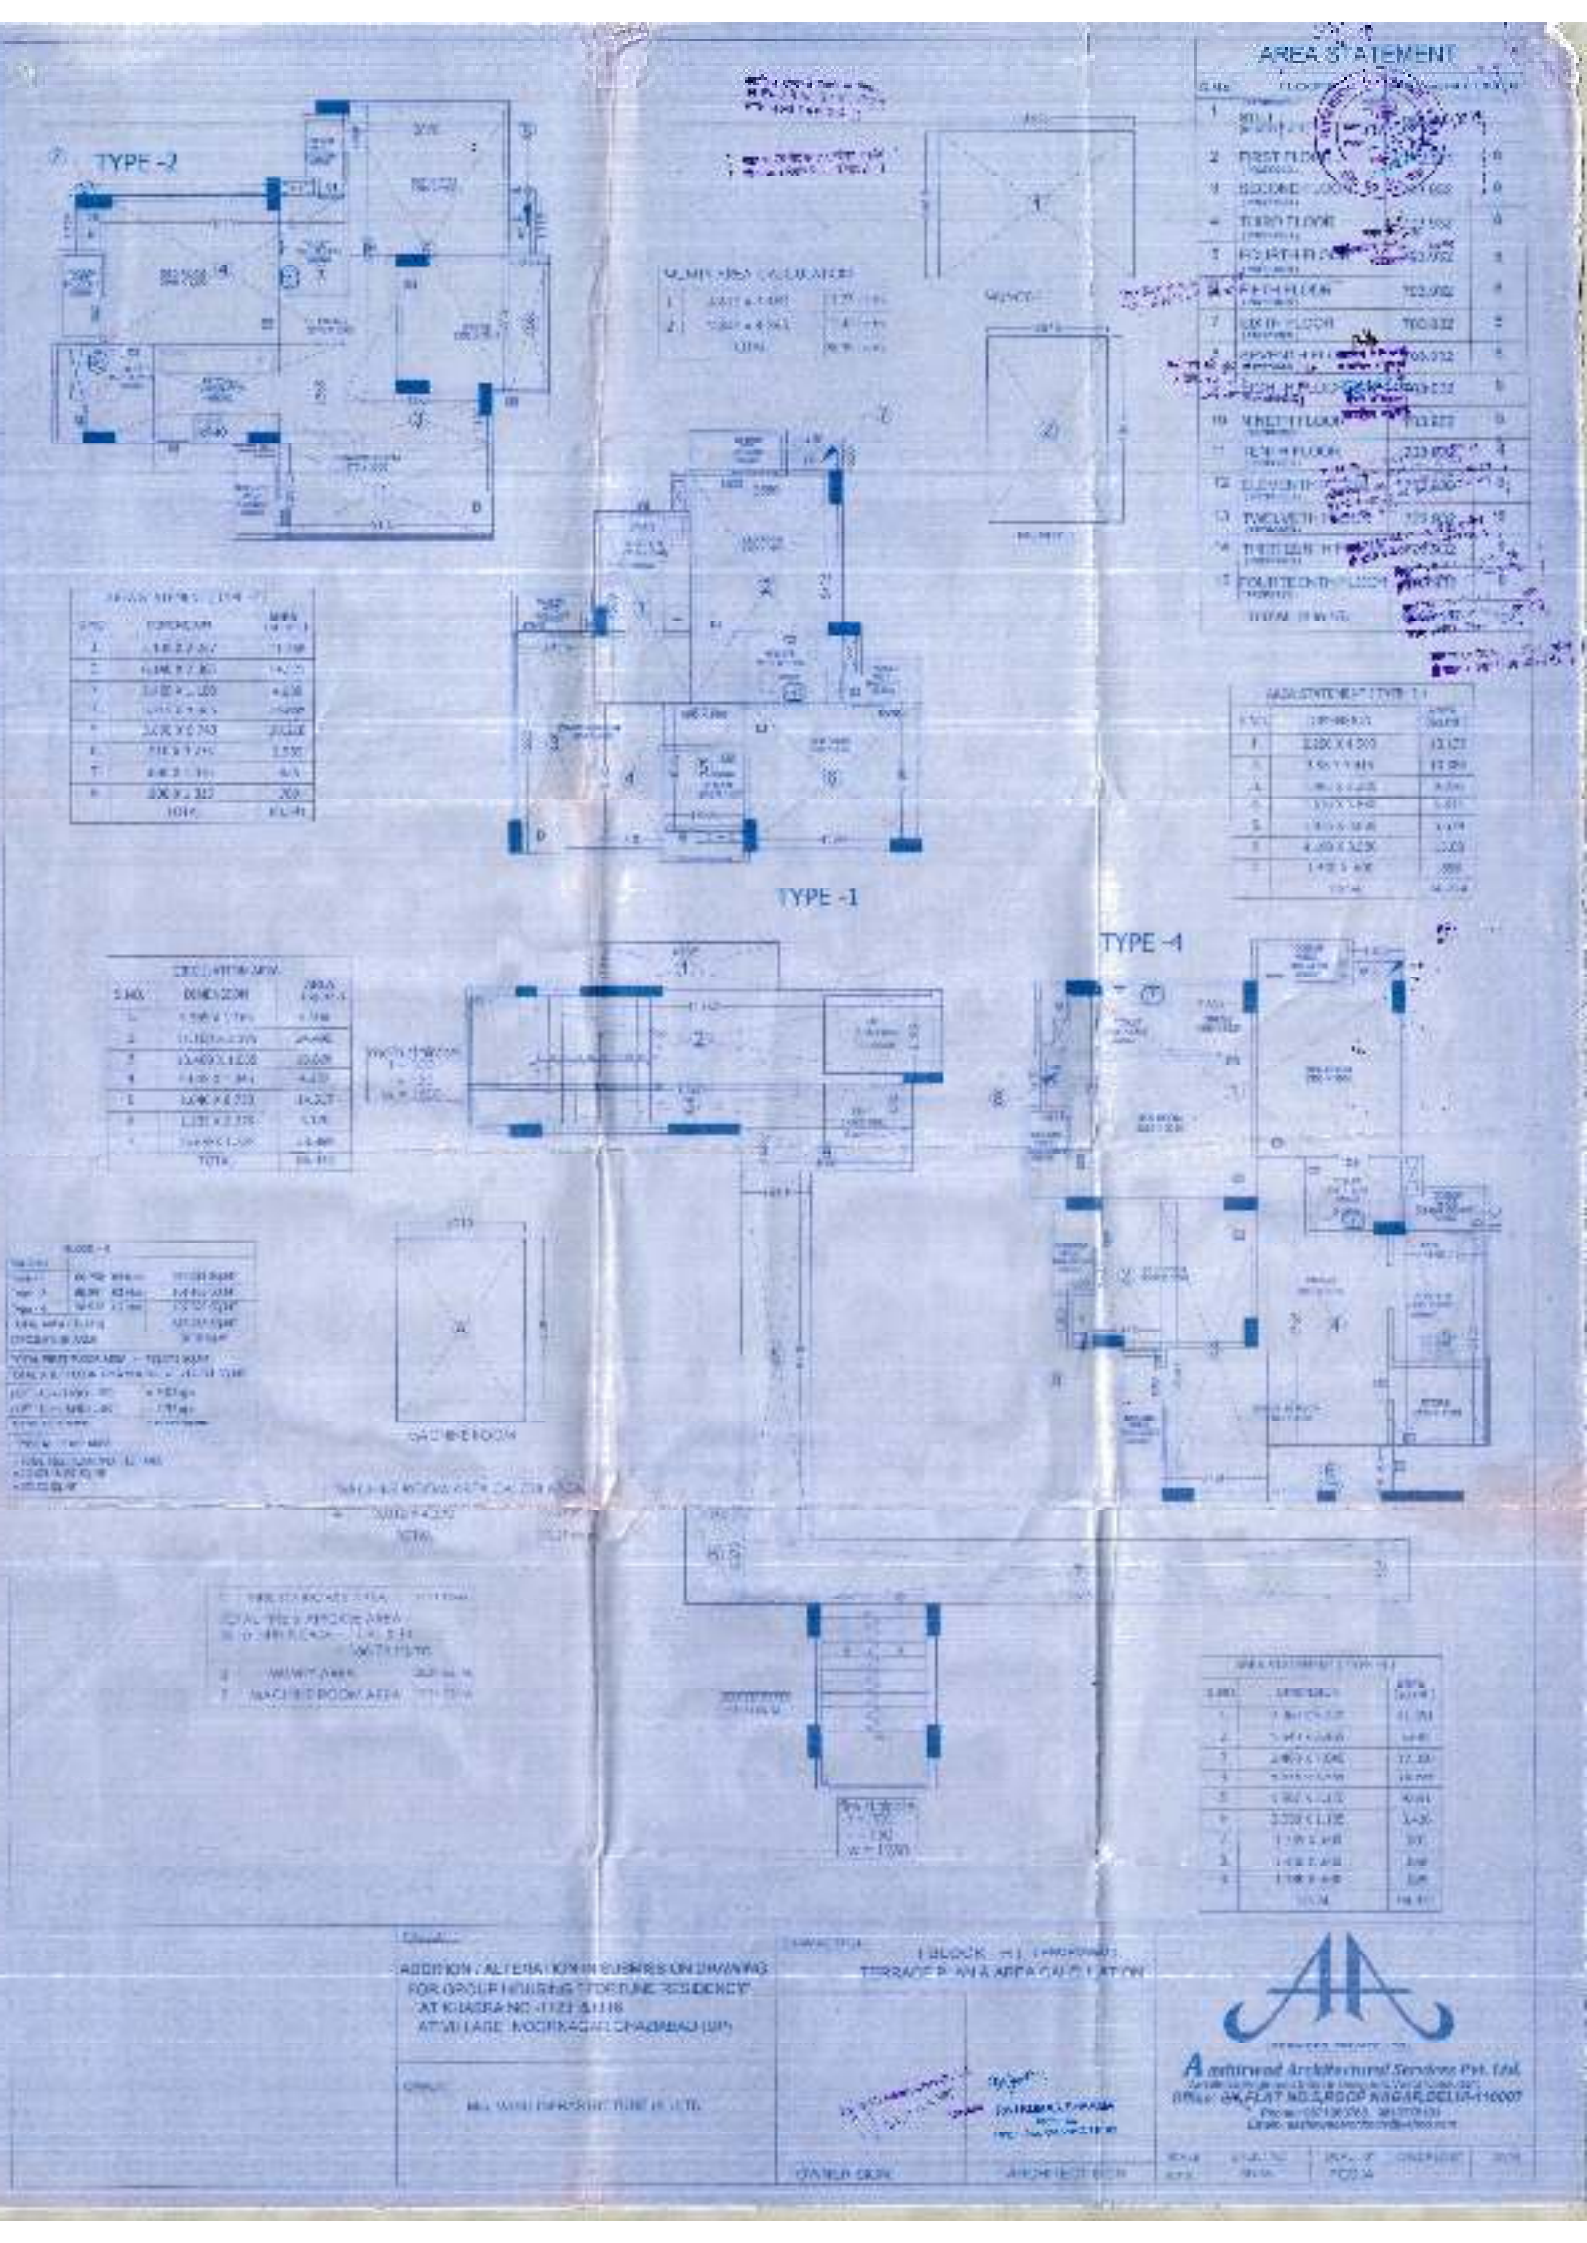
AREA STATEMENT
TYPE -2
TYPE -1
TYPE -4
MACHINE ROOM
TERRACE PLAN & AREA CALCULATION
ADDITION / ALTERATION IN SUBMISSION DRAWING
FOR GROUP HOUSING "FORTUNE RESIDENCY"
AT KHASRA NO. 1122 & 1118
AT VILLAGE NOORNAGAR, GHAZIABAD (UP)
OWNER SIGN
ARCHITECT SIGN
Authorised Architectural Services Pvt. Ltd.

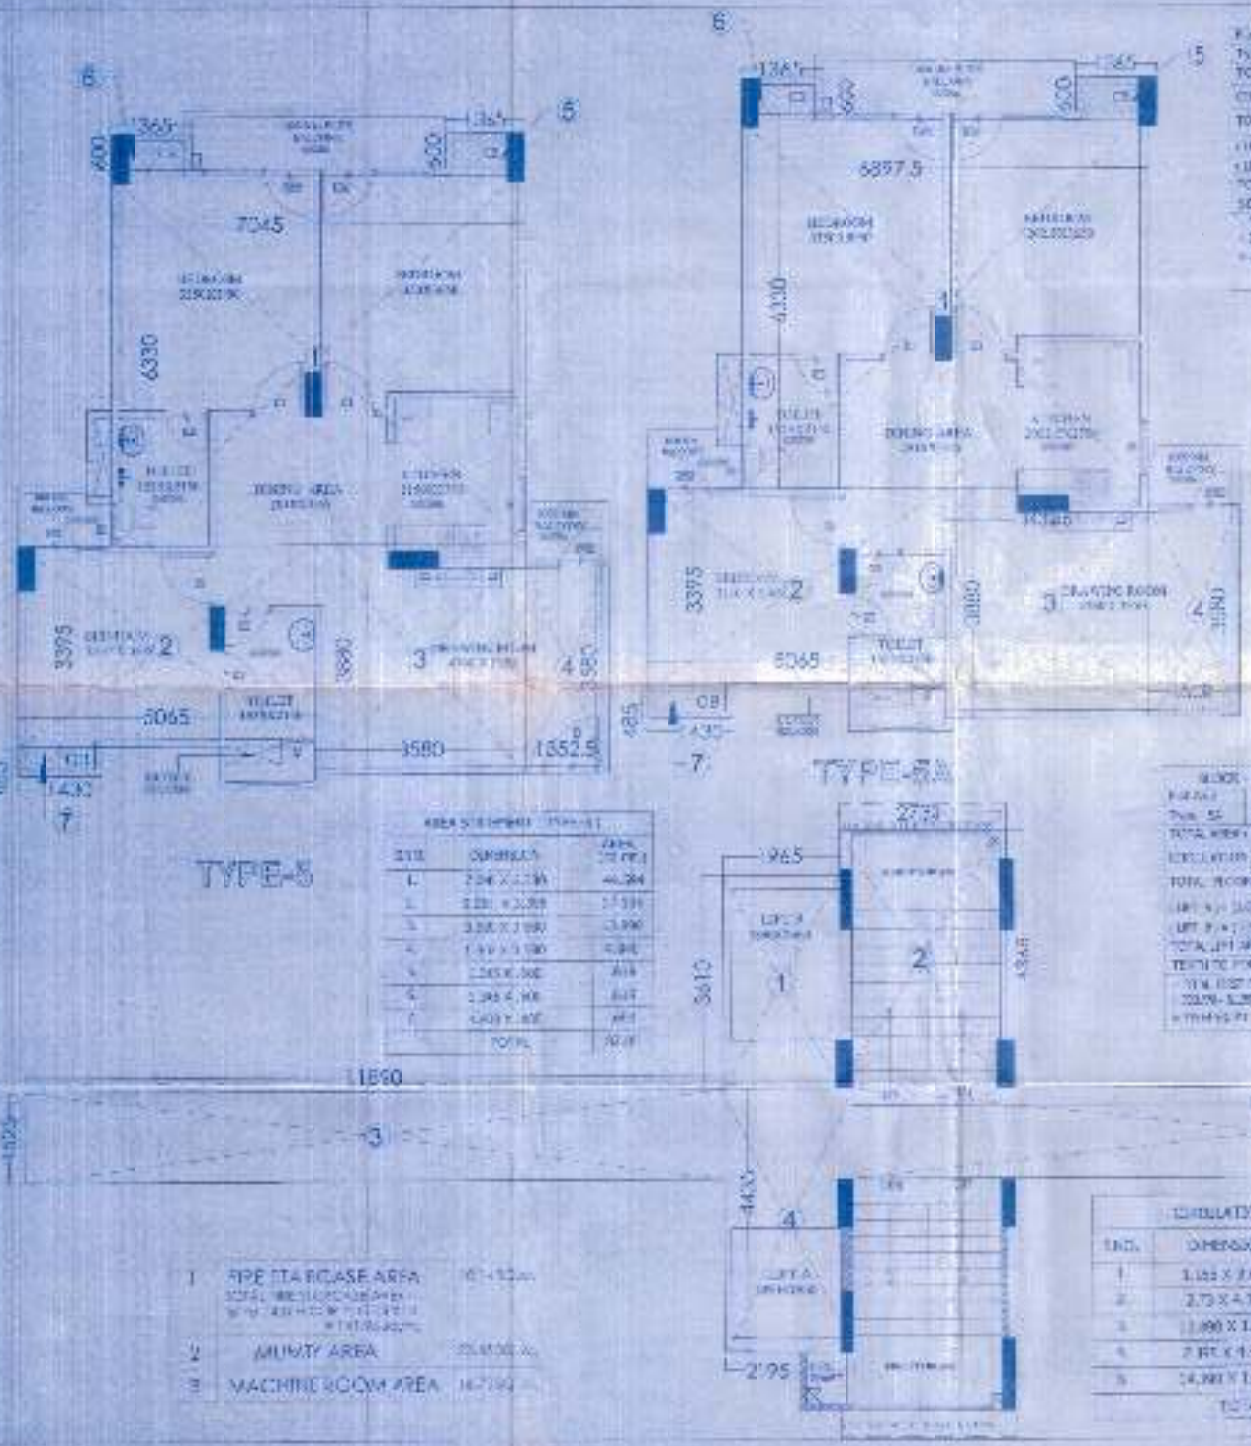

AREA STATEMENT

S.No	FLOORS		
1	STILT		
2	FIRST FLOOR		B
3	SECOND FLOOR		B
4	THIRD FLOOR		B
5	FOURTH FLOOR		B
6	FIFTH FLOOR		B
7	SIXTH FLOOR		B
8	SEVENTH FLOOR		B
9	EIGHTH FLOOR		B
10	NINTH FLOOR		B
11	TENTH FLOOR		B
12	ELEVENTH FLOOR		B
13	TWELVETH FLOOR		B
14	THIRTEENTH FLOOR		B
15	FOURTEENTH FLOOR		B
	TOTAL (1 to 15)		

2	MUNITY AREA	
3	MACHINE ROOM AREA	

S.NO.	DIMENSION	AREA SQ.MT
1		
2		
3		
4		
5		
	TOTAL	

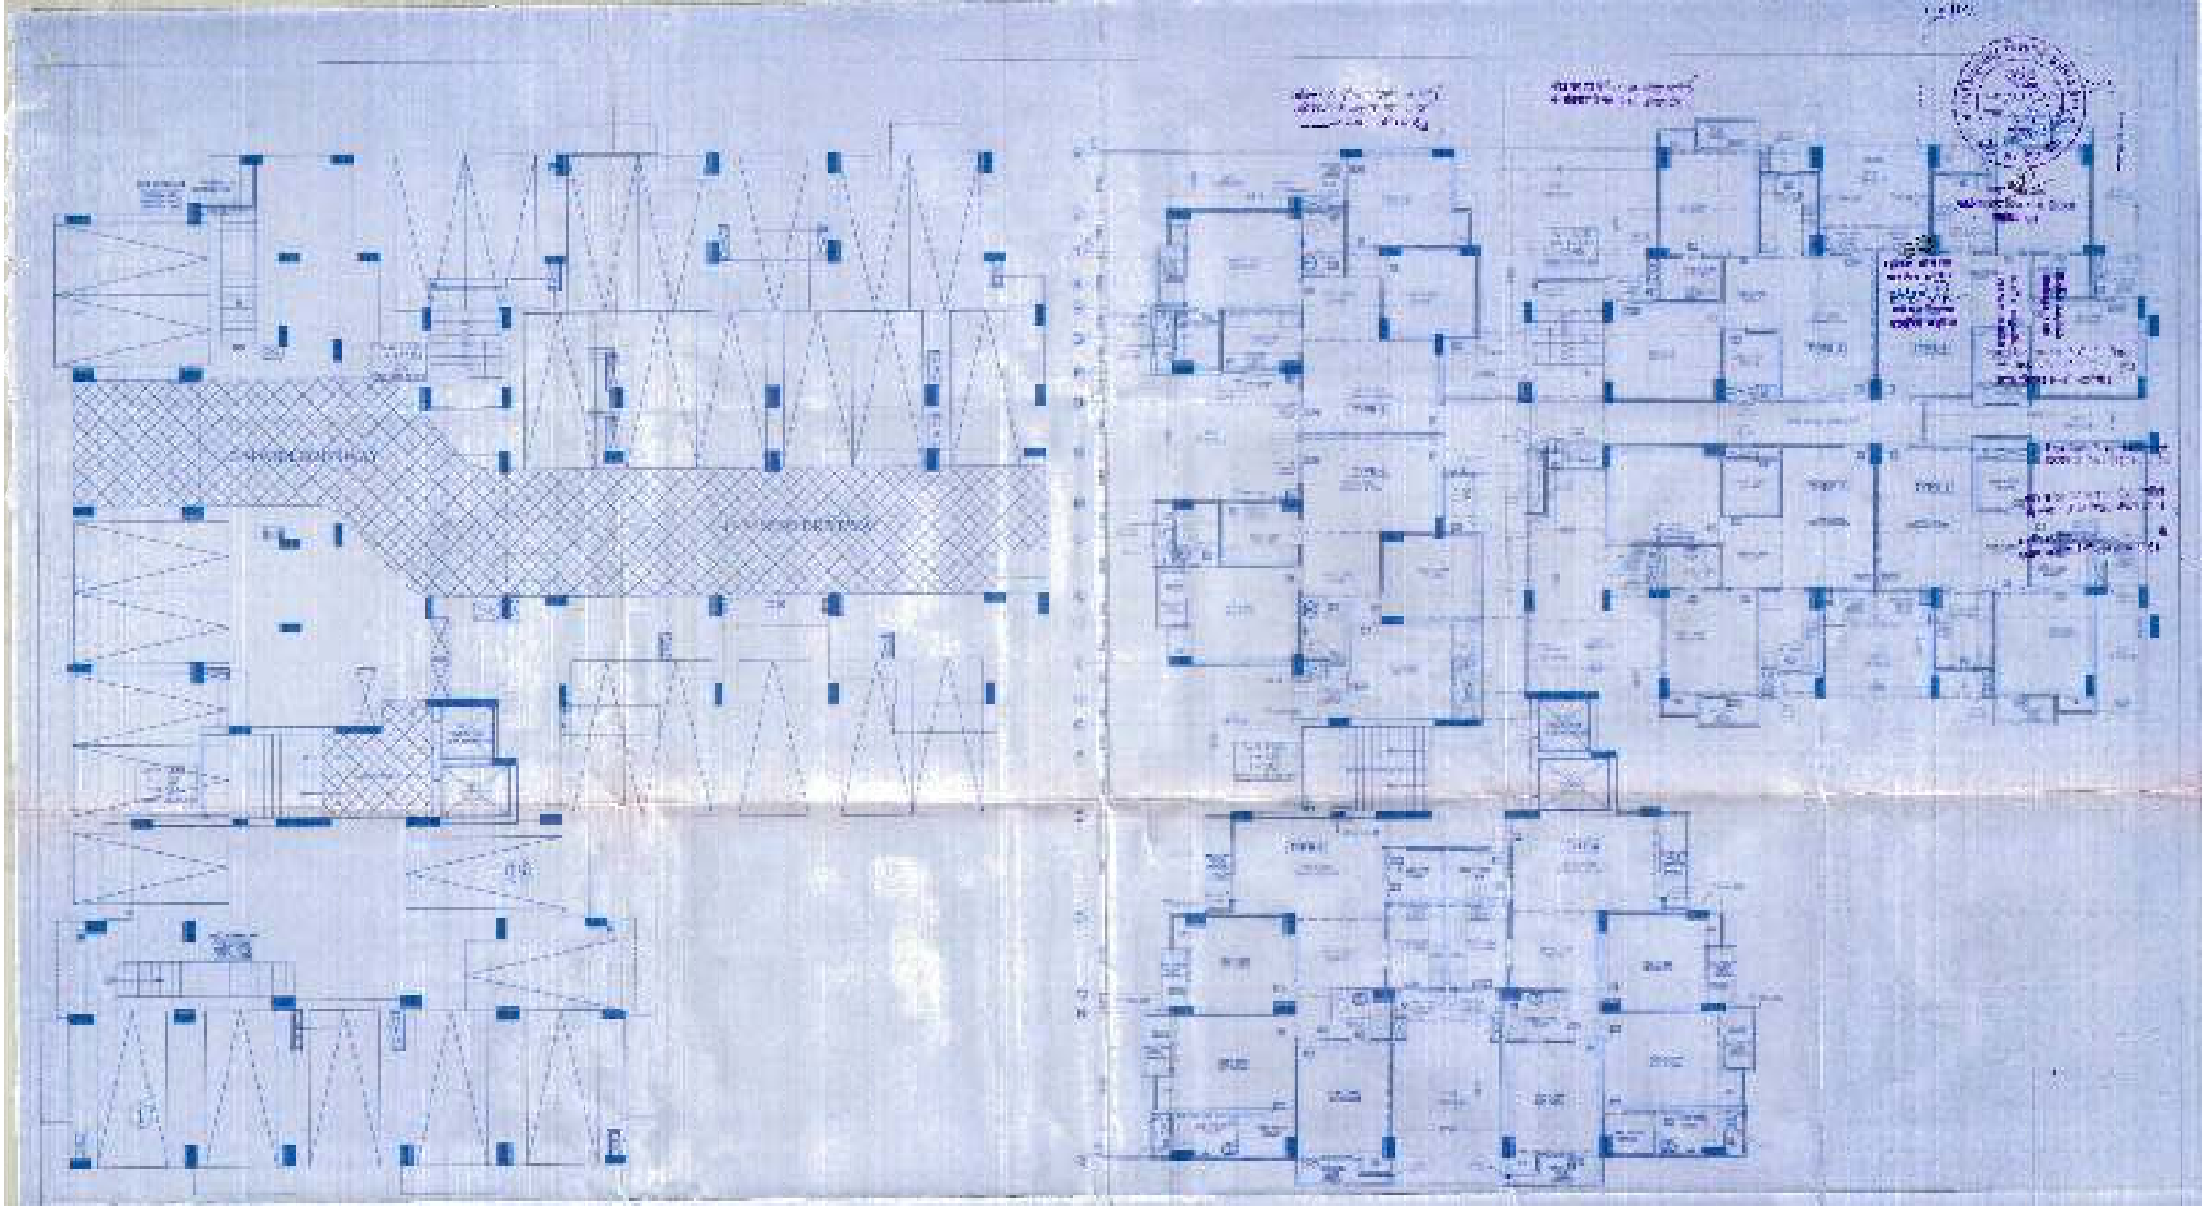


1st FLOOR PLAN
(PROPOSED)

1st FLOOR PLAN
(PROPOSED)






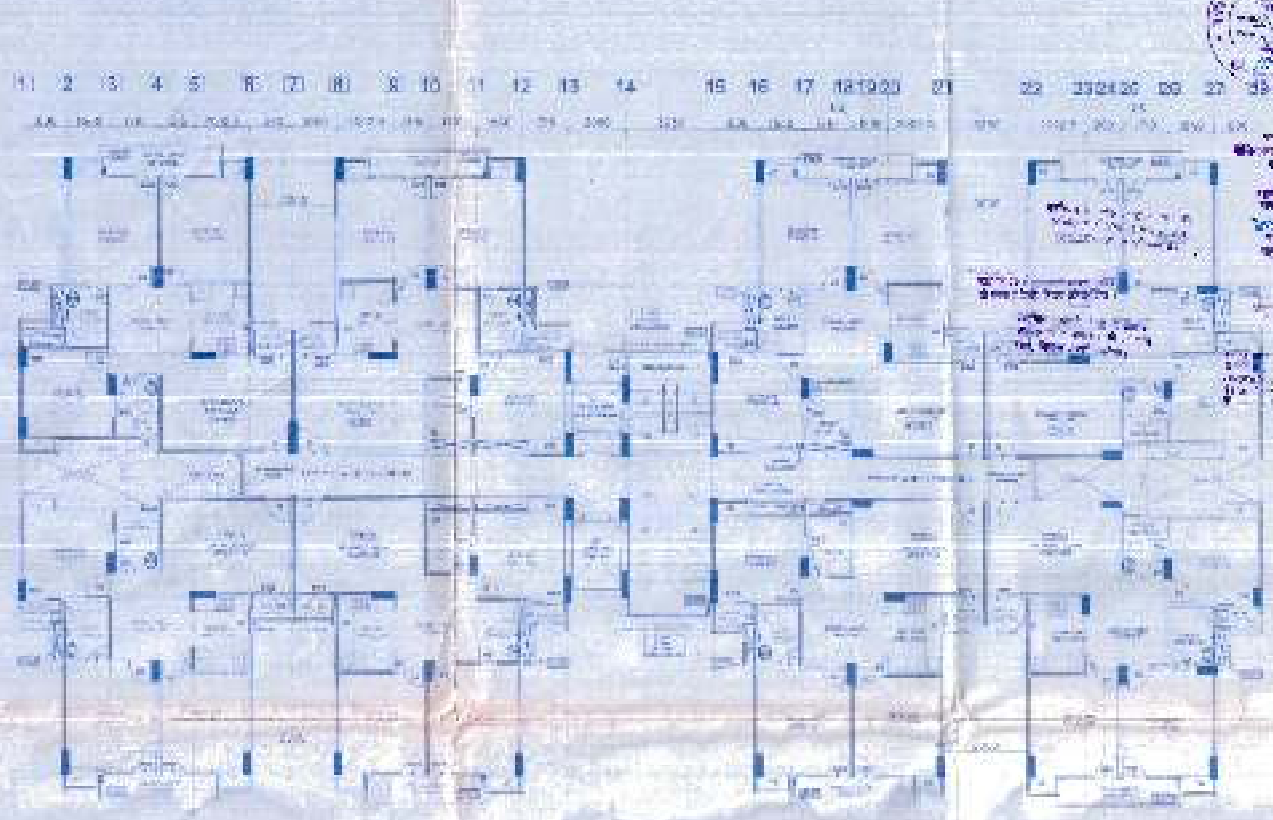

2ND TO 14th FLOOR PLAN

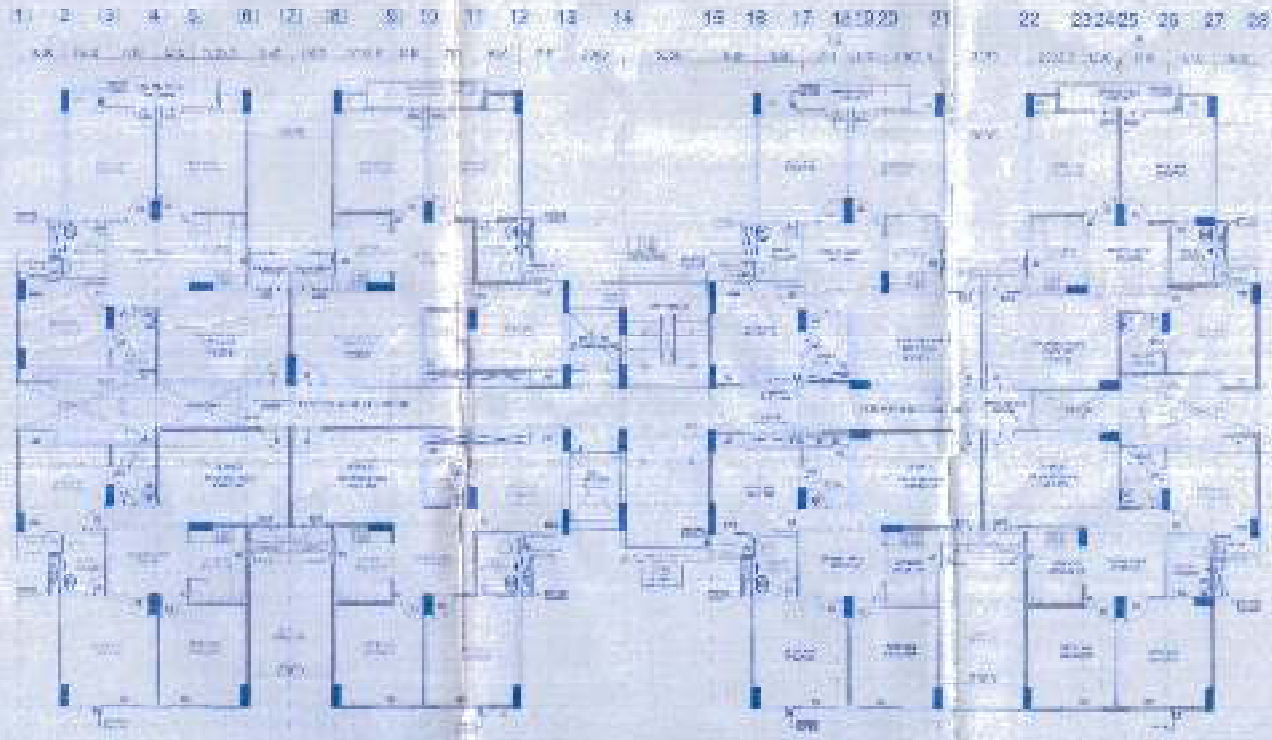



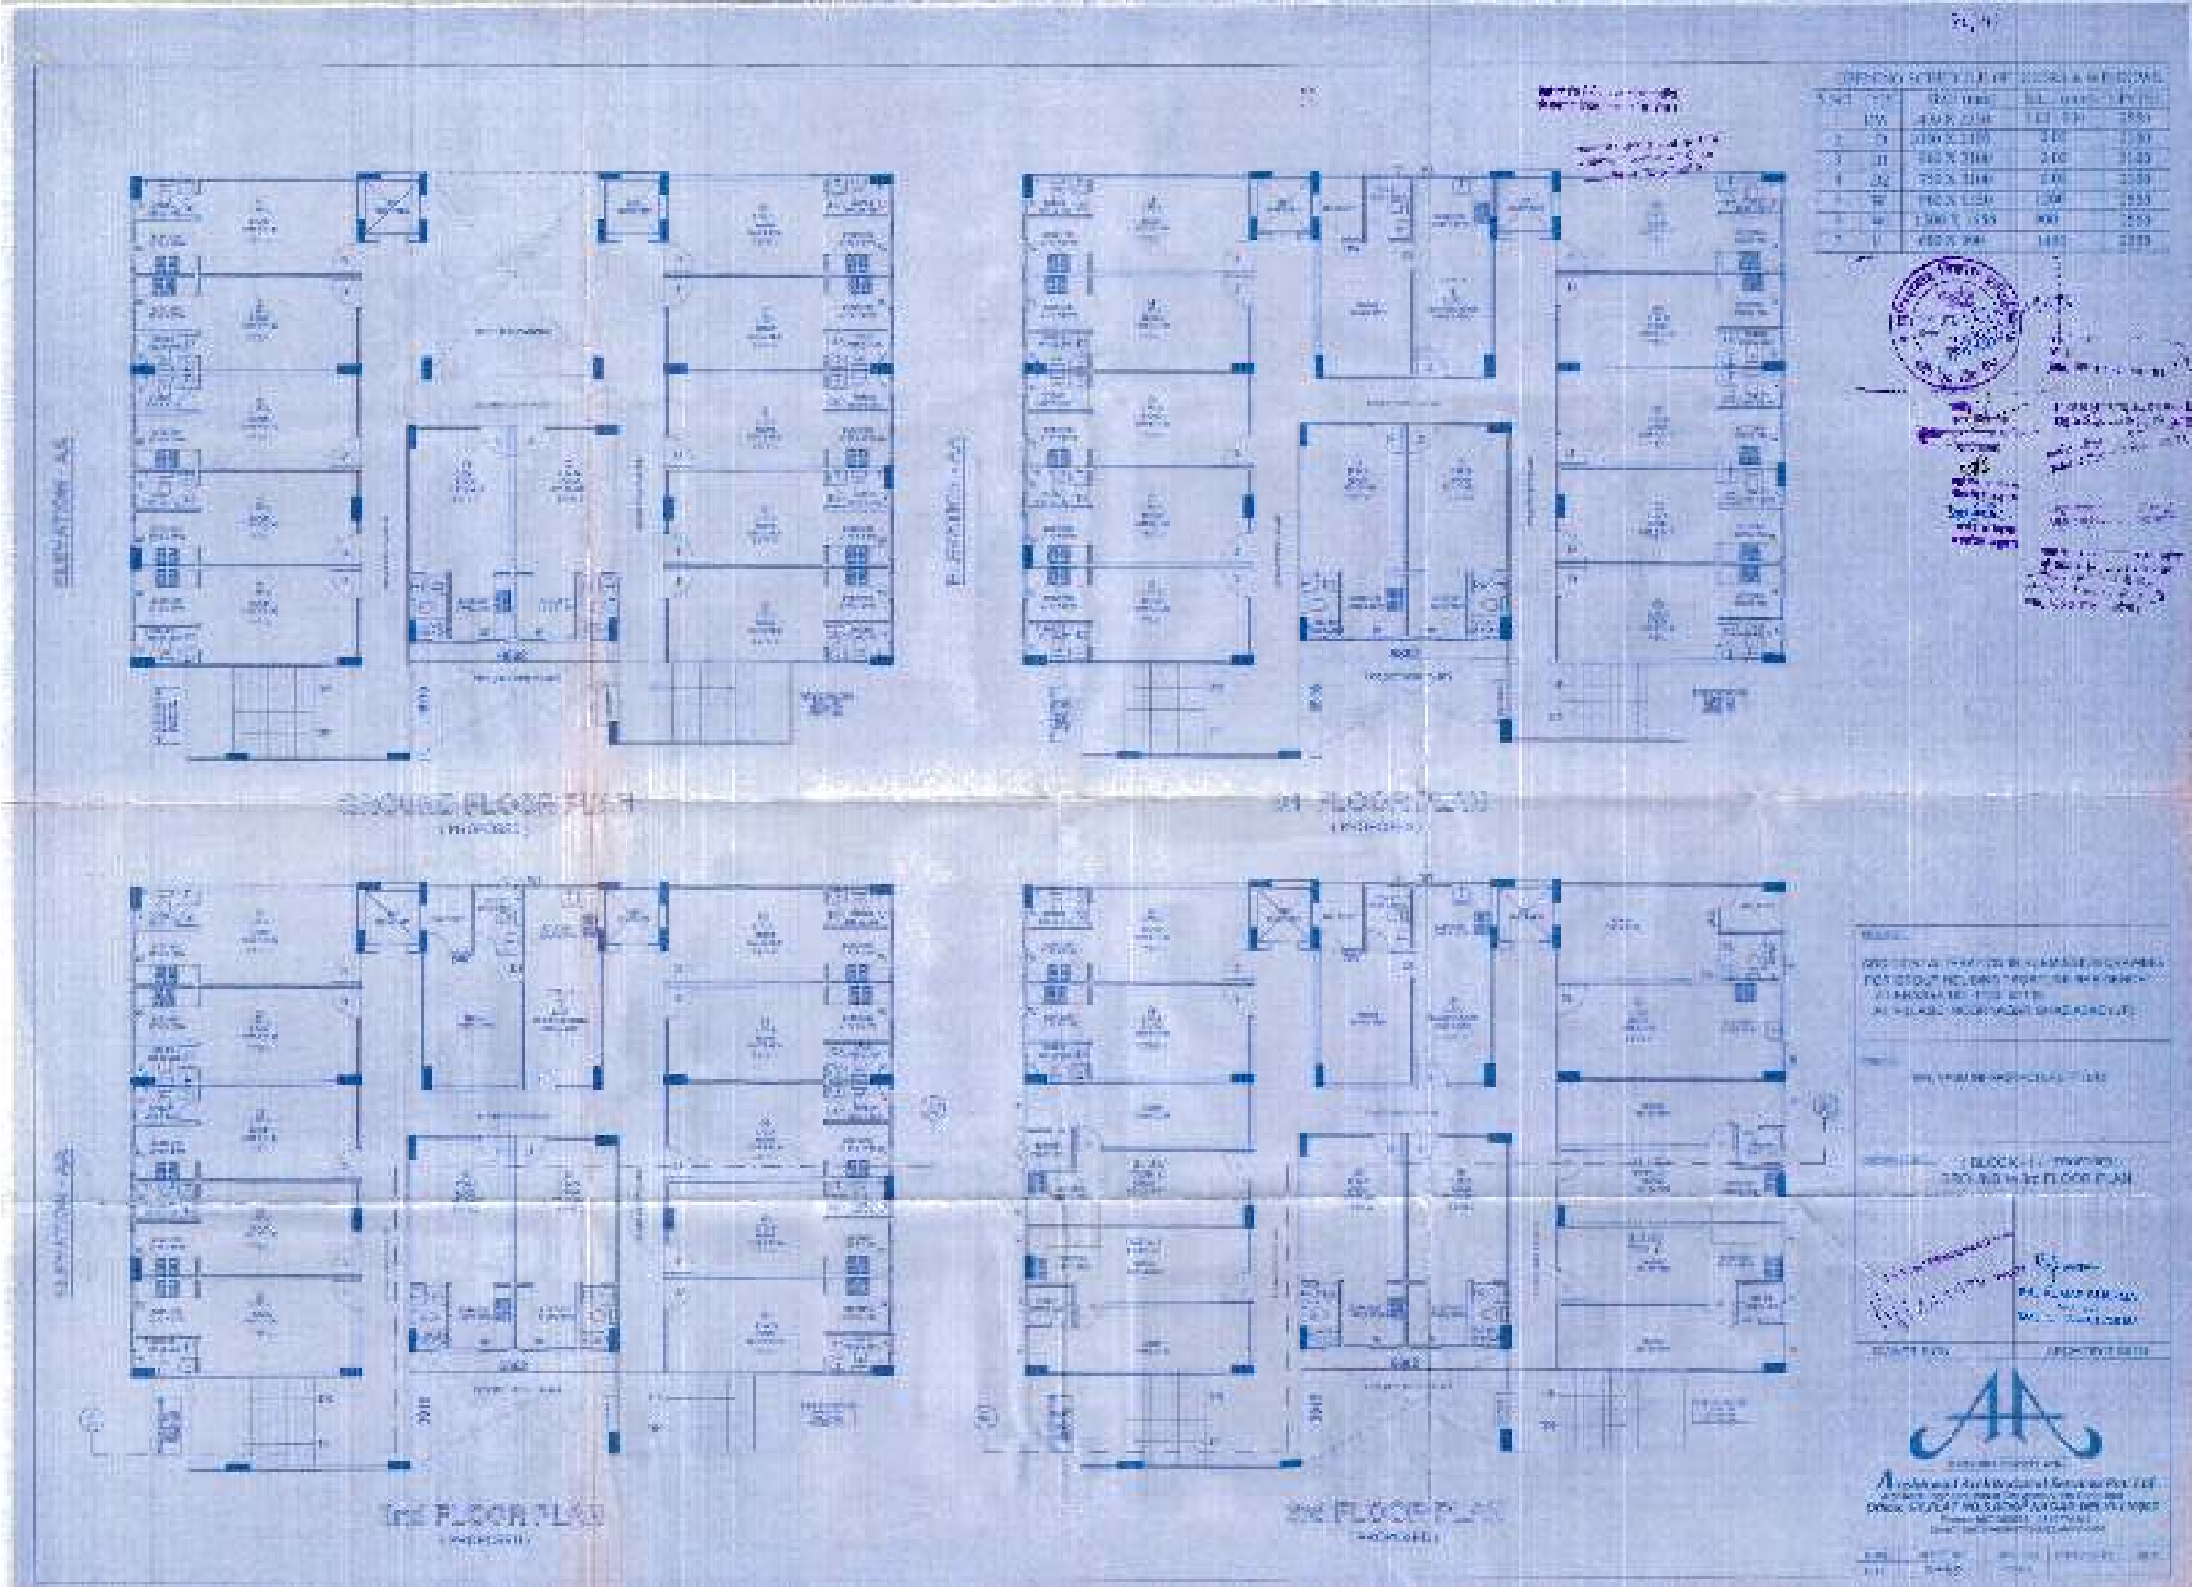
3rd FLOOR PLAN
1st FLOOR PLAN
2nd FLOOR PLAN

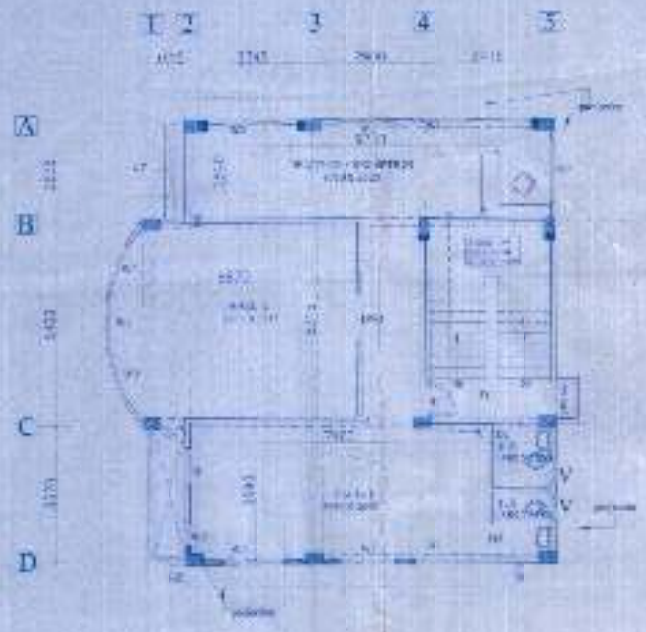

GROUND FLOOR PLAN

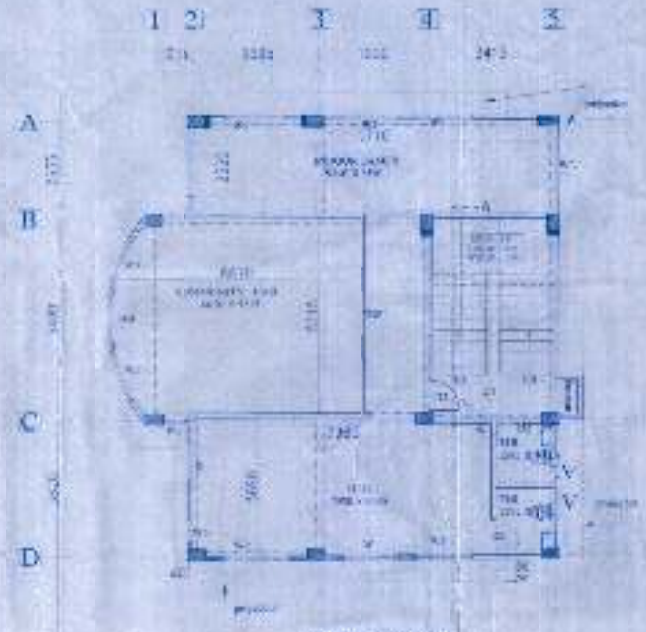

FIRST FLOOR PLAN

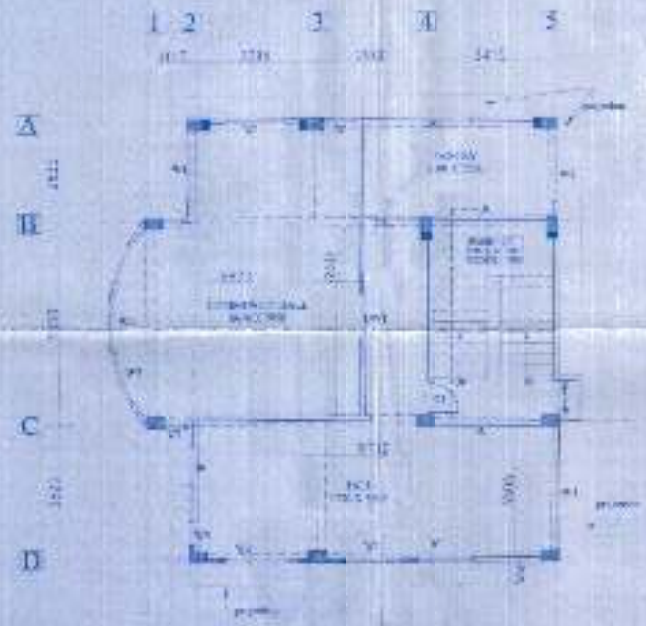

SECOND FLOOR PLAN

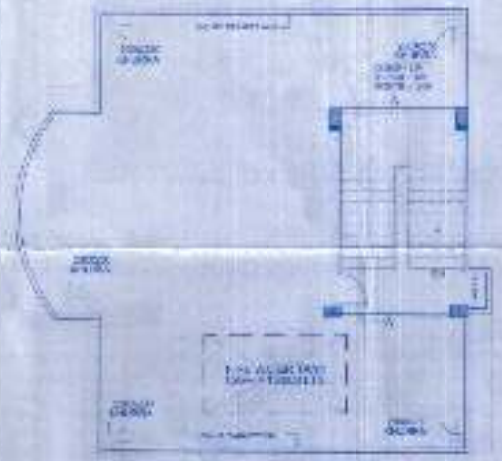

TERRACE FLOOR PLAN















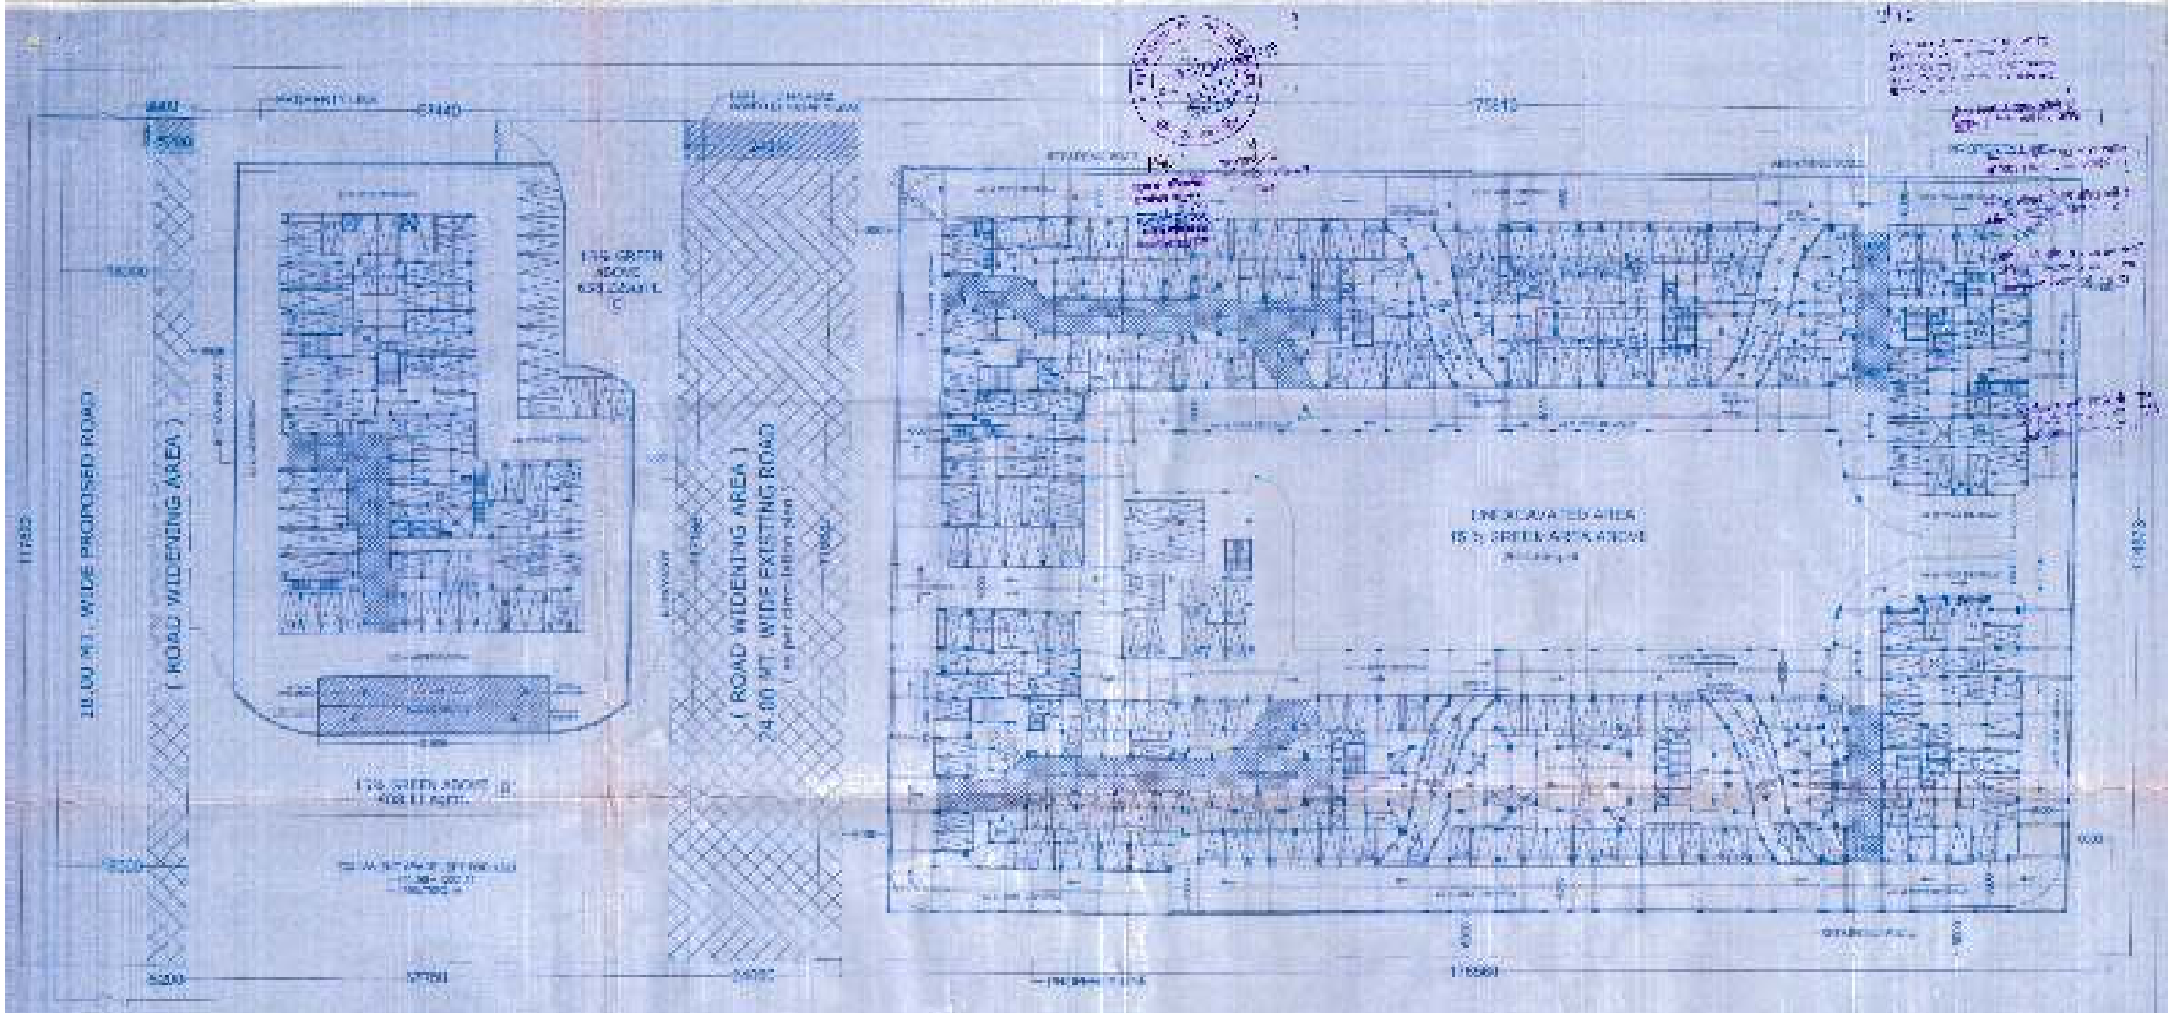

FIRST BASEMENT FLOOR PLAN

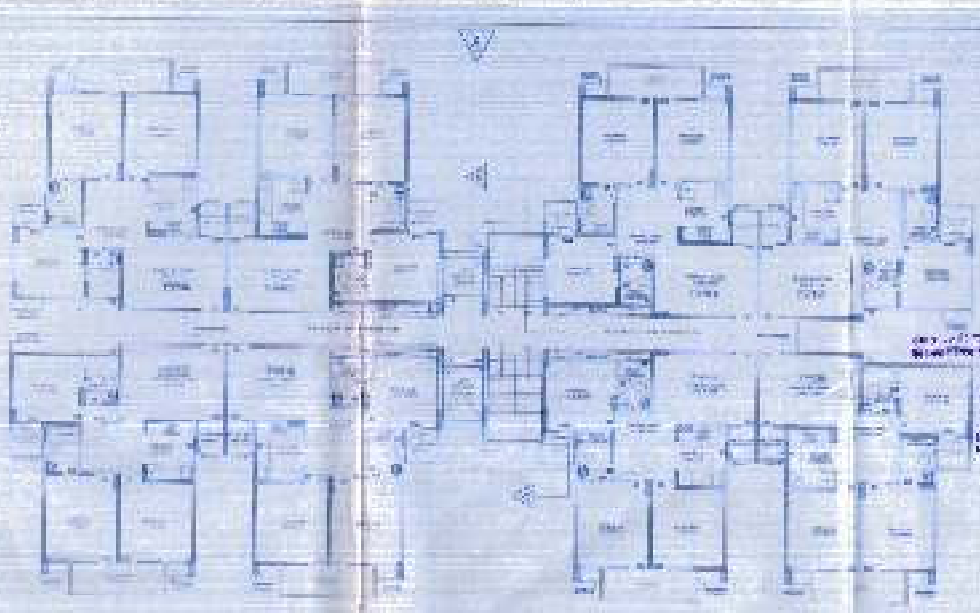

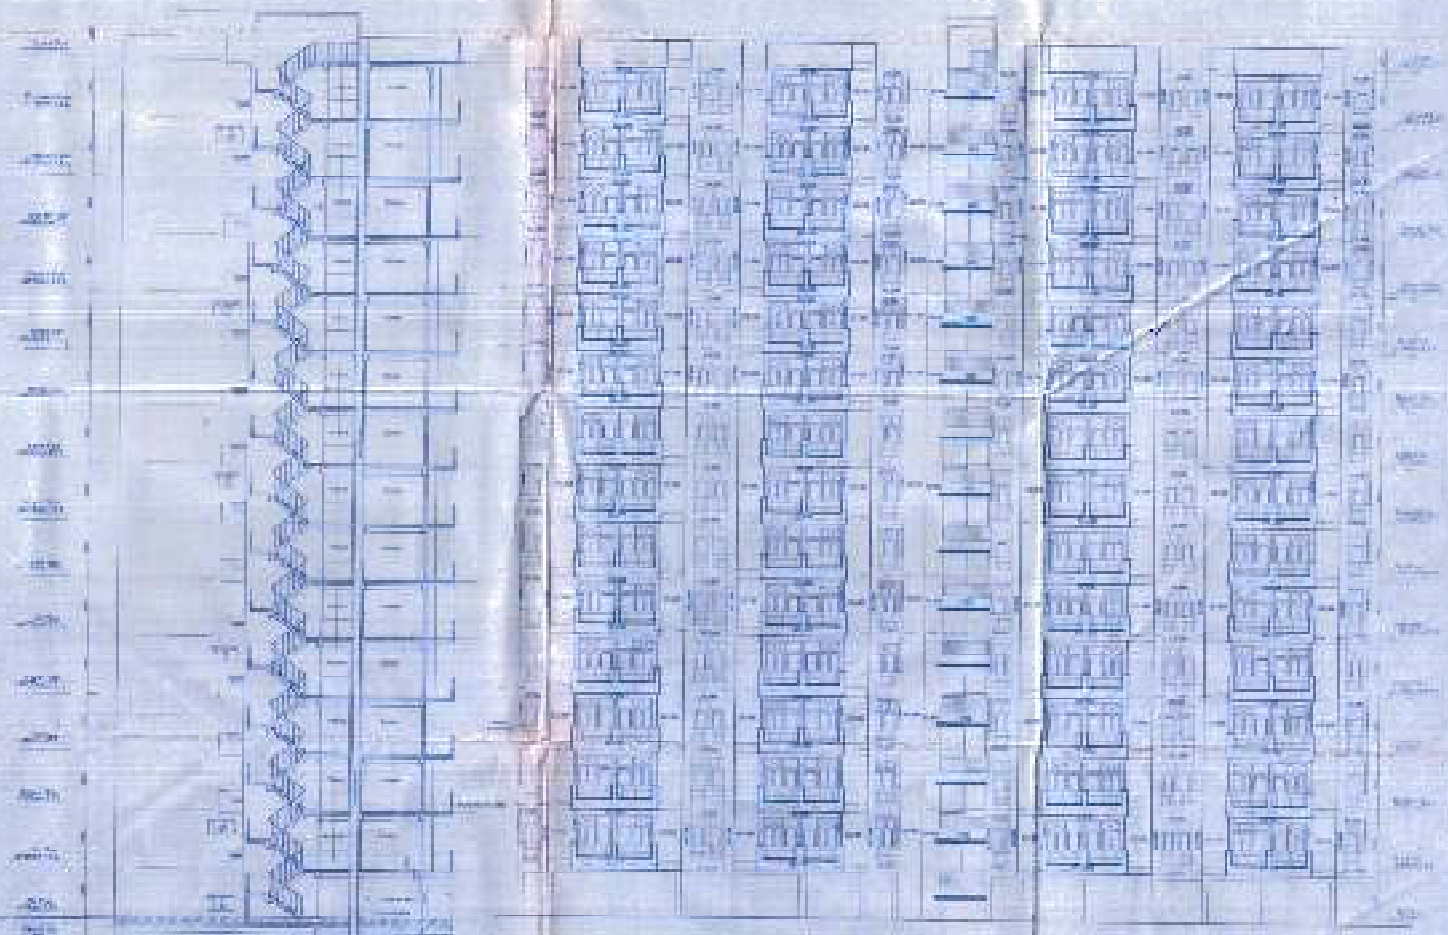

PROJECT:
DRAWING FOR GROUP HOUSING "HARBINE
RESIDENCY" AT KHASRA NO.-1189 &
AT VILLAGE KOORNAWALI GHAZIABAD (U.P.)

OWNER:
M/s. VIRU INFRASTRUCTURE PVT. LTD.
AND OTHERS

DRAWING TITLE:
ELEVATION & SECTION
(BLOCK - G)

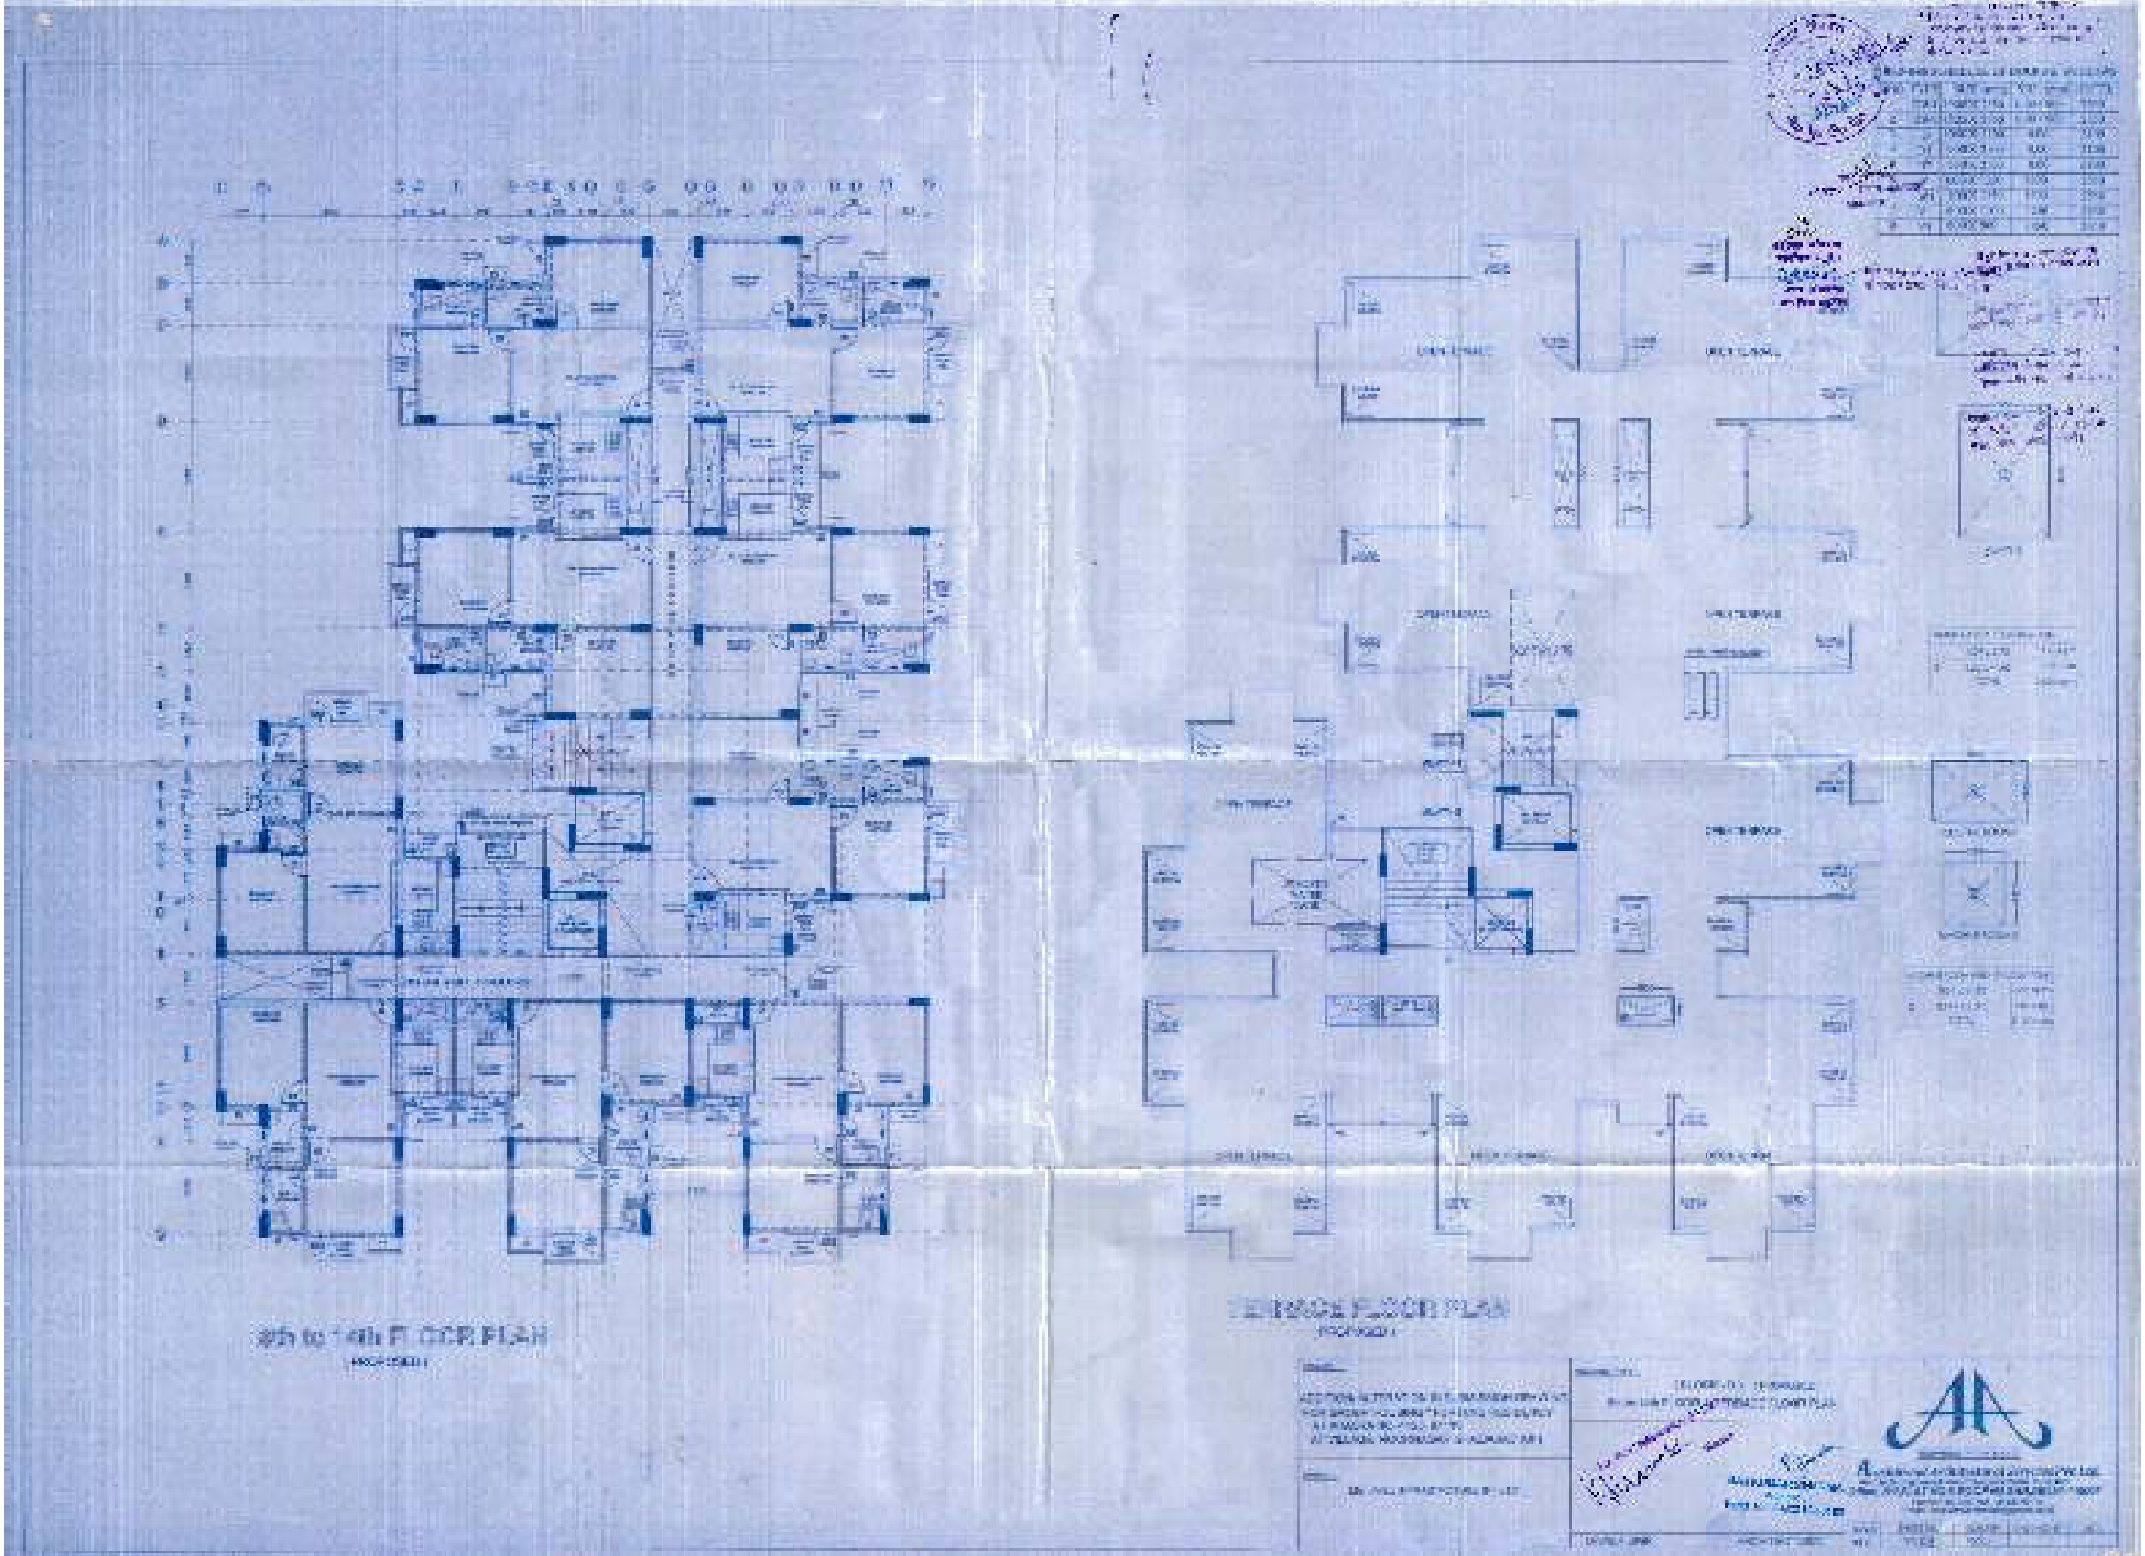

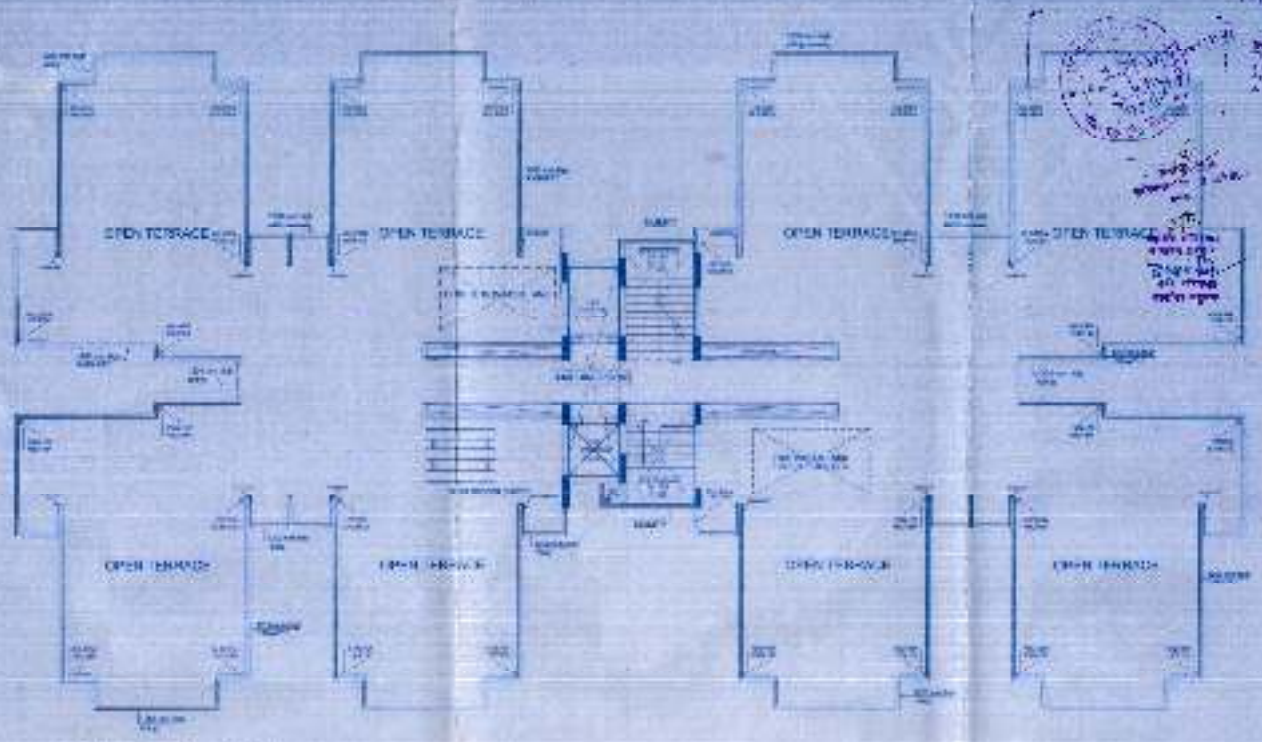

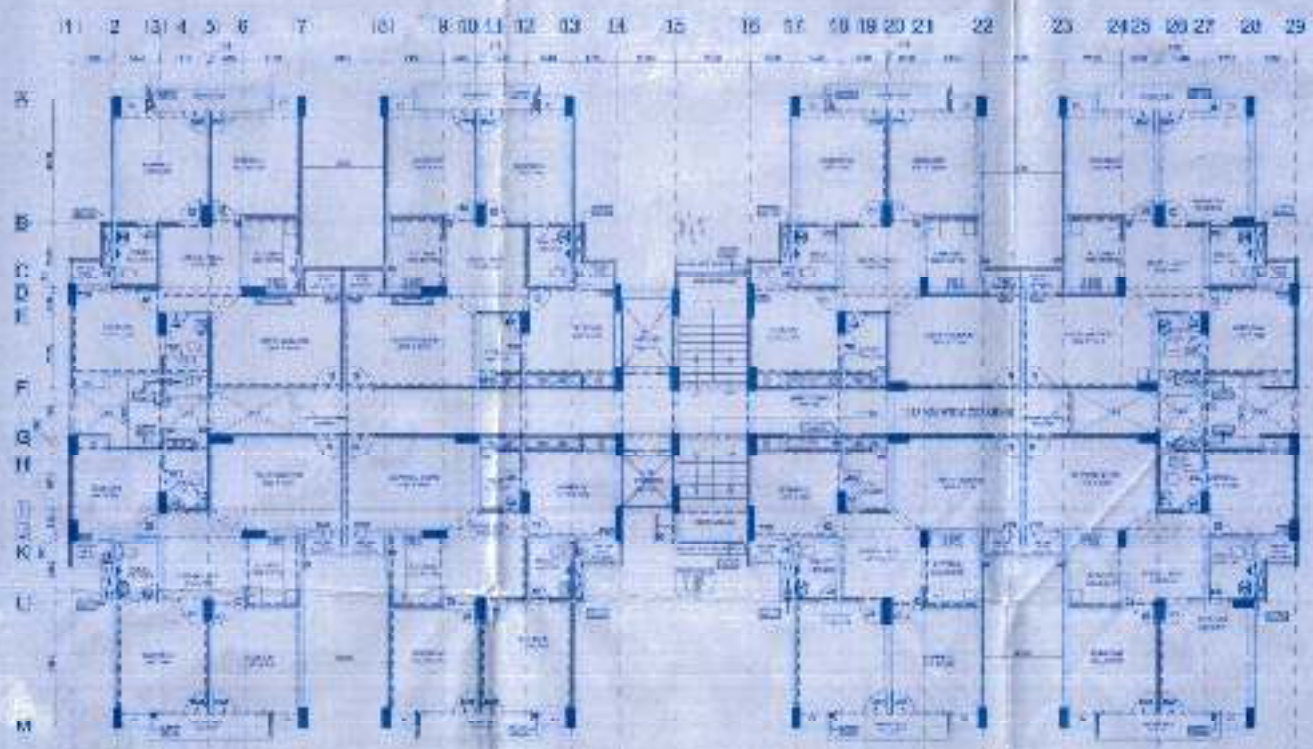

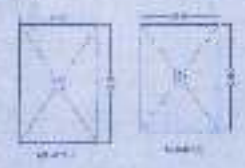

SIGN	TYPE	SIZE (mm)	SILL (mm)	HEIGHT
1	Dw1	[illegible]	[illegible]	[illegible]
2	Dw2	220 X 2350	[illegible]	2350
3	D	[illegible]	3.00	[illegible]
4	D1	[illegible]	3.00	2100
5	D2	[illegible]	3.00	2100
6	[illegible]	[illegible]	200	[illegible]
7	V	[illegible]	[illegible]	[illegible]
8	V1	[illegible]	[illegible]	2150

Architectural Services Pvt. Ltd.

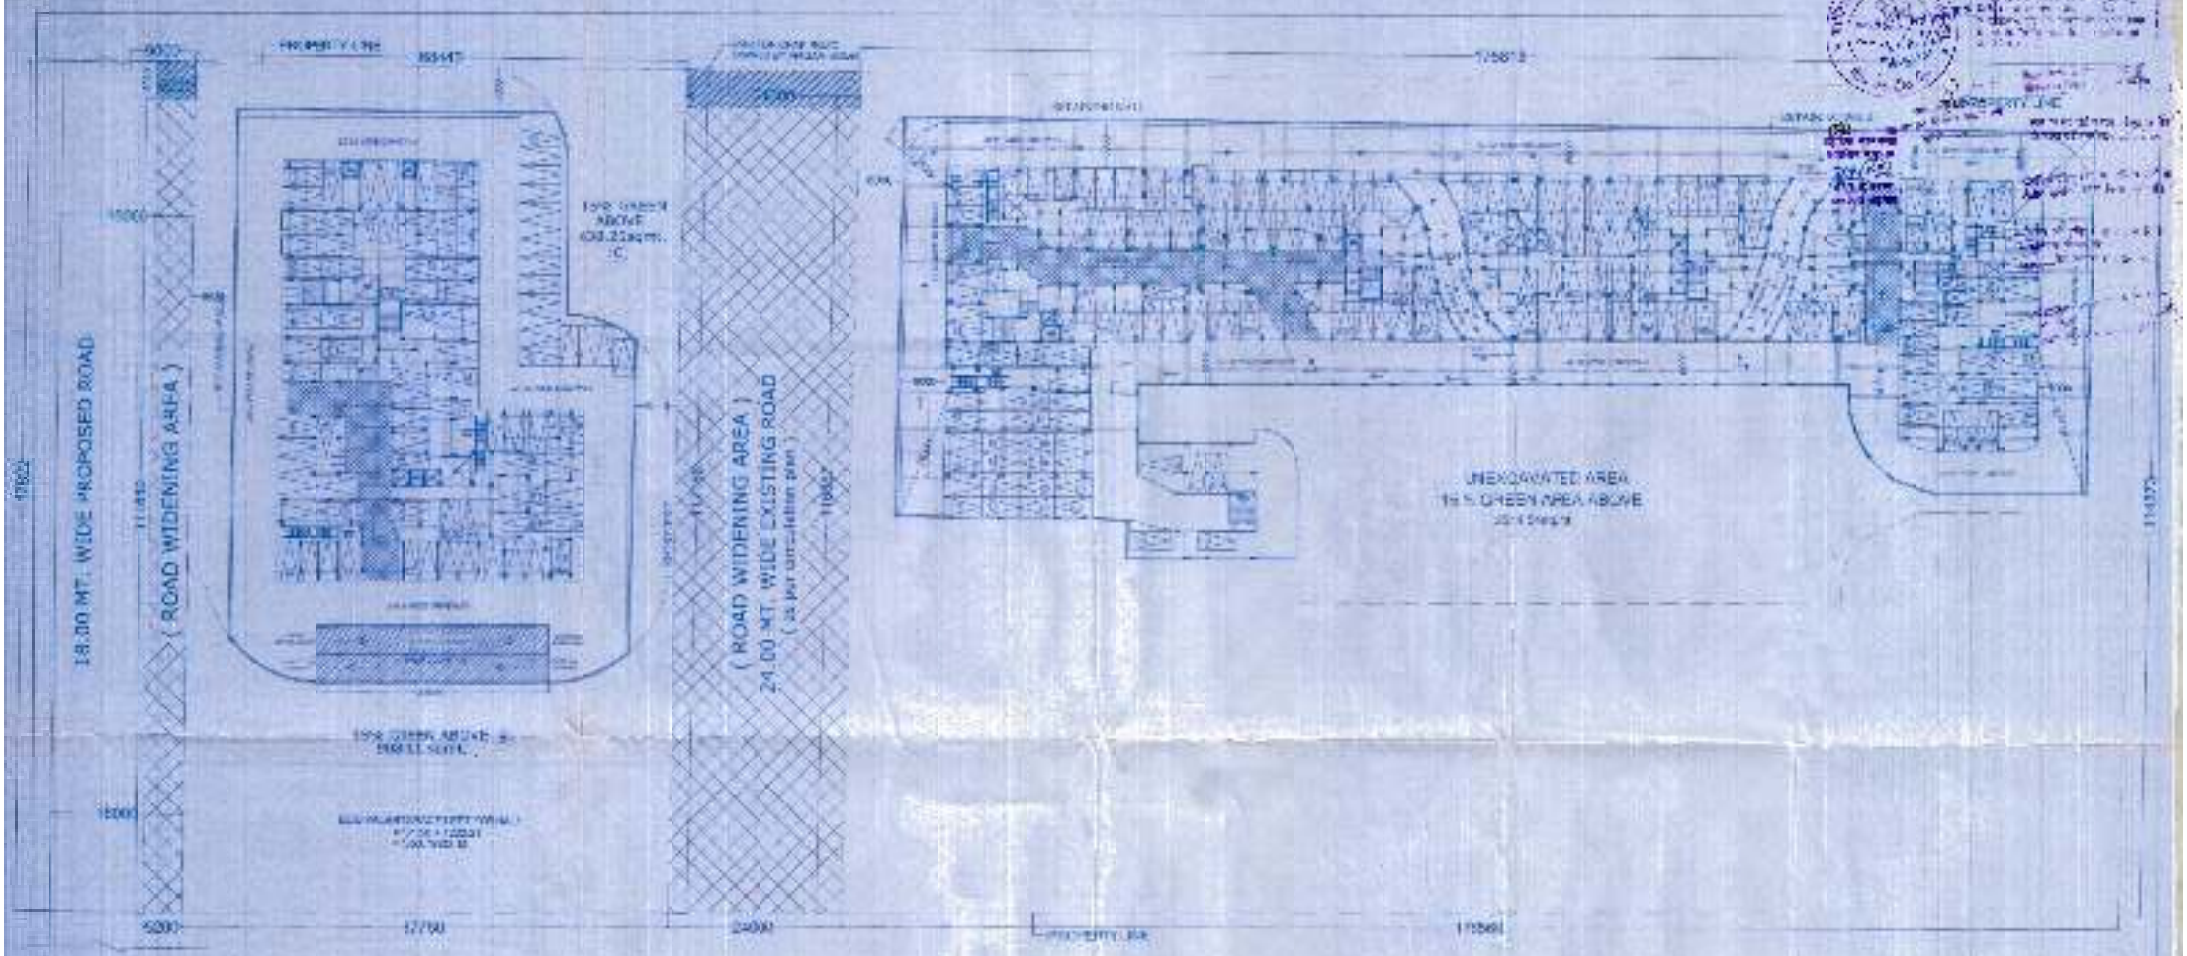

SECOND BASEMENT FLOOR PLAN

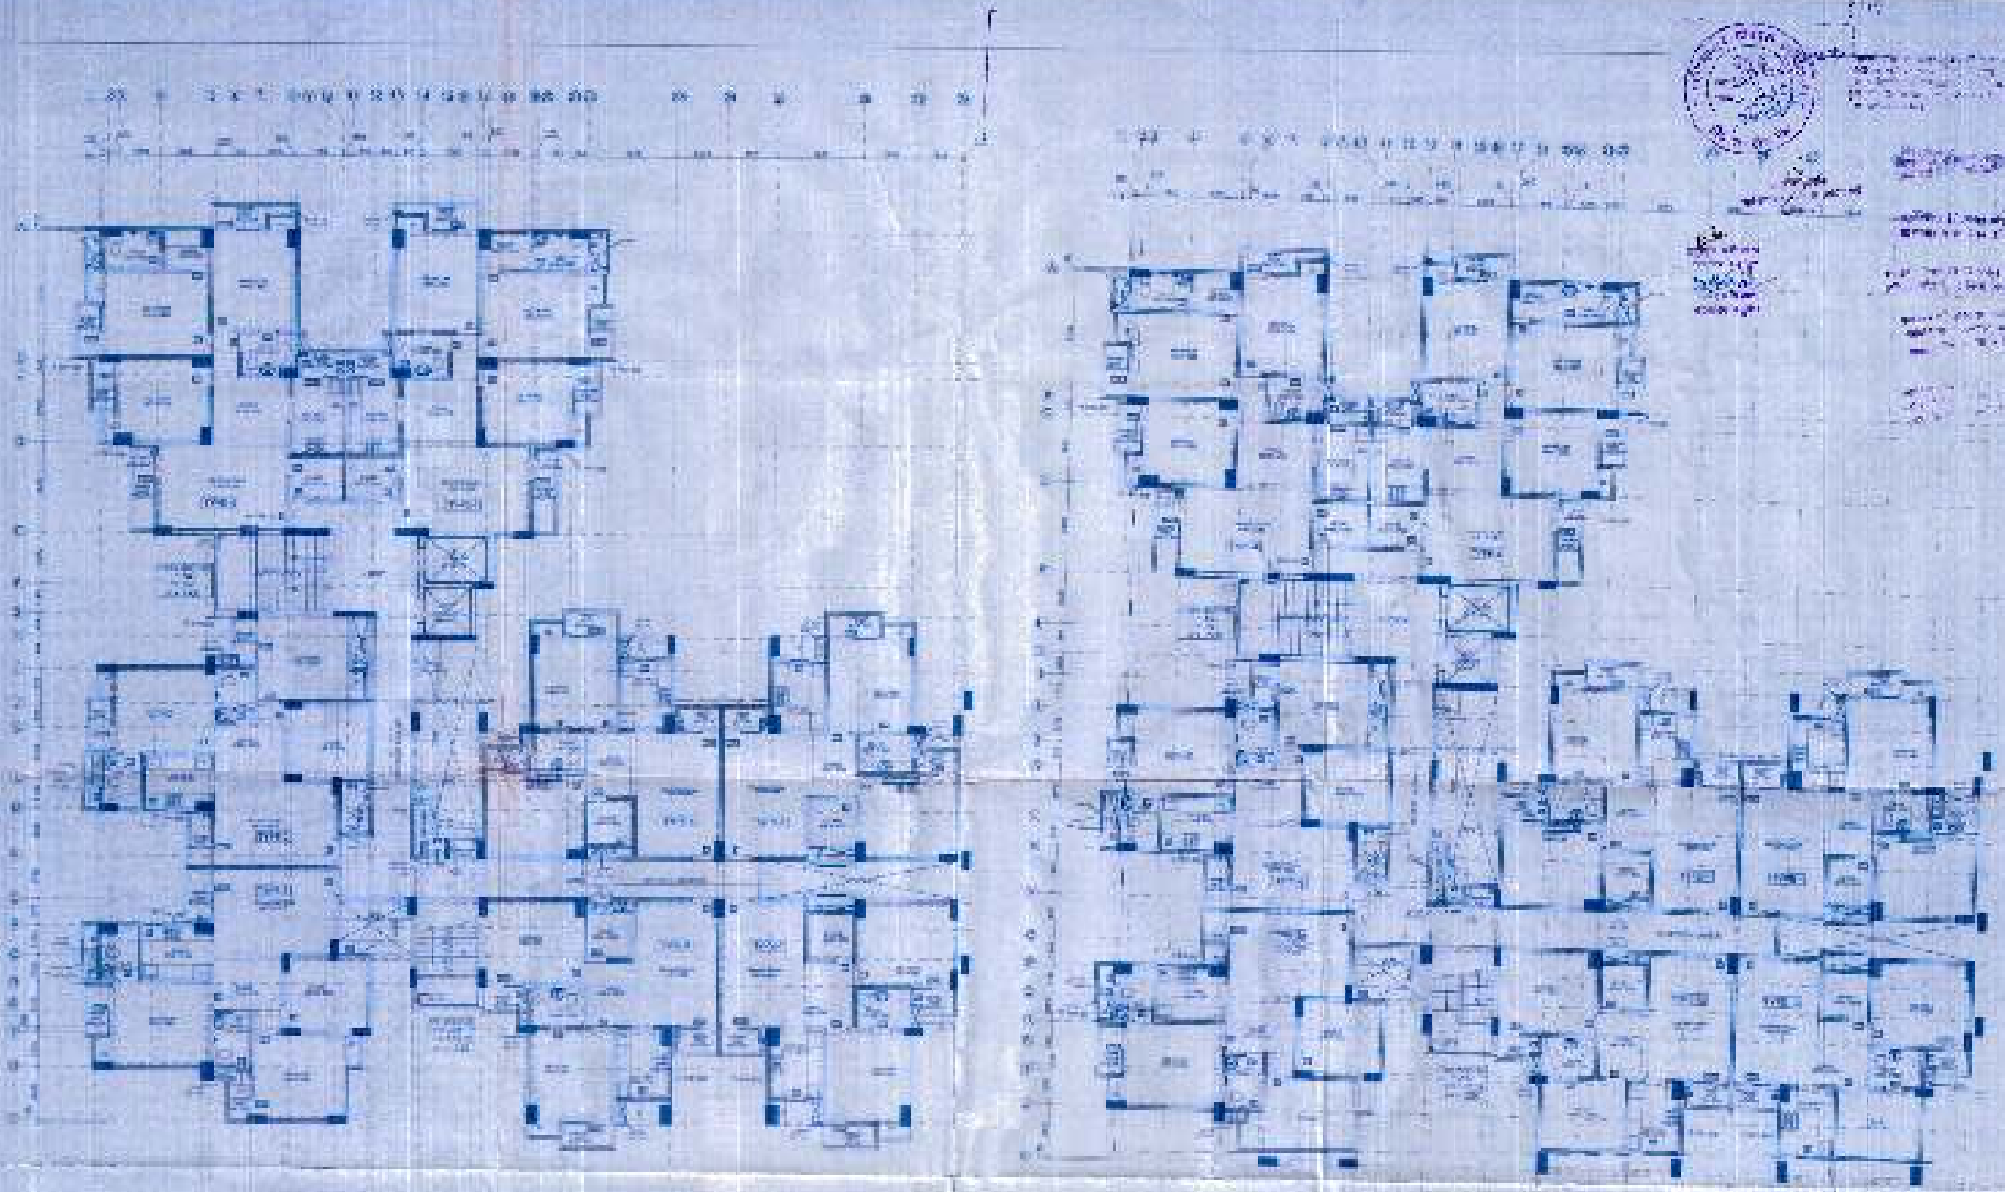

1ST FLOOR PLAN

2ND FLOOR PLAN

SCHEDULE OF DOORS & WINDOWS				

PROJECT


SHEET

BUILDING: 1 BLOCK - A1 (PROPOSED)
1ST & 2ND FLOOR FLOOR PLAN

ARCHITECTS

DATE | SHEET NO. | DRAWN BY | CHECKED BY | DATE

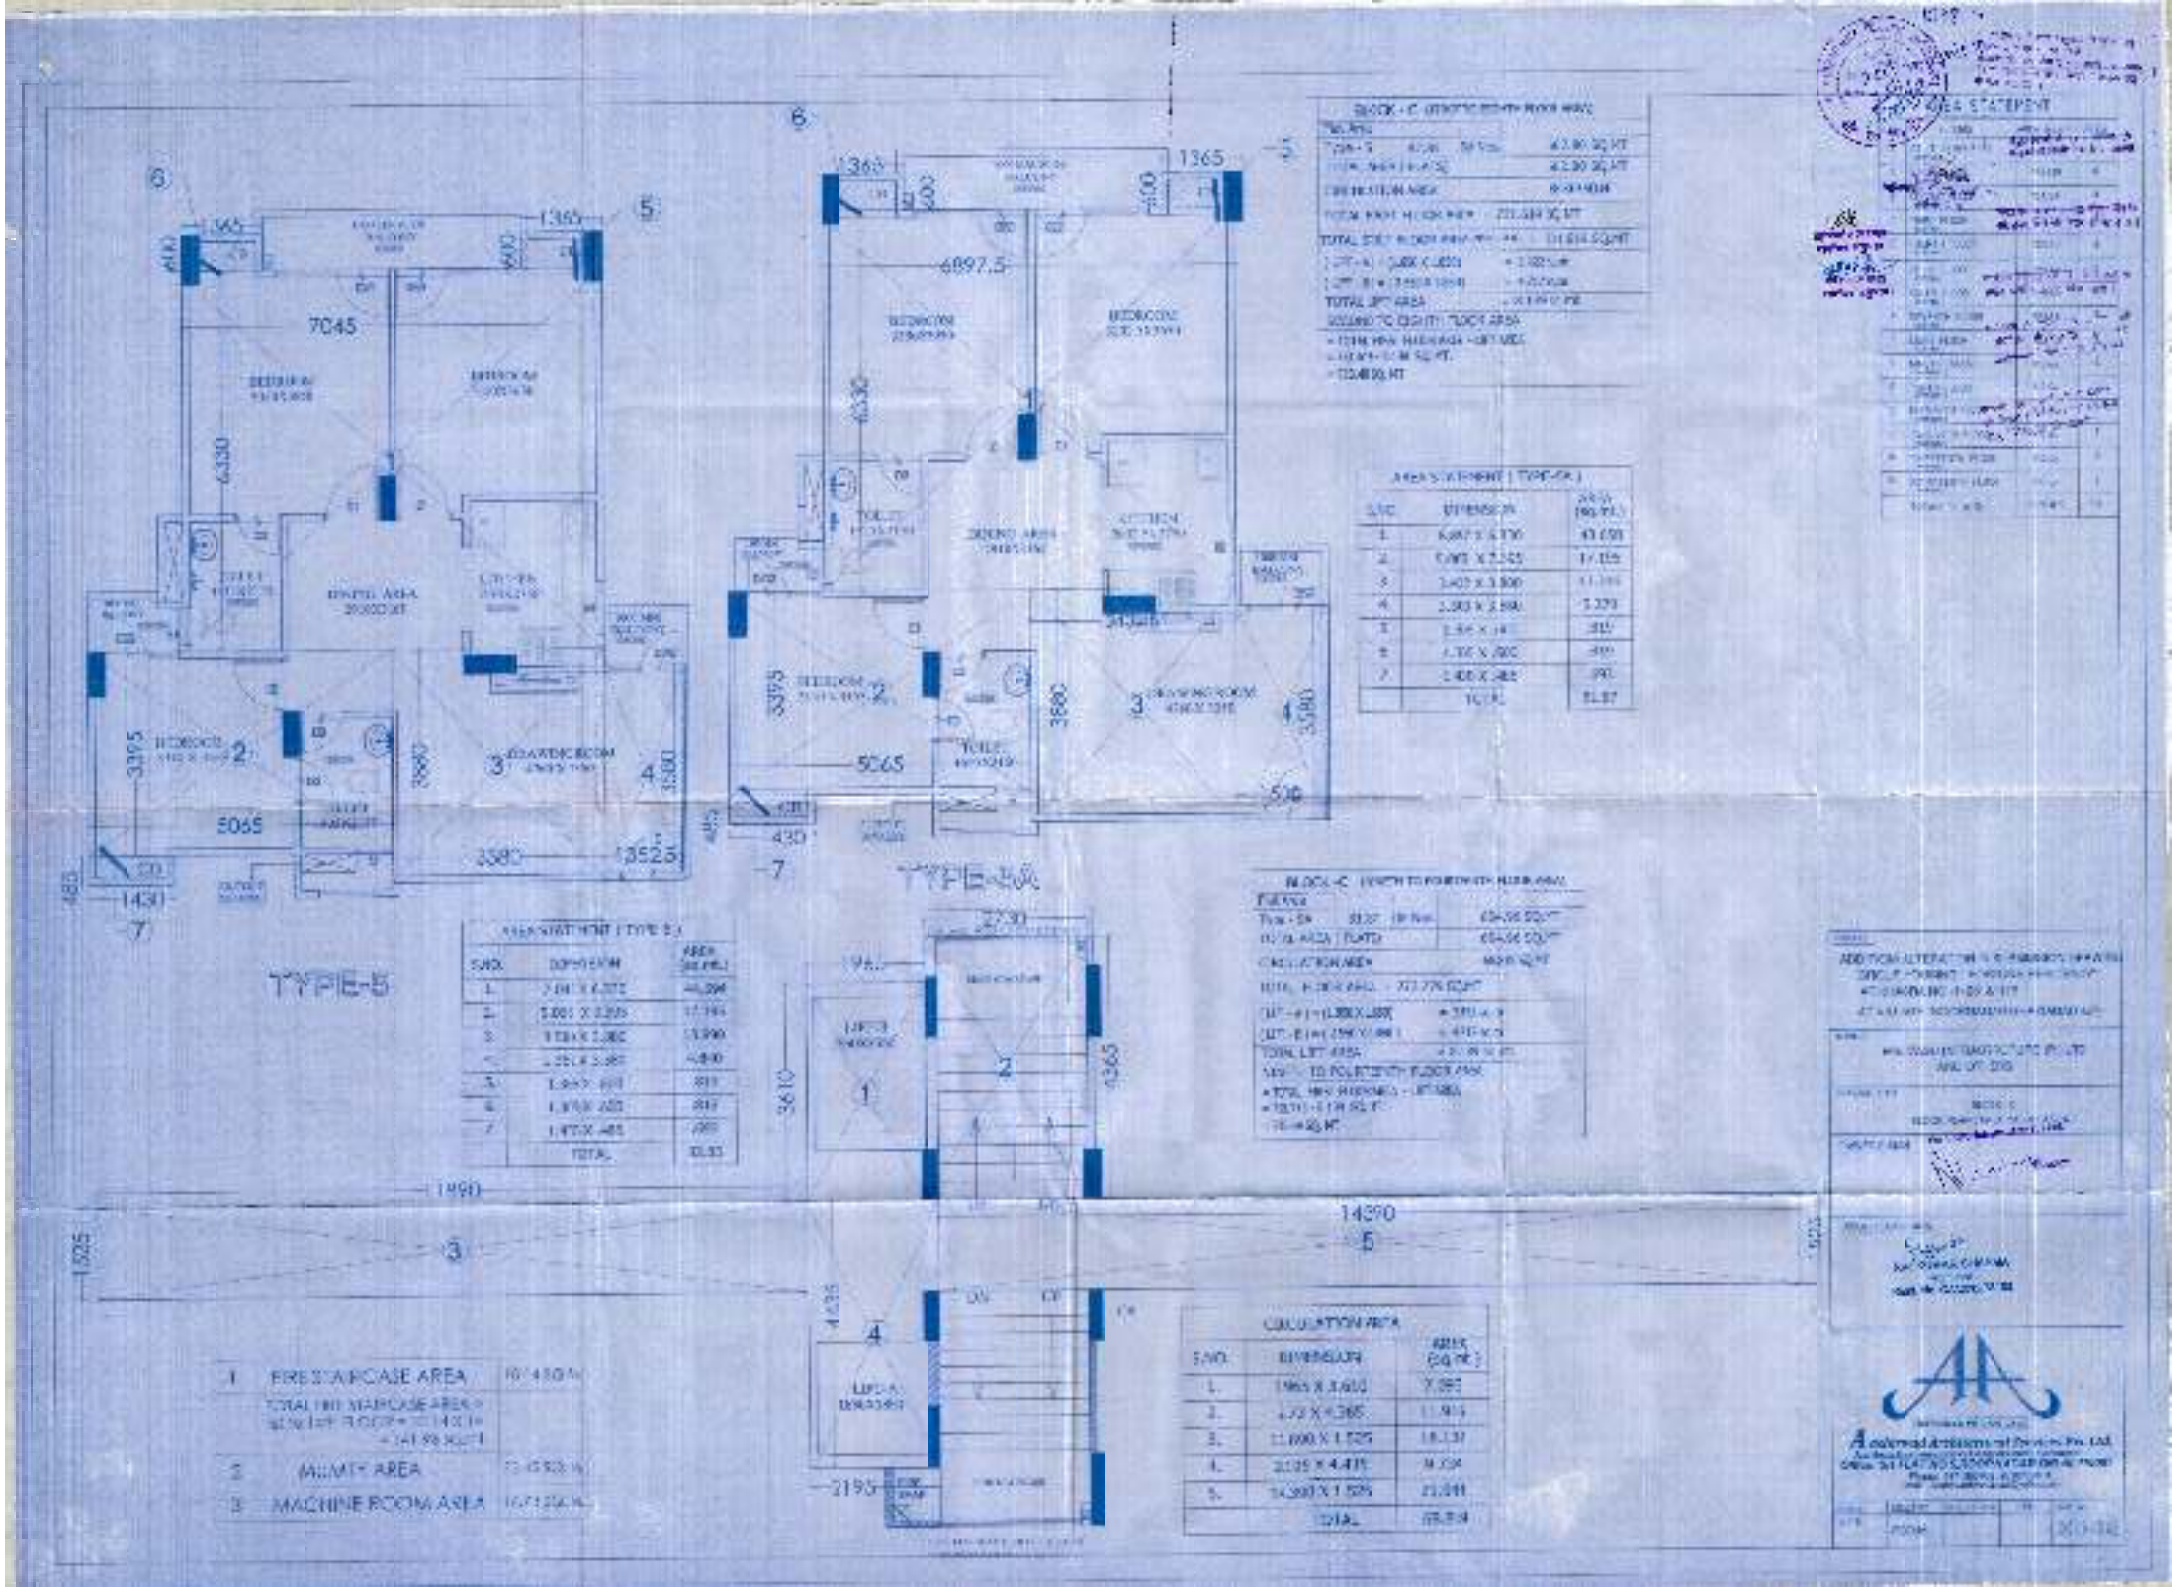
TYPE-5
TYPE-5A
7045
6097.5
5065
3580
1365
1430
1490
14490
2195
AREA STATEMENT
CIRCULATION AREA
FIRE STAIRCASE AREA
MUMTY AREA
MACHINE ROOM AREA

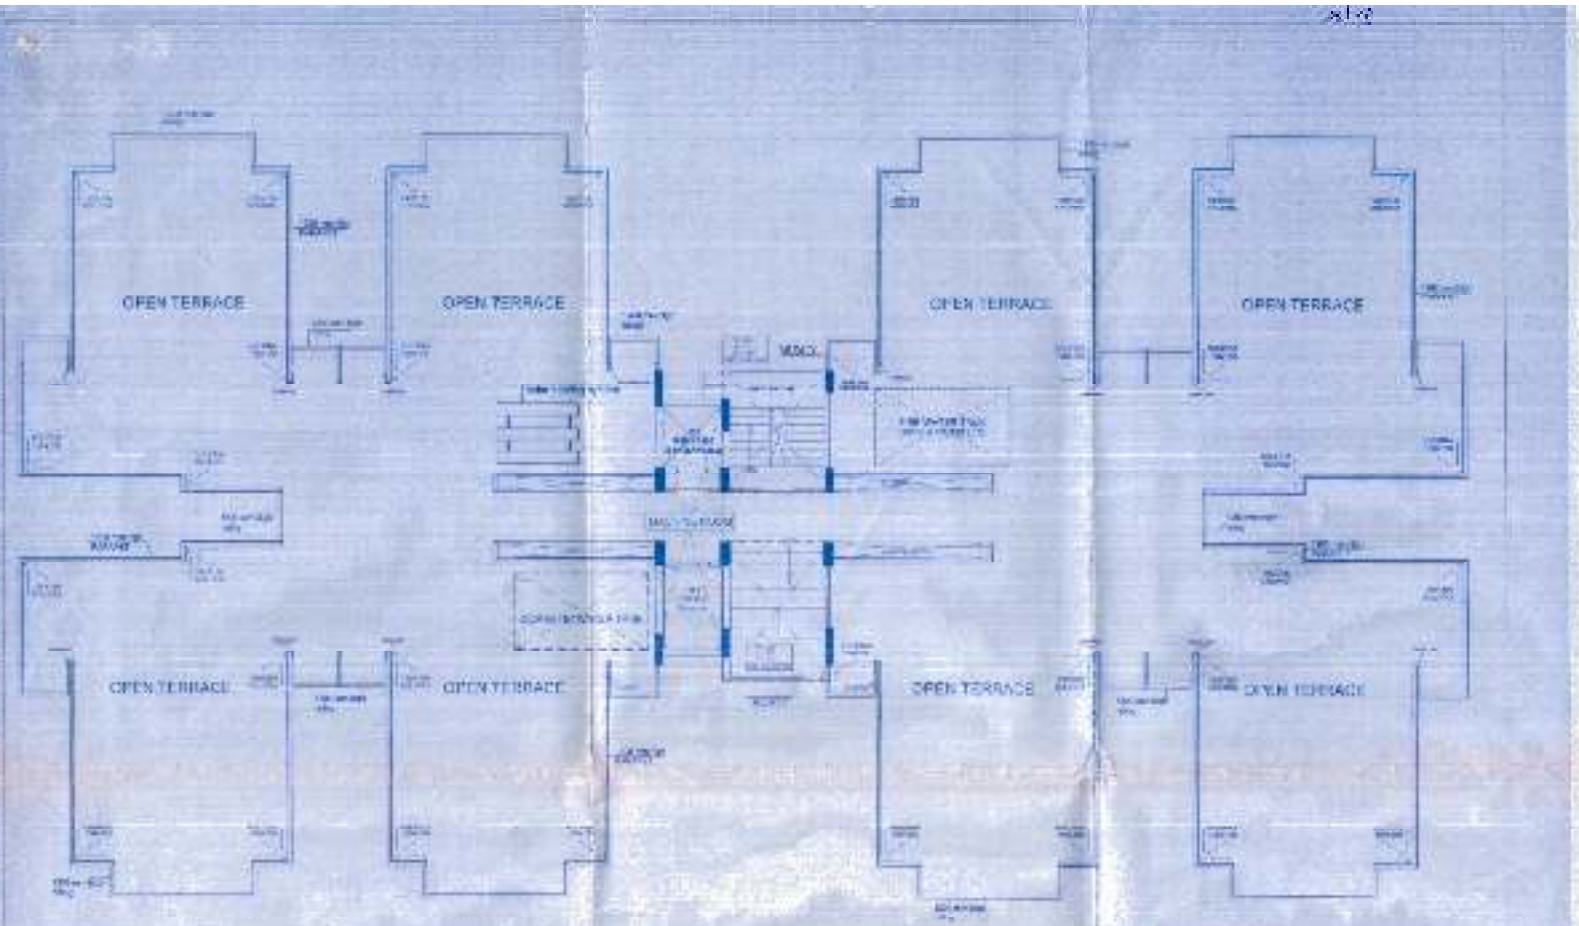

TERRACE FLOOR PLAN

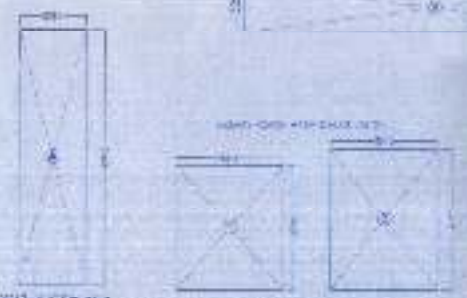

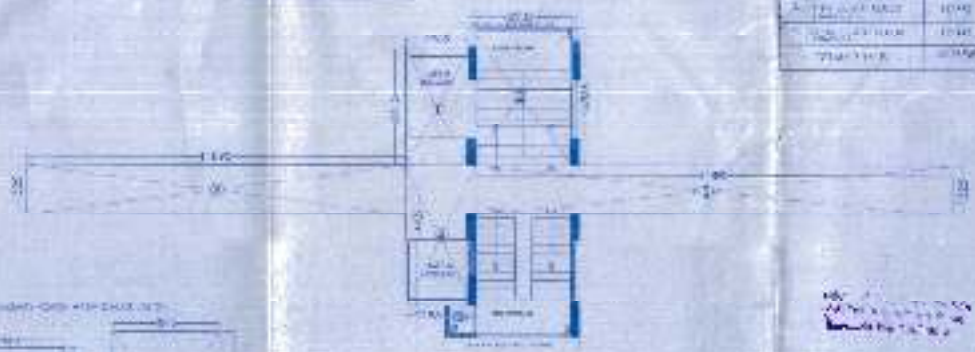

AREA STATEMENT

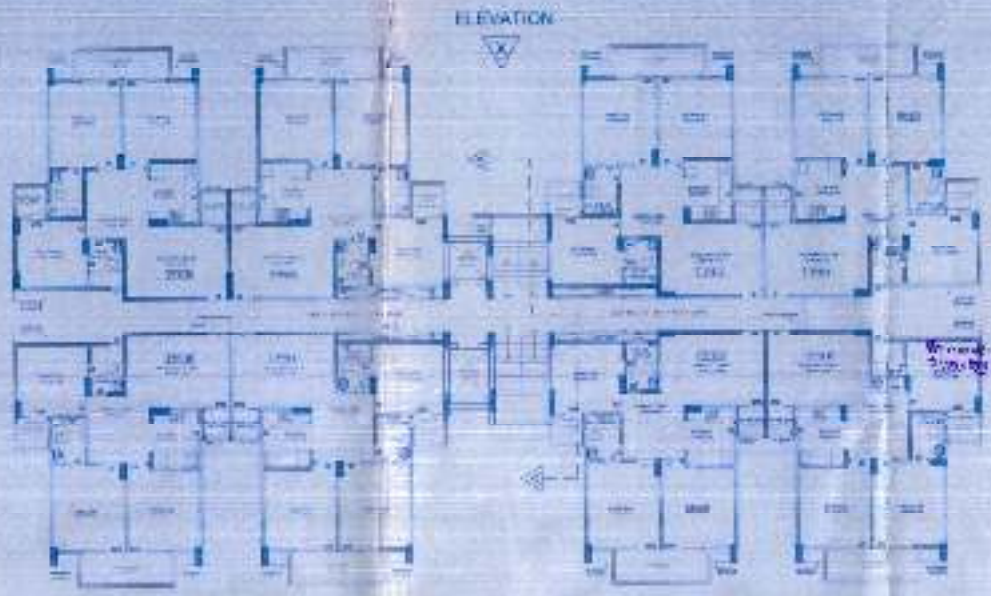

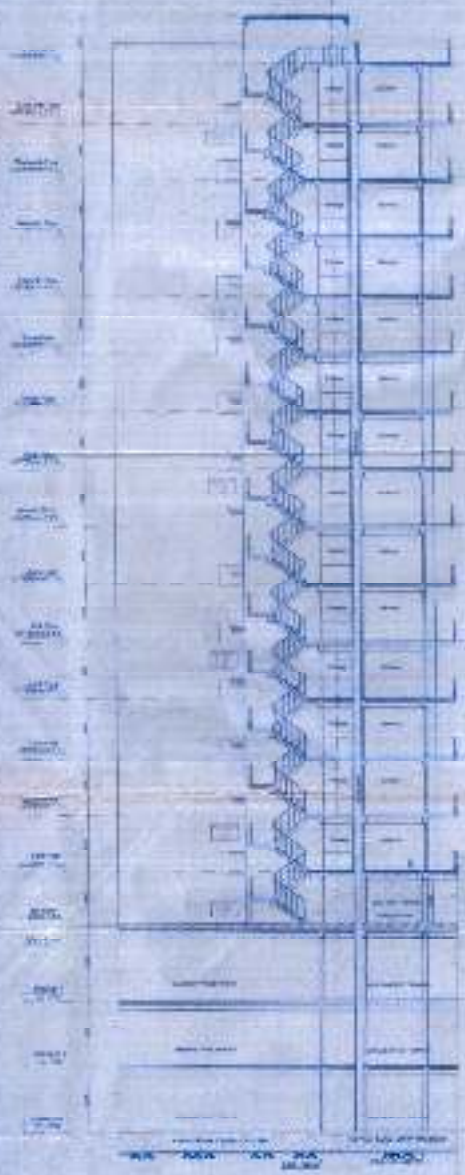

SECTION - AA

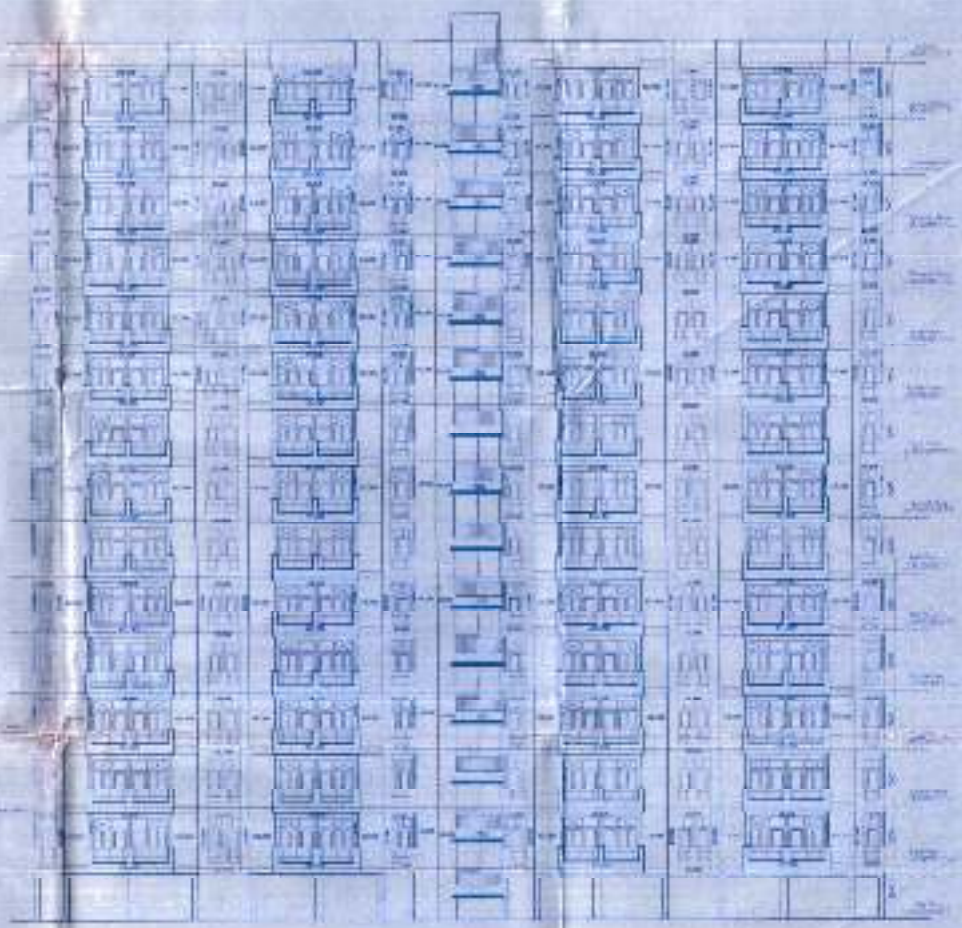

FRONT ELEVATION

PROJECT


OWNER:

M/s. [illegible] INFRASTRUCTURE PVT. LTD. AND OTHERS

DRAWING TITLE

ELEVATION & SECTION (BLOCK - F)

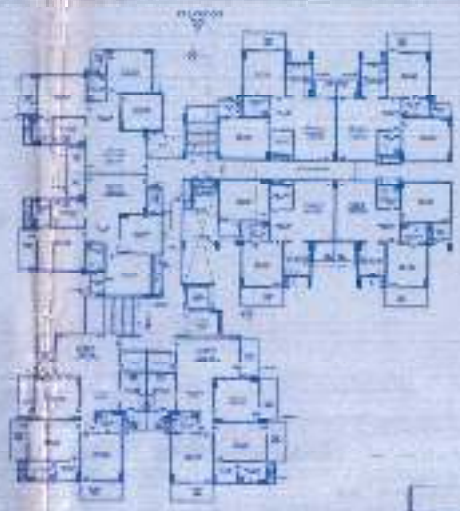

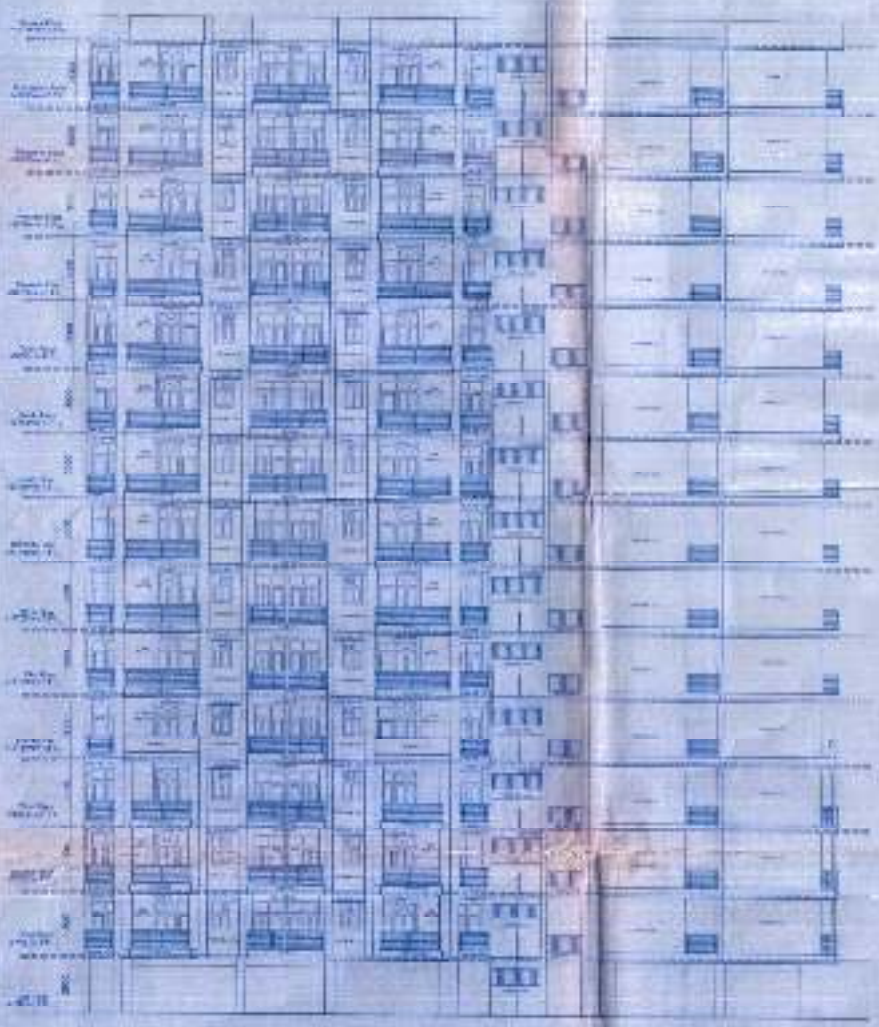

ELEVATION - X

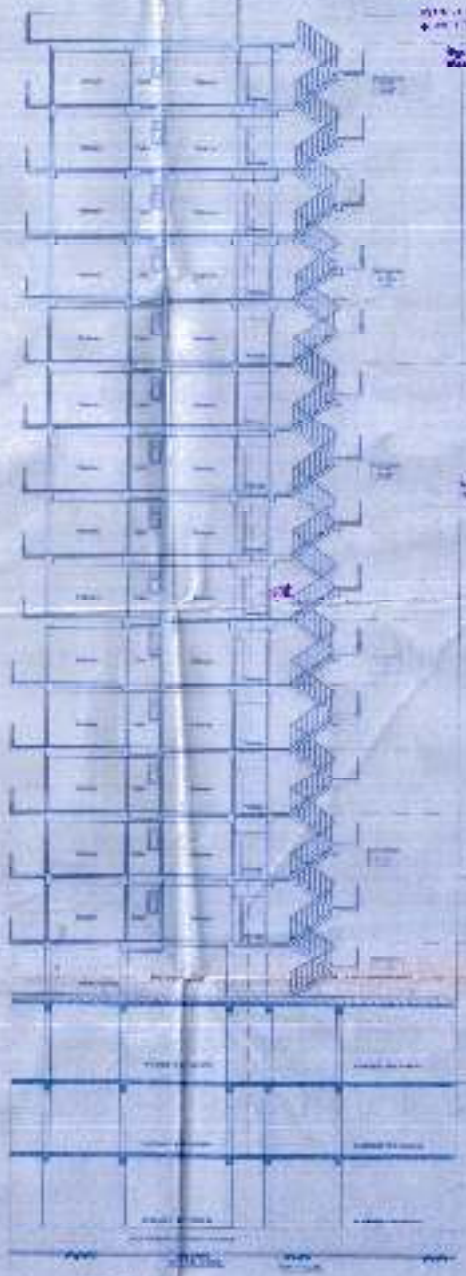

SECTION AA

PROJECT

ADDITION & ALTERATION IN SUBMISSION DRAWING FOR GROUP HOUSING "FORTUNE RESIDENCY" AT KHASRA NO. 1123 &1118 A.V. VILLAGE - NIDDRMAJRA GHAZIABAD (UP)

OWNER

M/S. VASU INFRASTRUCTURE PVT. LTD. AND OTHERS

DRAWING TITLE

ELEVATION & SECTION (BLOCK - III)

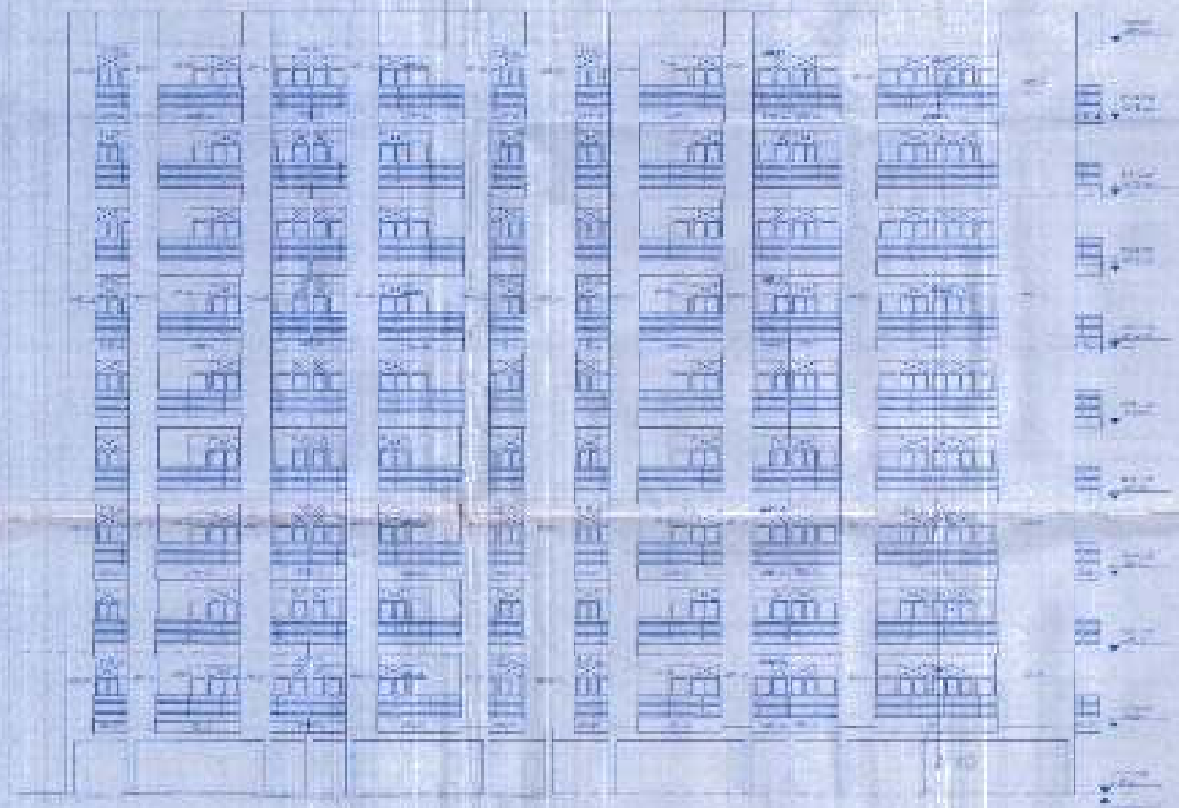

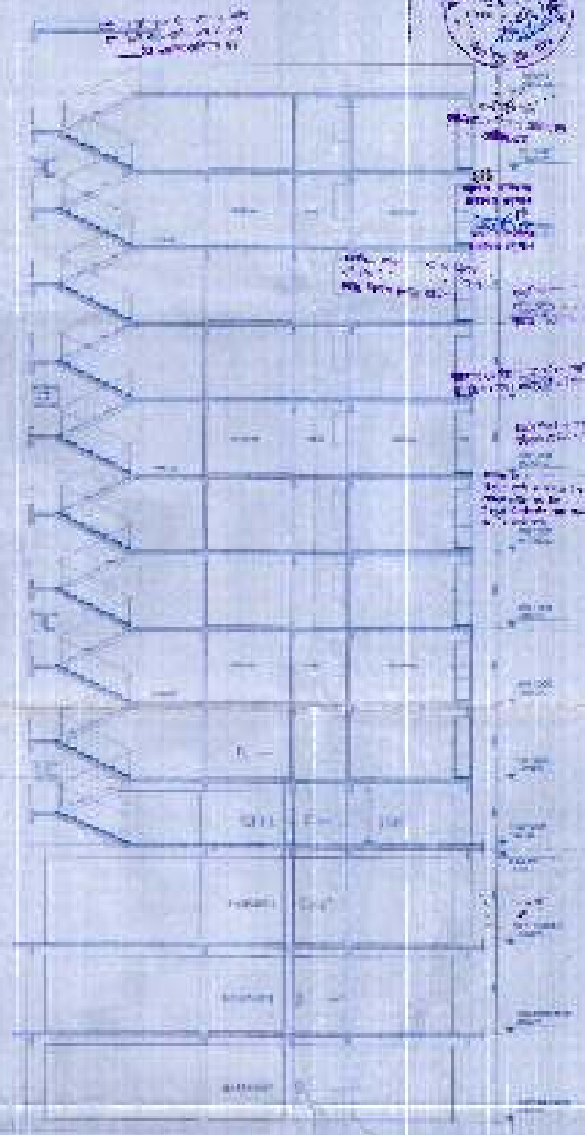

BLOCK - II
SECTION & SECTION

AS CONSTRUCTED
AS BUILT

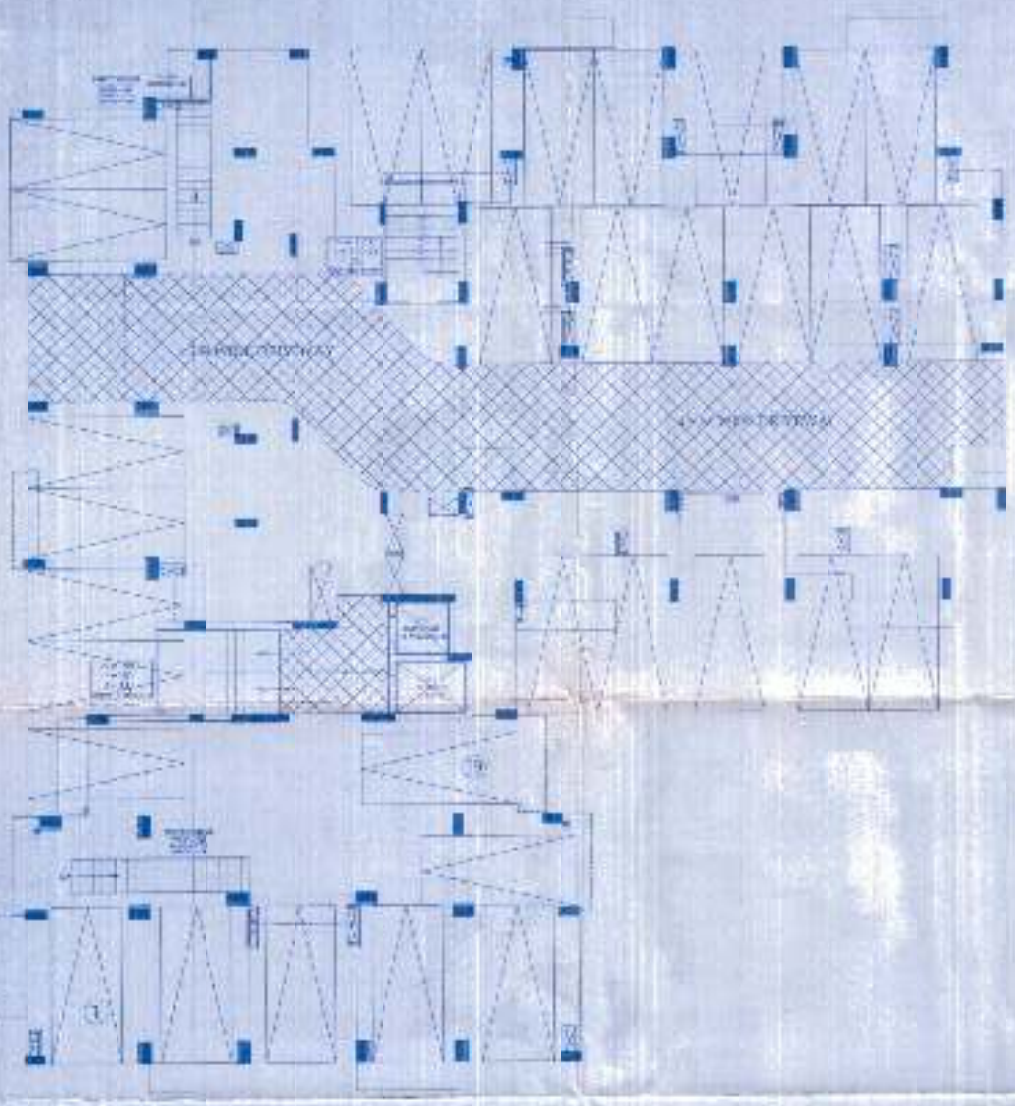

STILT PLAN
(PROPOSED)

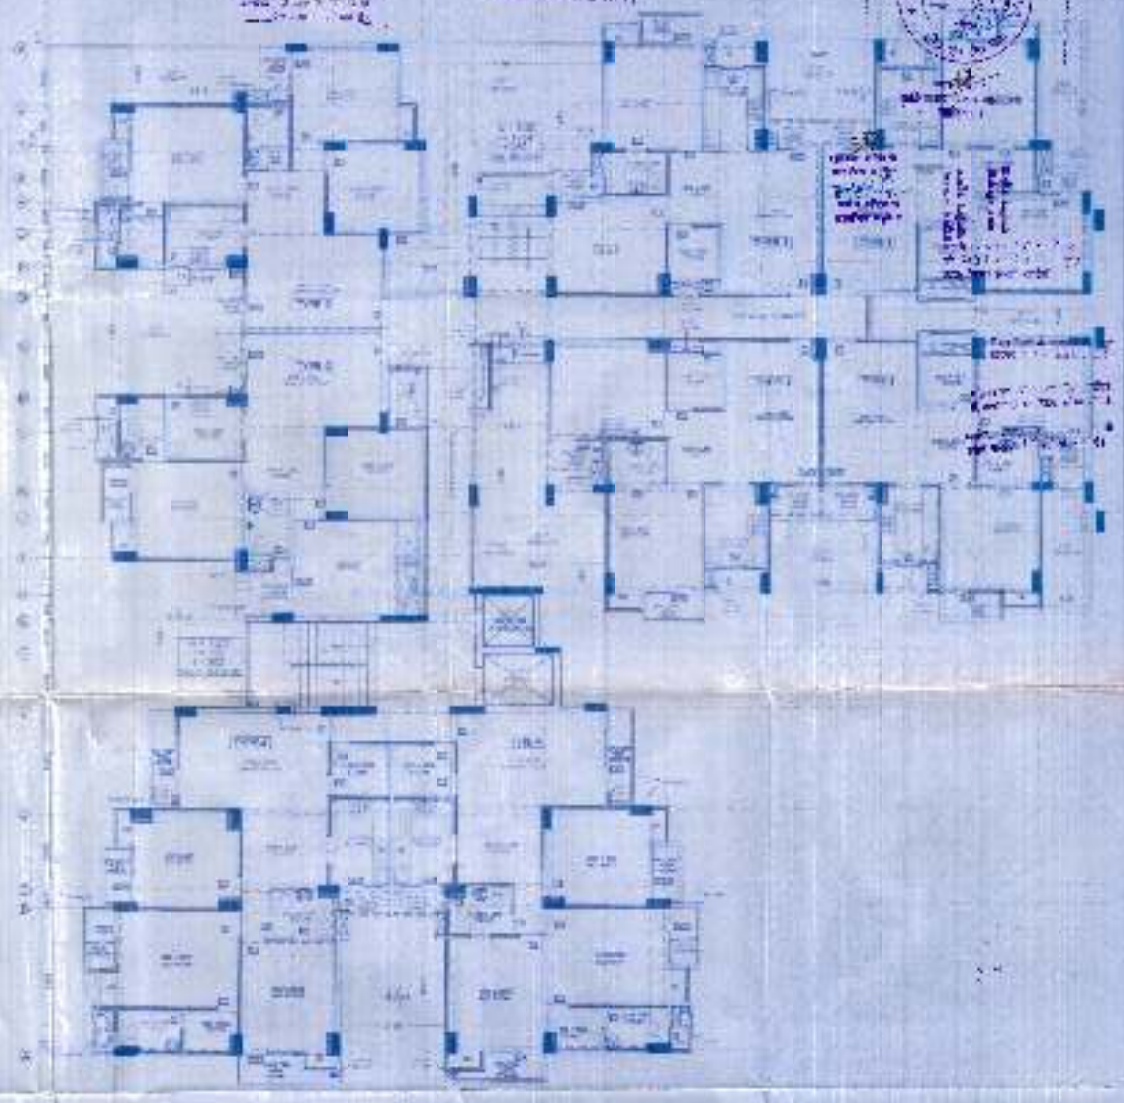

1ST FLOOR PLAN
(PROPOSED)

DRAWING SCHEDULE OF DOORS & WINDOWS

S.NO.	TYPE	SIZE (mm)	SILL (mm)	LINTEL
1	D/W1	1000 X 2100	1100 / 900	2300
2	D/W2	2200 X 2300	100 / 900	2300
3	D	1000 X 2100	100	2100
4	D1	900 X 2400	100	2100
5	D2	750 X 2100	100	2100
6	W	700 X 1200	1200	2300
7	V	600 X 1100	1200	2300
8	V1	600 X 900	1400	2300




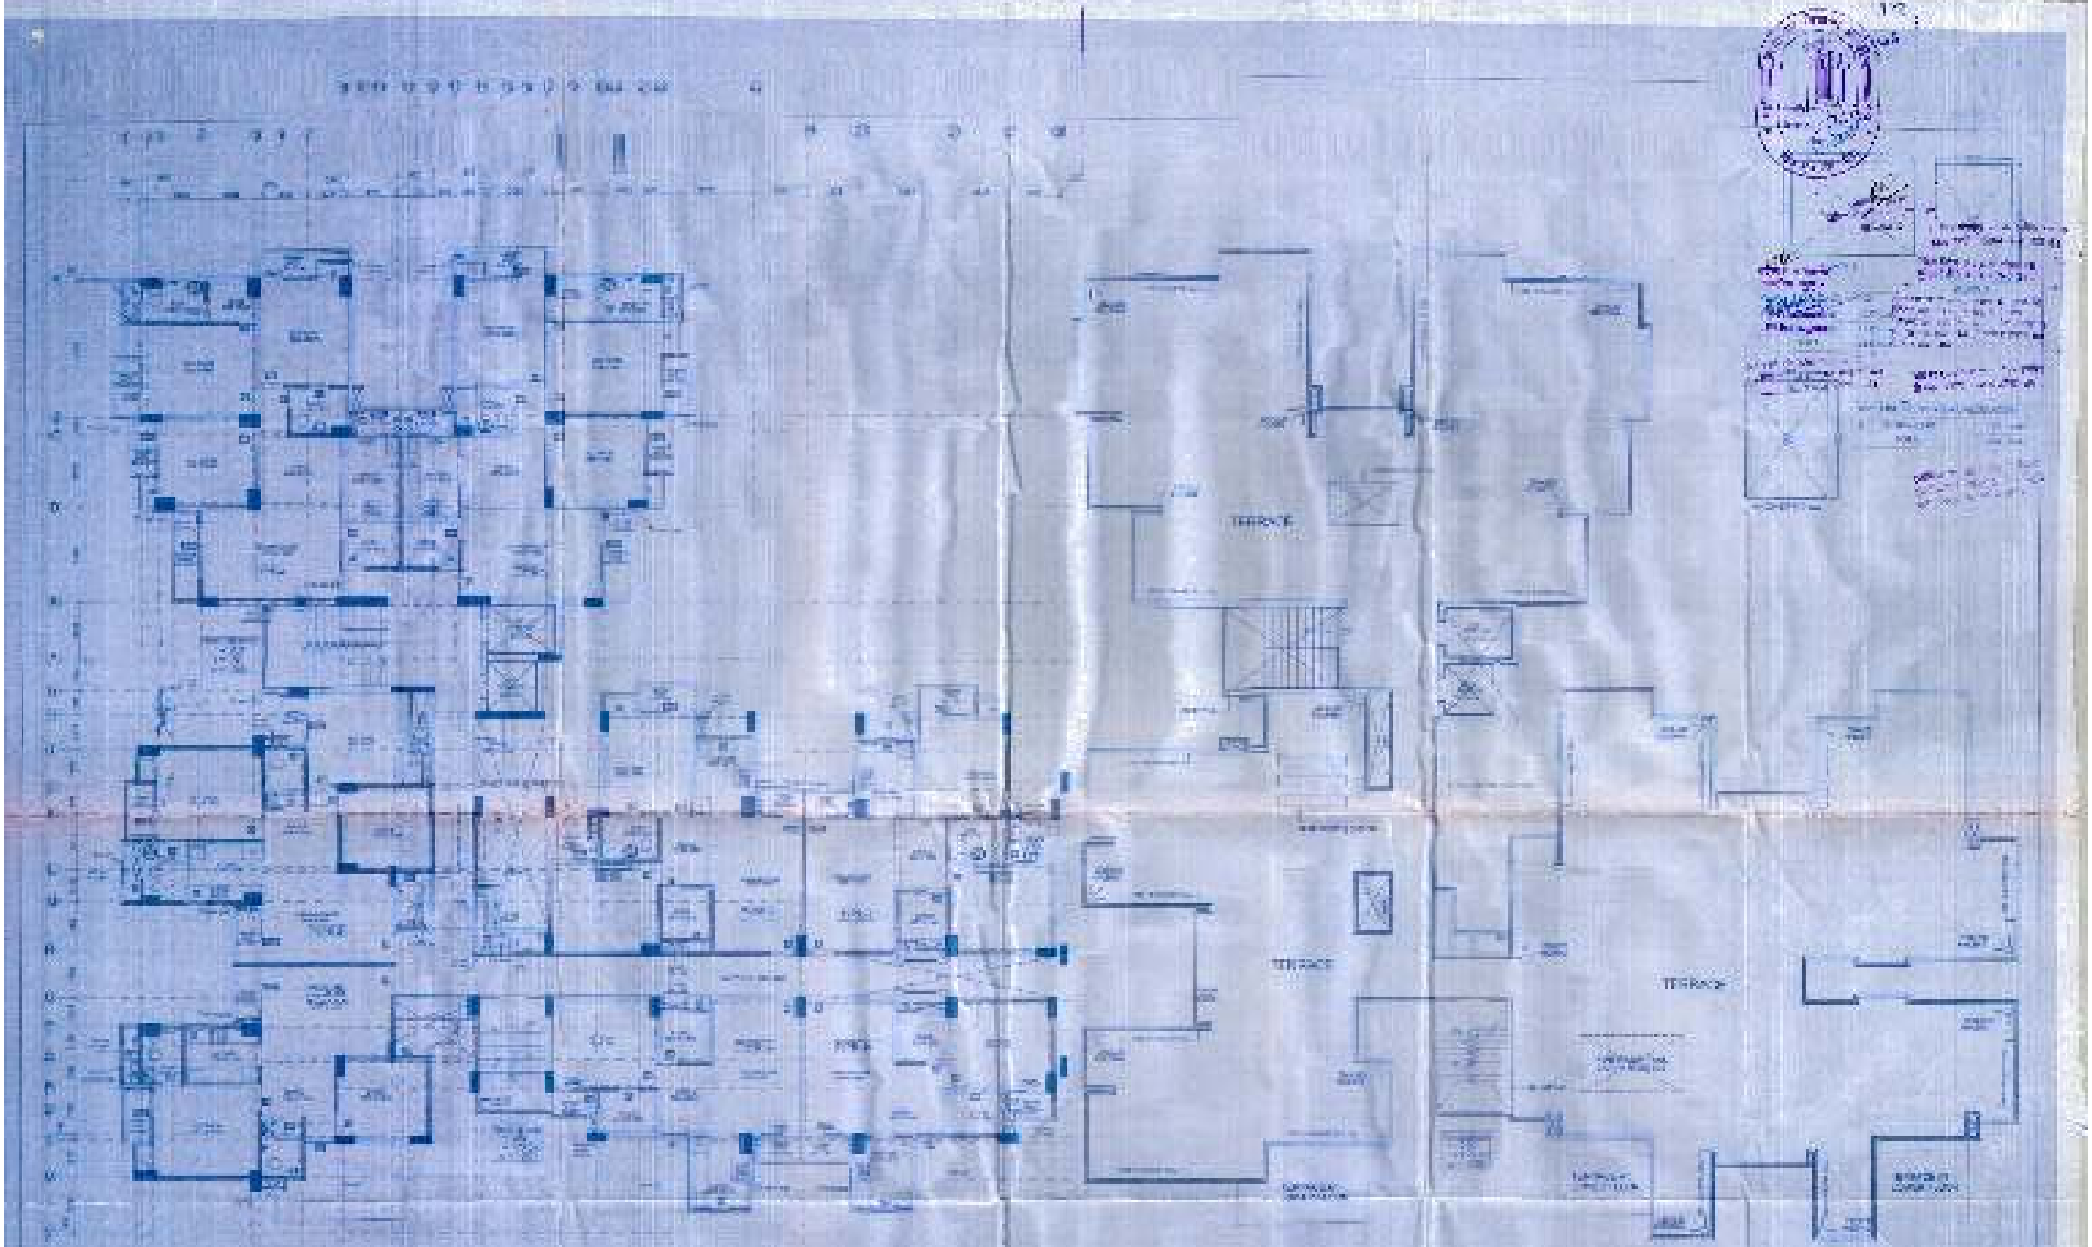

FIRST FLOOR PLAN

SECOND FLOOR PLAN

SCHEDULE OF DOORS & WINDOWS				

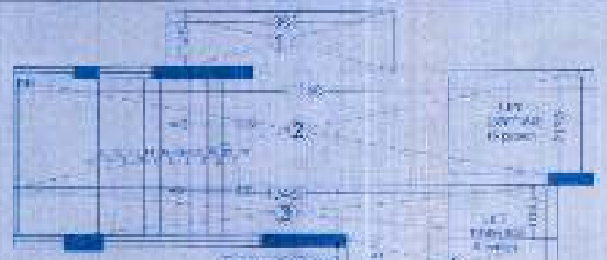

AREA STATEMENT

S.No	FLOORS	AREA (sq.m)	UNITS
1	[illegible]	903.553	
2	FIRST FLOOR	712.07	8
3	SECOND FLOOR	703.532	8
4	THIRD FLOOR	703.532	8
5	FOURTH FLOOR	703.532	8
6	FIFTH FLOOR	703.532	8
7	SIXTH FLOOR	703.532	8
8	SEVENTH FLOOR	703.532	8
9	EIGHTH FLOOR	703.532	8
10	NINTH FLOOR	703.532	8
11	TENTH FLOOR	703.532	8
12	ELEVENTH FLOOR	703.532	8
13	TWELVETH FLOOR	681.69	8
14	THIRTEENTH FLOOR	681.735	8
15	FOURTEENTH FLOOR	681.735	8
	TOTAL	[illegible]	117

CIRCULATION AREA		

1	LIFE STAIRCASE AREA	[illegible]
2	MUMTY AREA	[illegible]
3	MACHINERY/GM AREA	[illegible]

TYPE -4

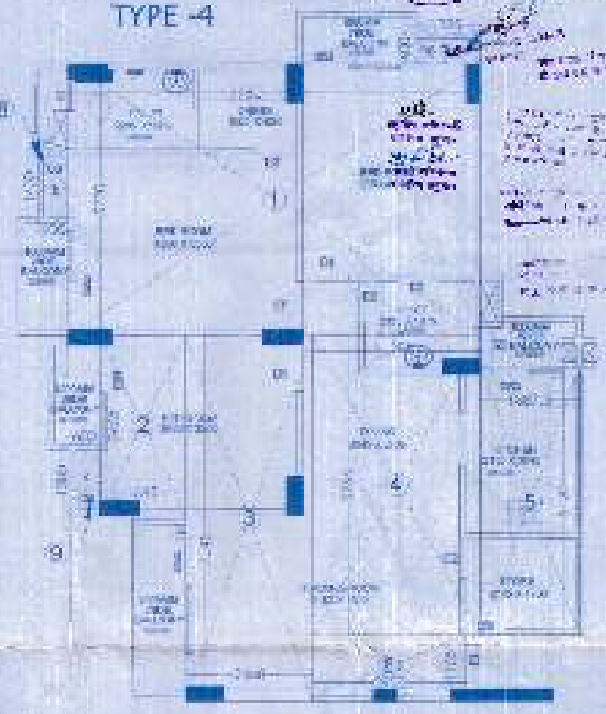

TYPE -1

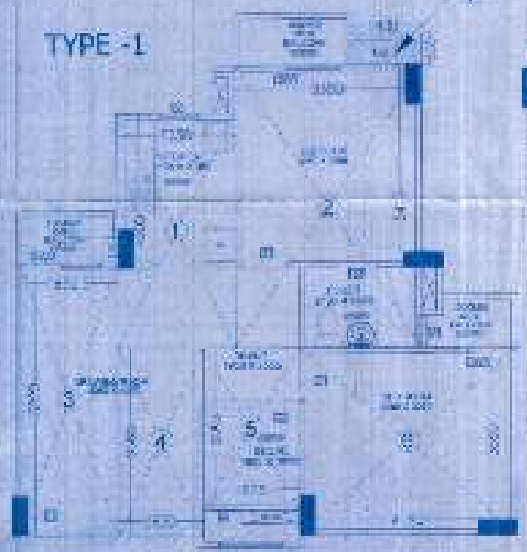

TYPE -2

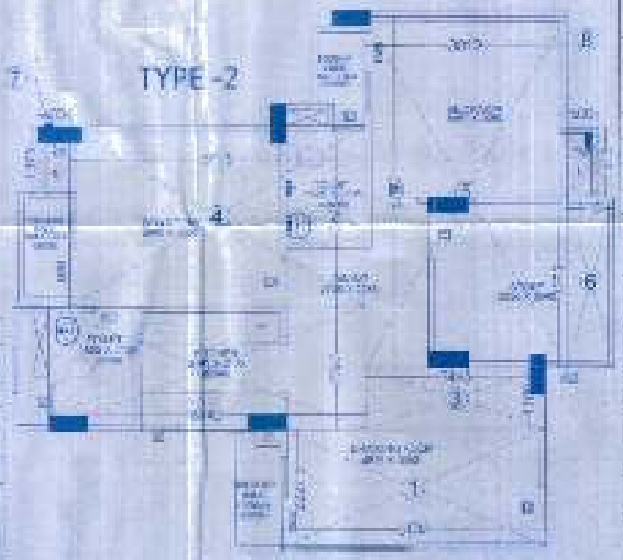










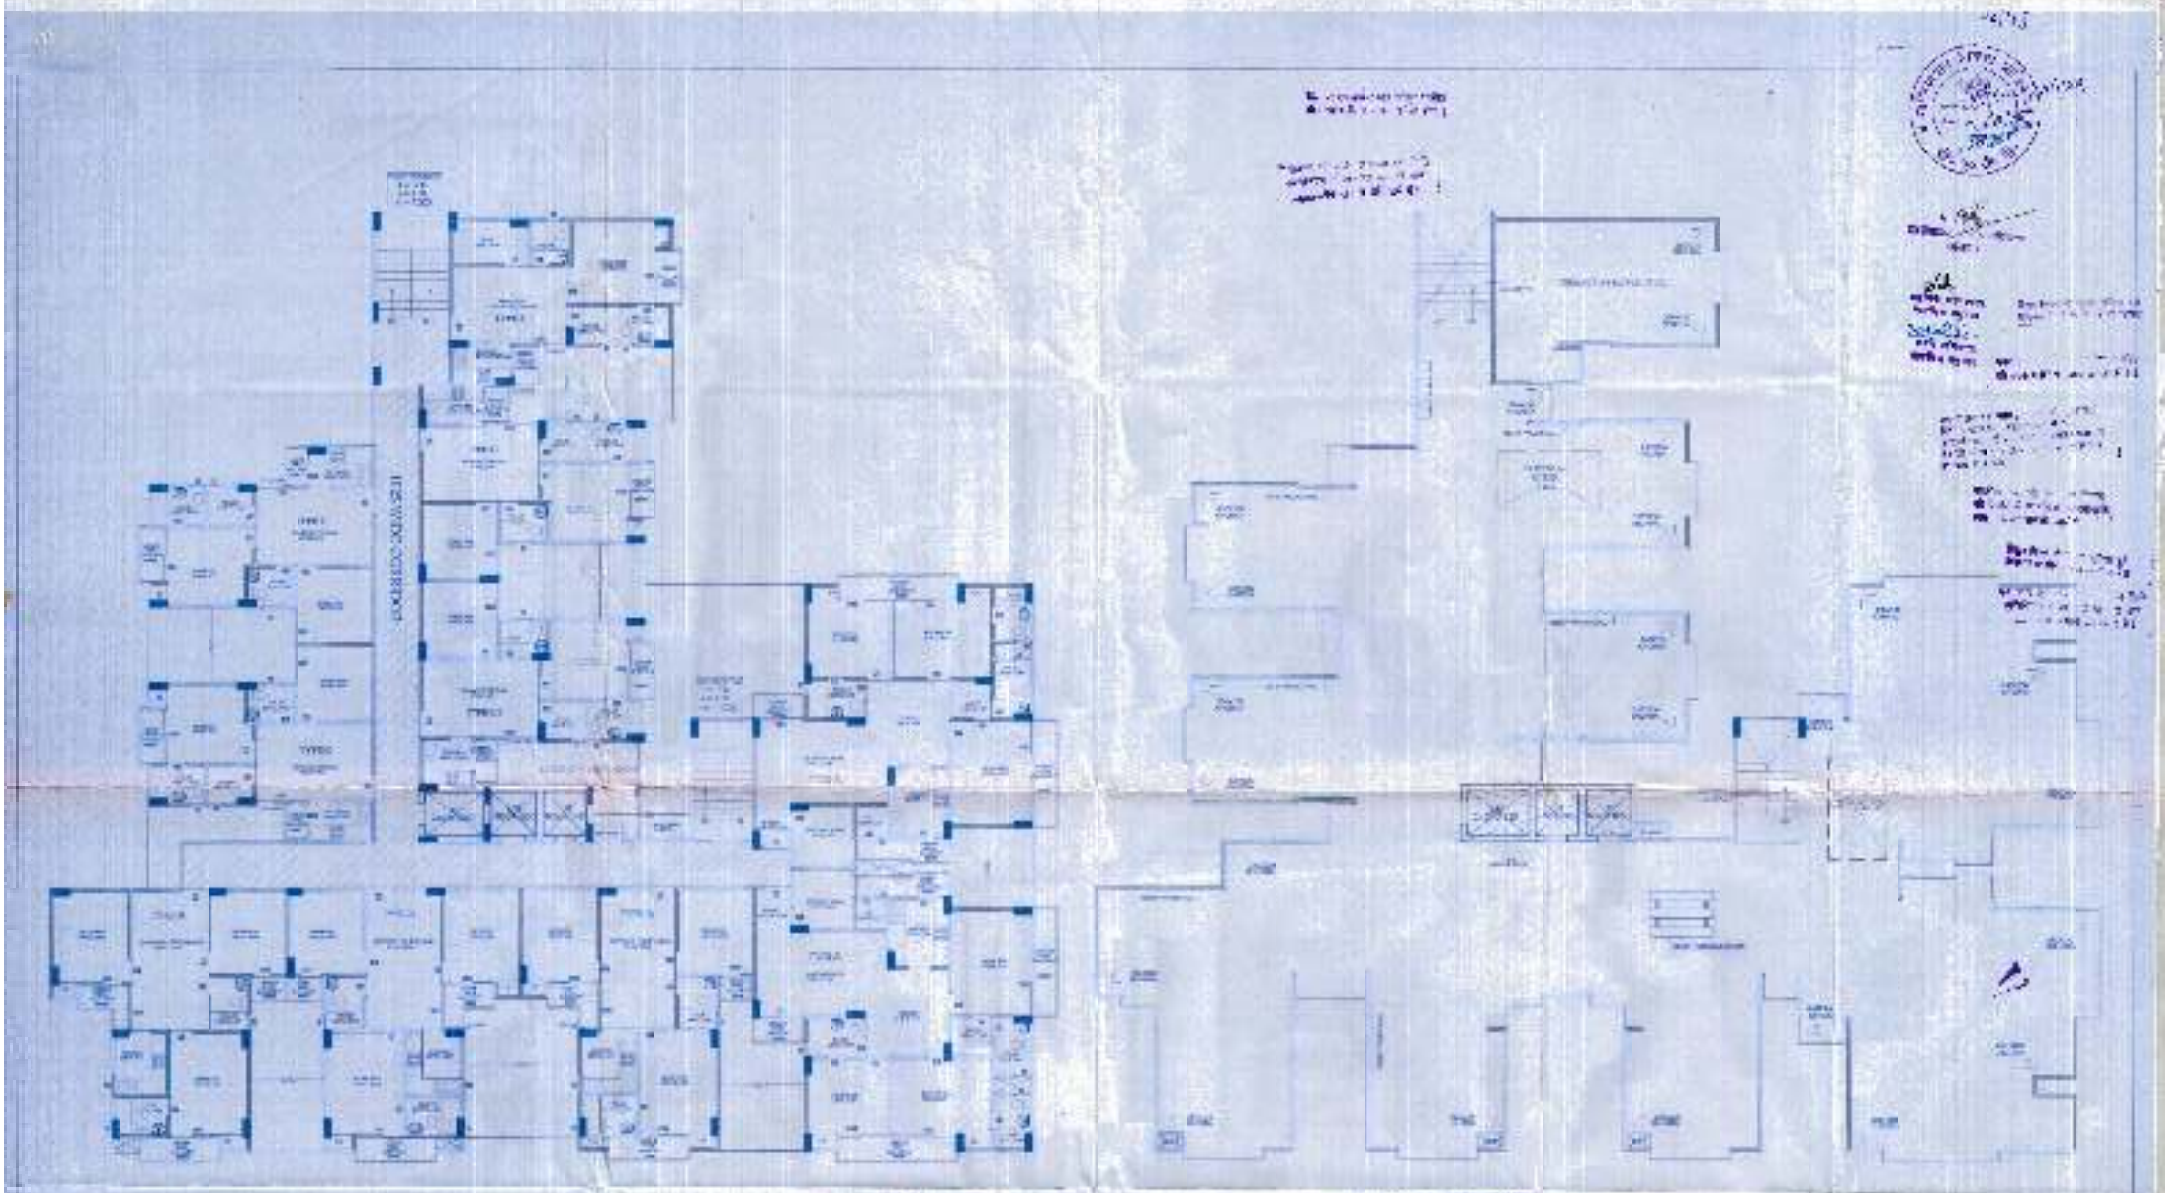

PROJECT

ACCURAY ALTERATION INTERIOR DESIGN DRAWING
FOR GROUT INCLUDING FORTUNE RESIDENCY
AT MAUJA NO. [illegible]
AT VILLAGE MOORNAGAR DIST. [illegible]

OWNER

[illegible]

DRAWING NO.

(GROUND FLOOR)
NO. [illegible] FLOOR PLAN

DRAWN BY:

CHECKED BY:

[illegible]

[illegible]

[illegible]

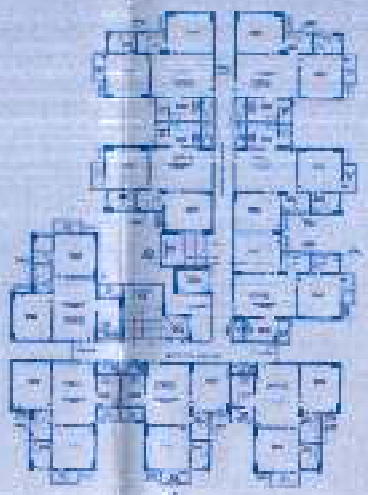

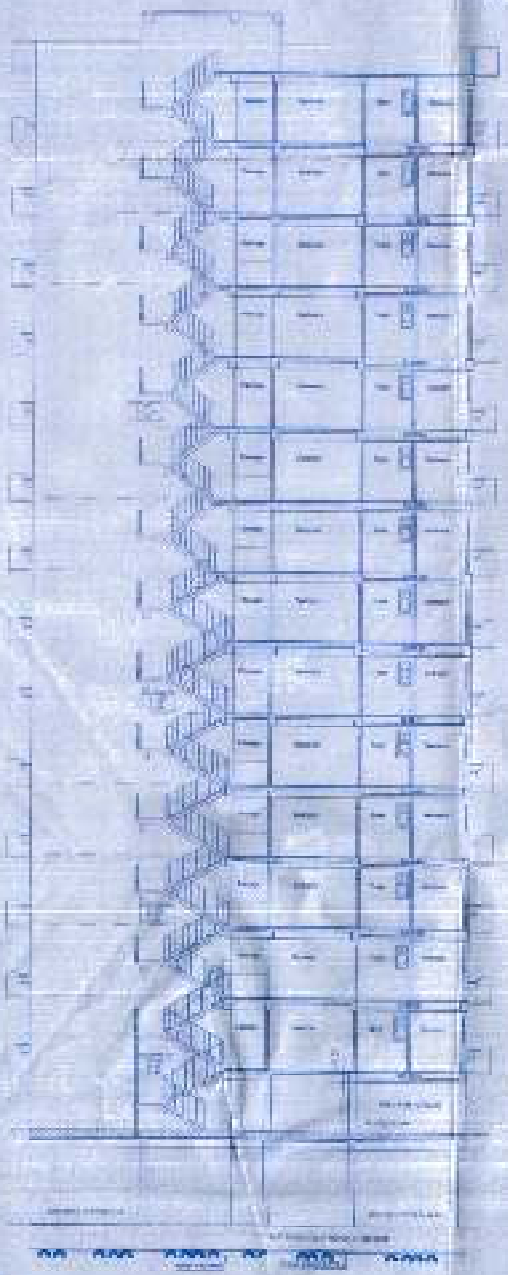

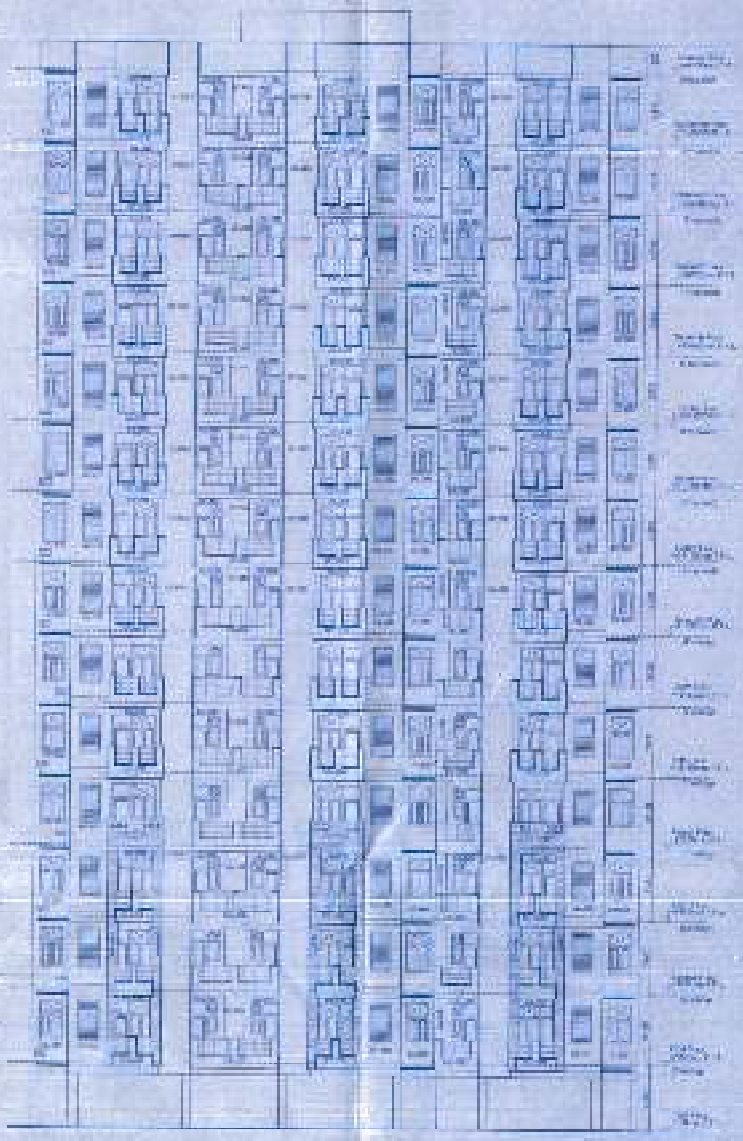

ELEVATION X

OWNER

DRAWING TITLE

ELEVATION & SECTION
(BLOCK - D)

SECTION - AA
ELEVATION - AA

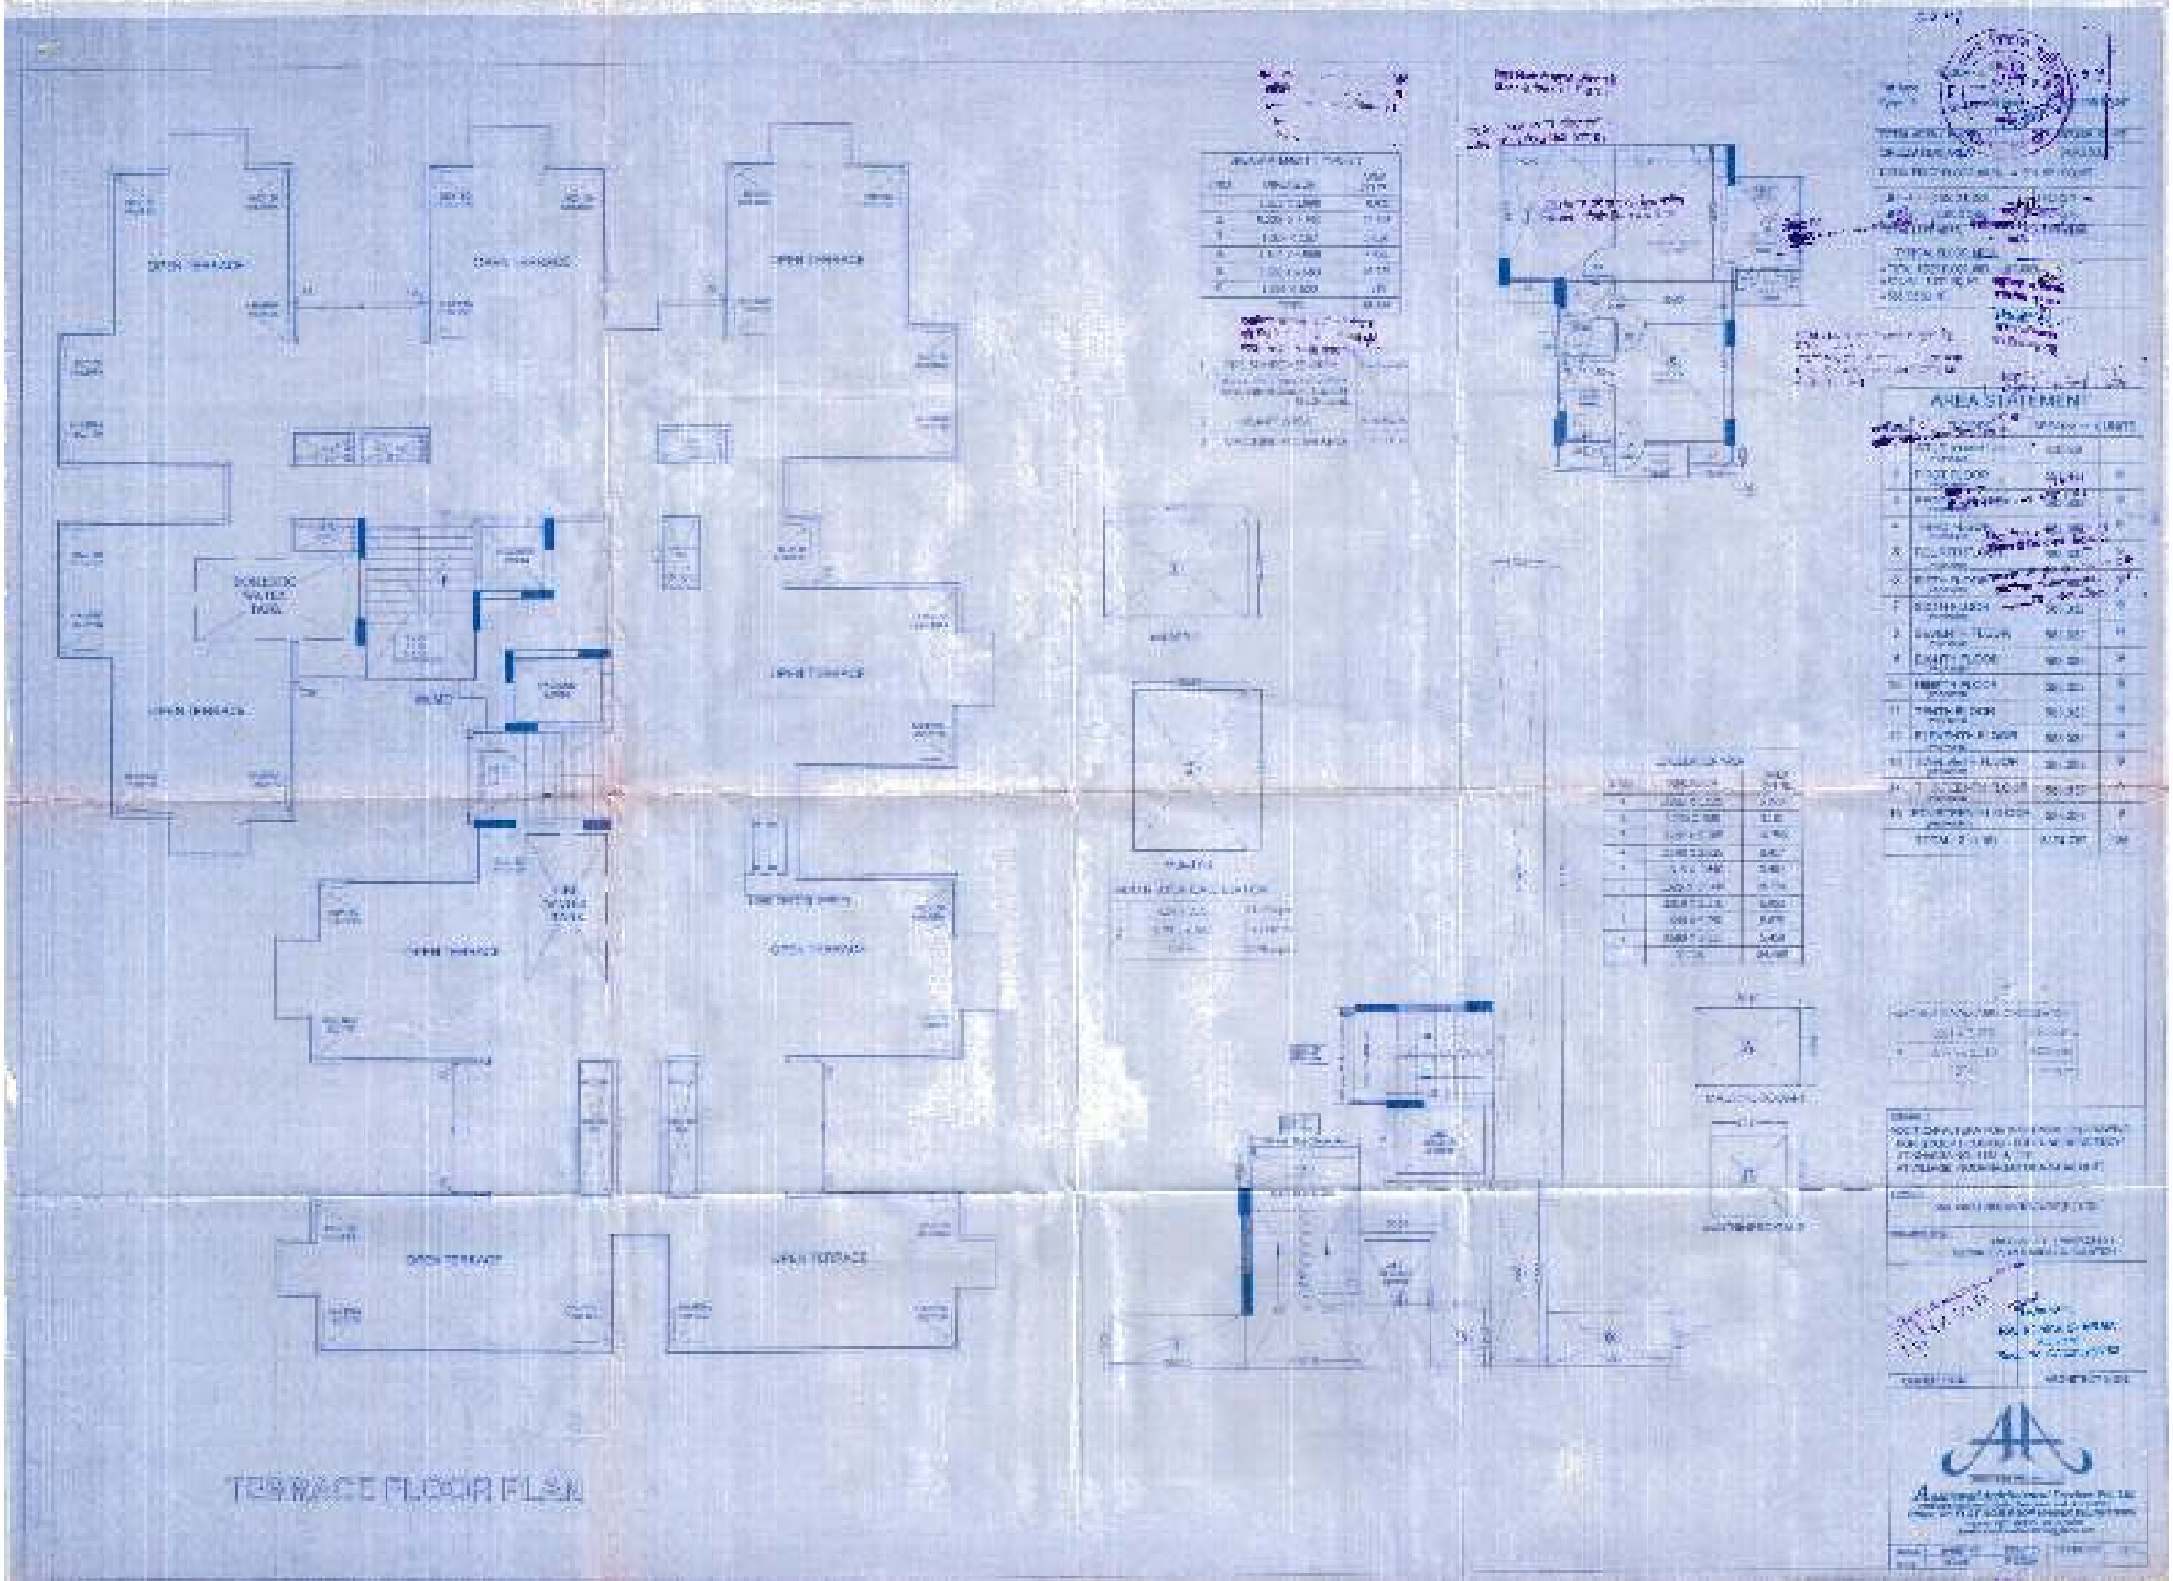
AREA STATEMEN
TERRACE FLOOR PLAN

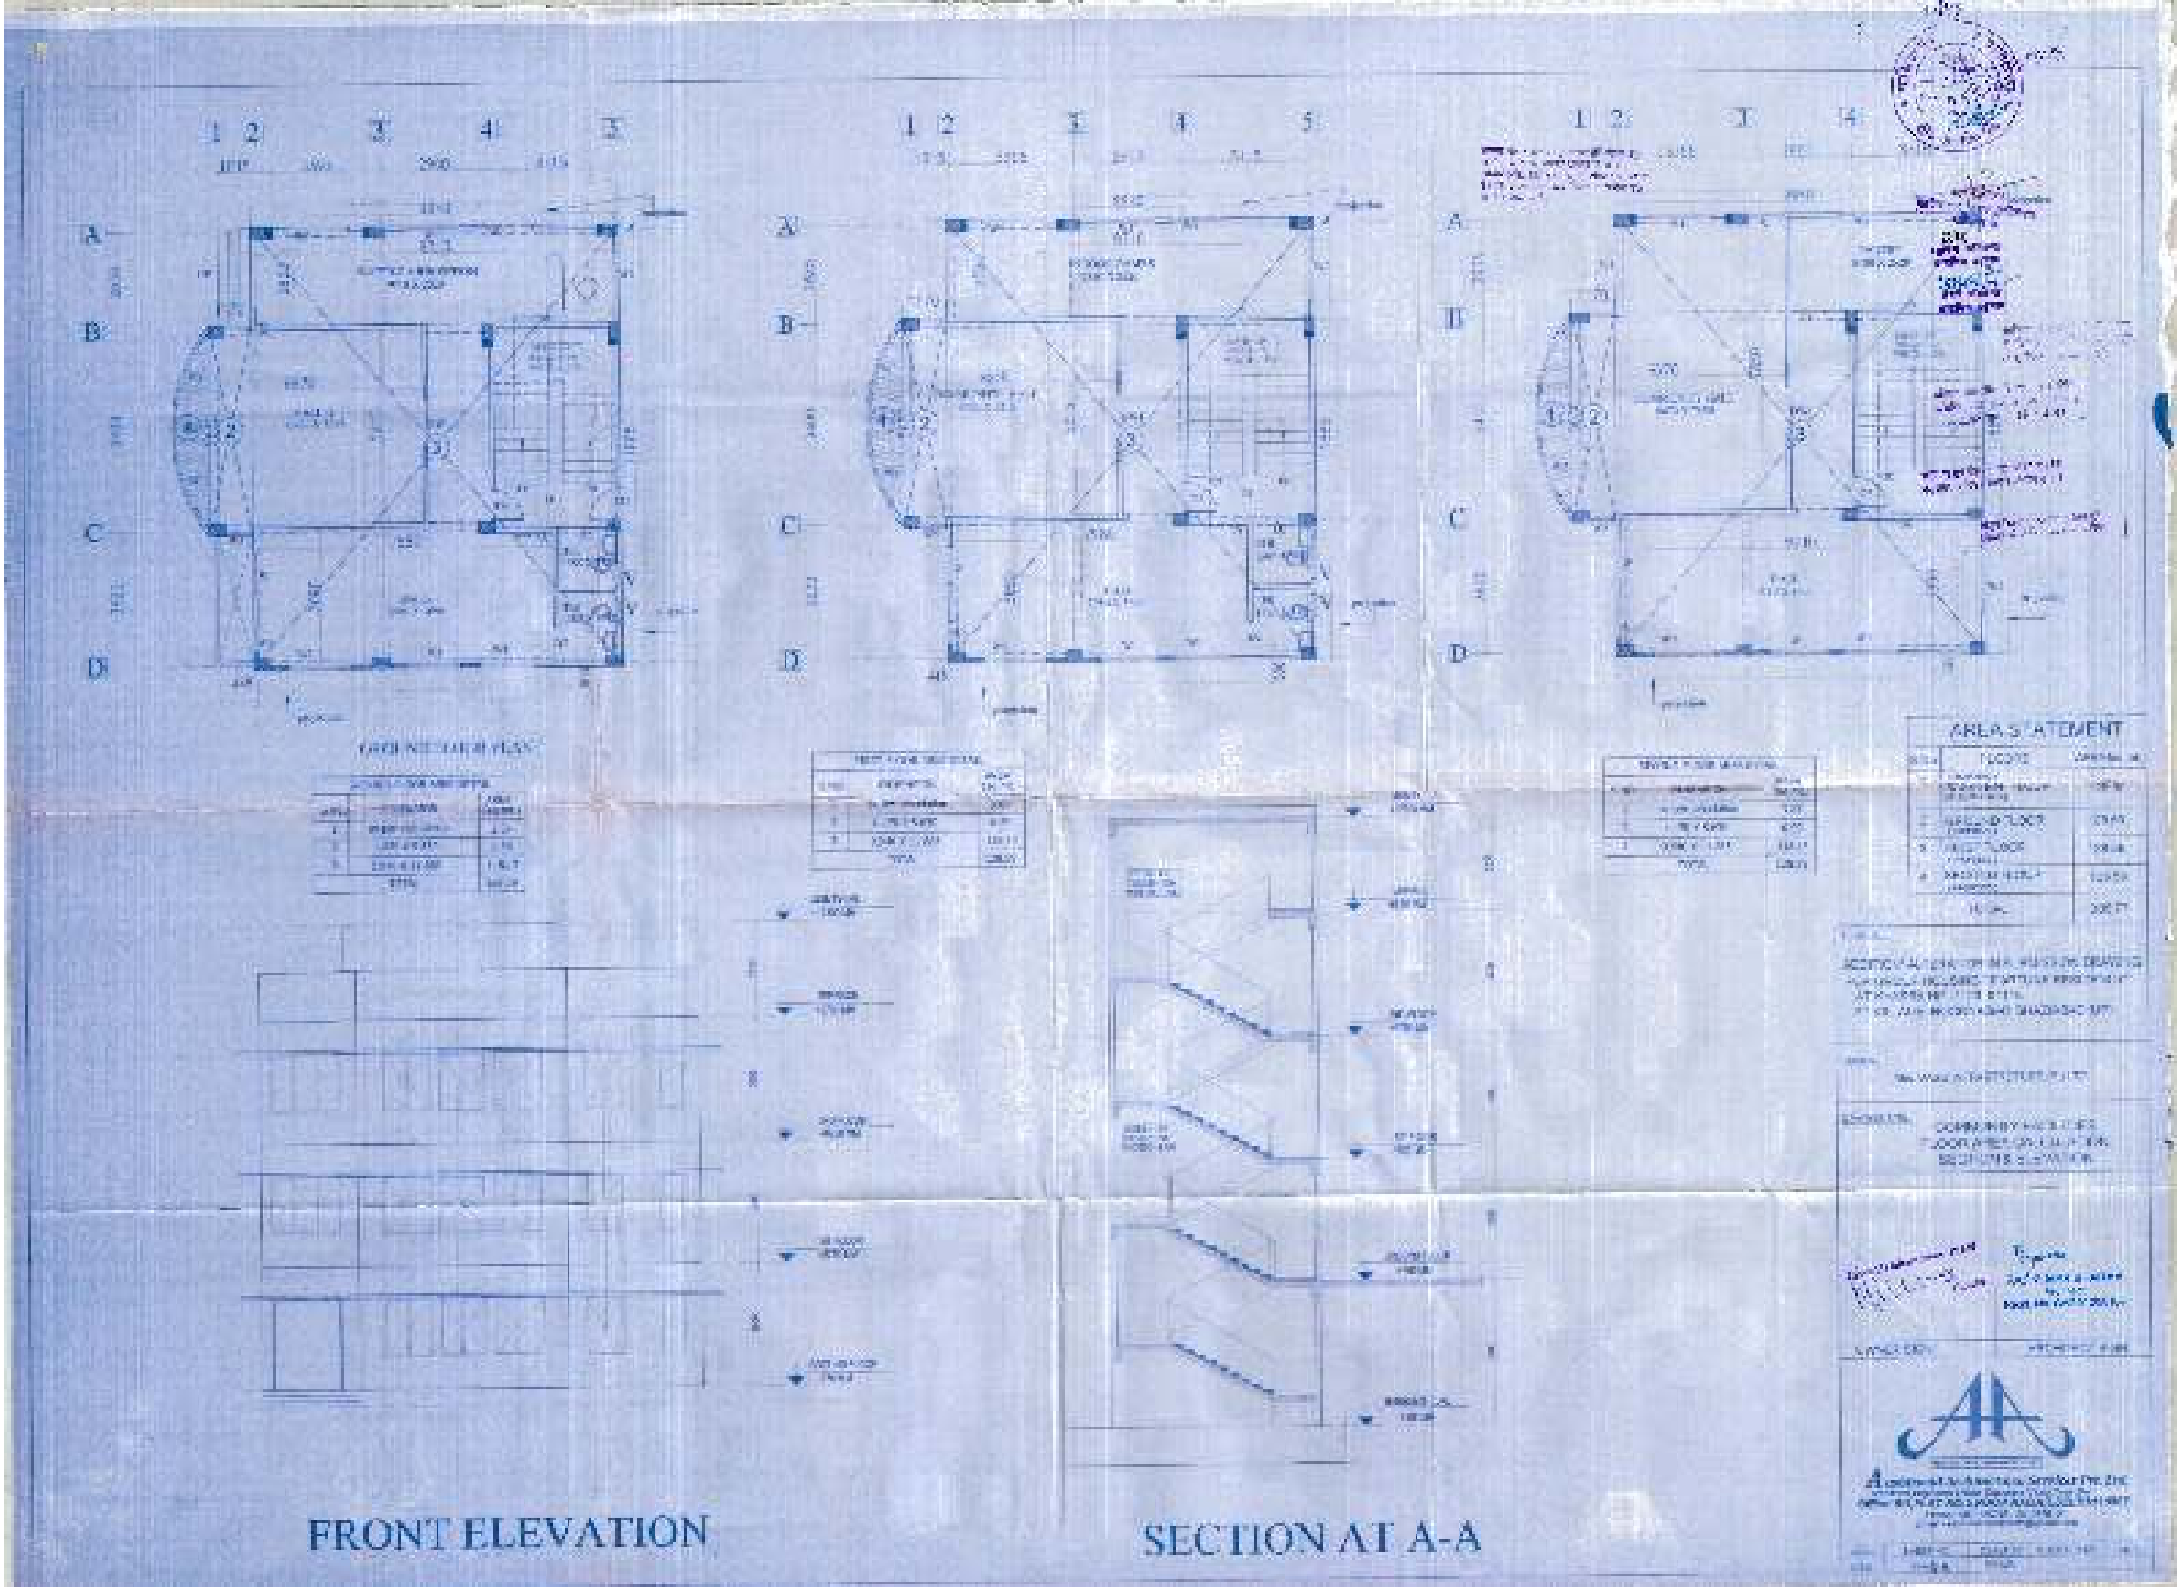
FRONT ELEVATION
SECTION AT A-A
AREA STATEMENT

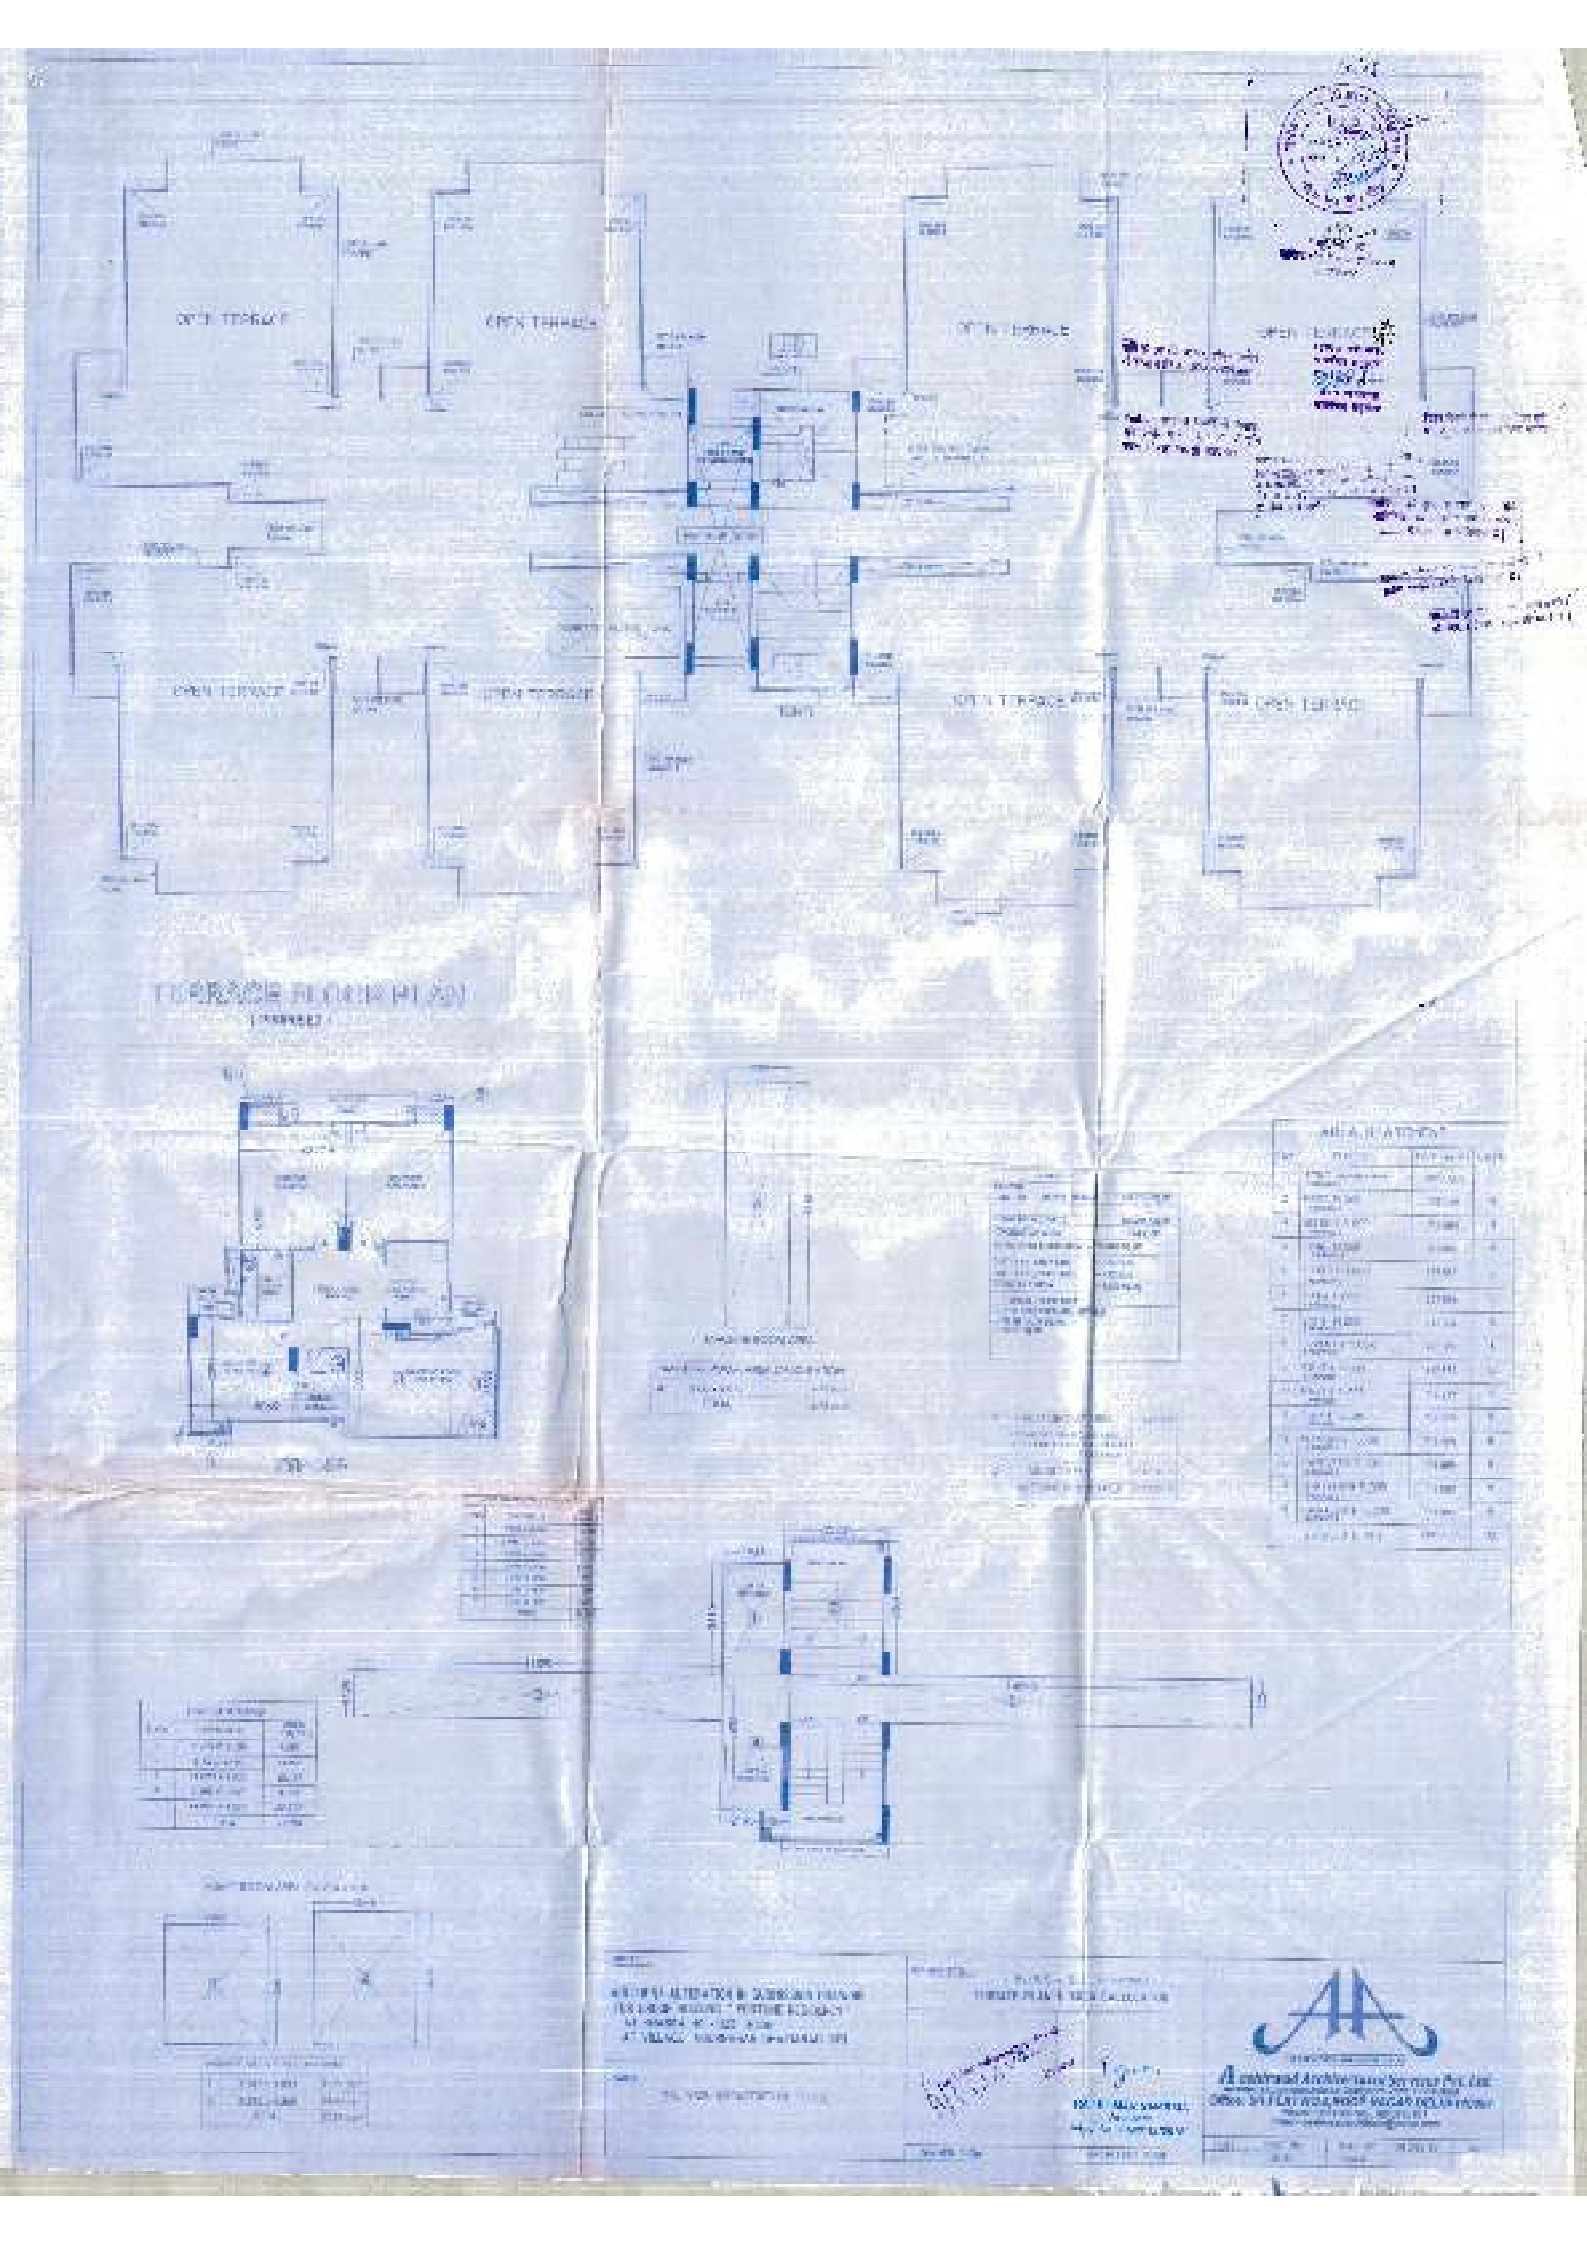
TERRACE FLOOR PLAN
AREA STATEMENT

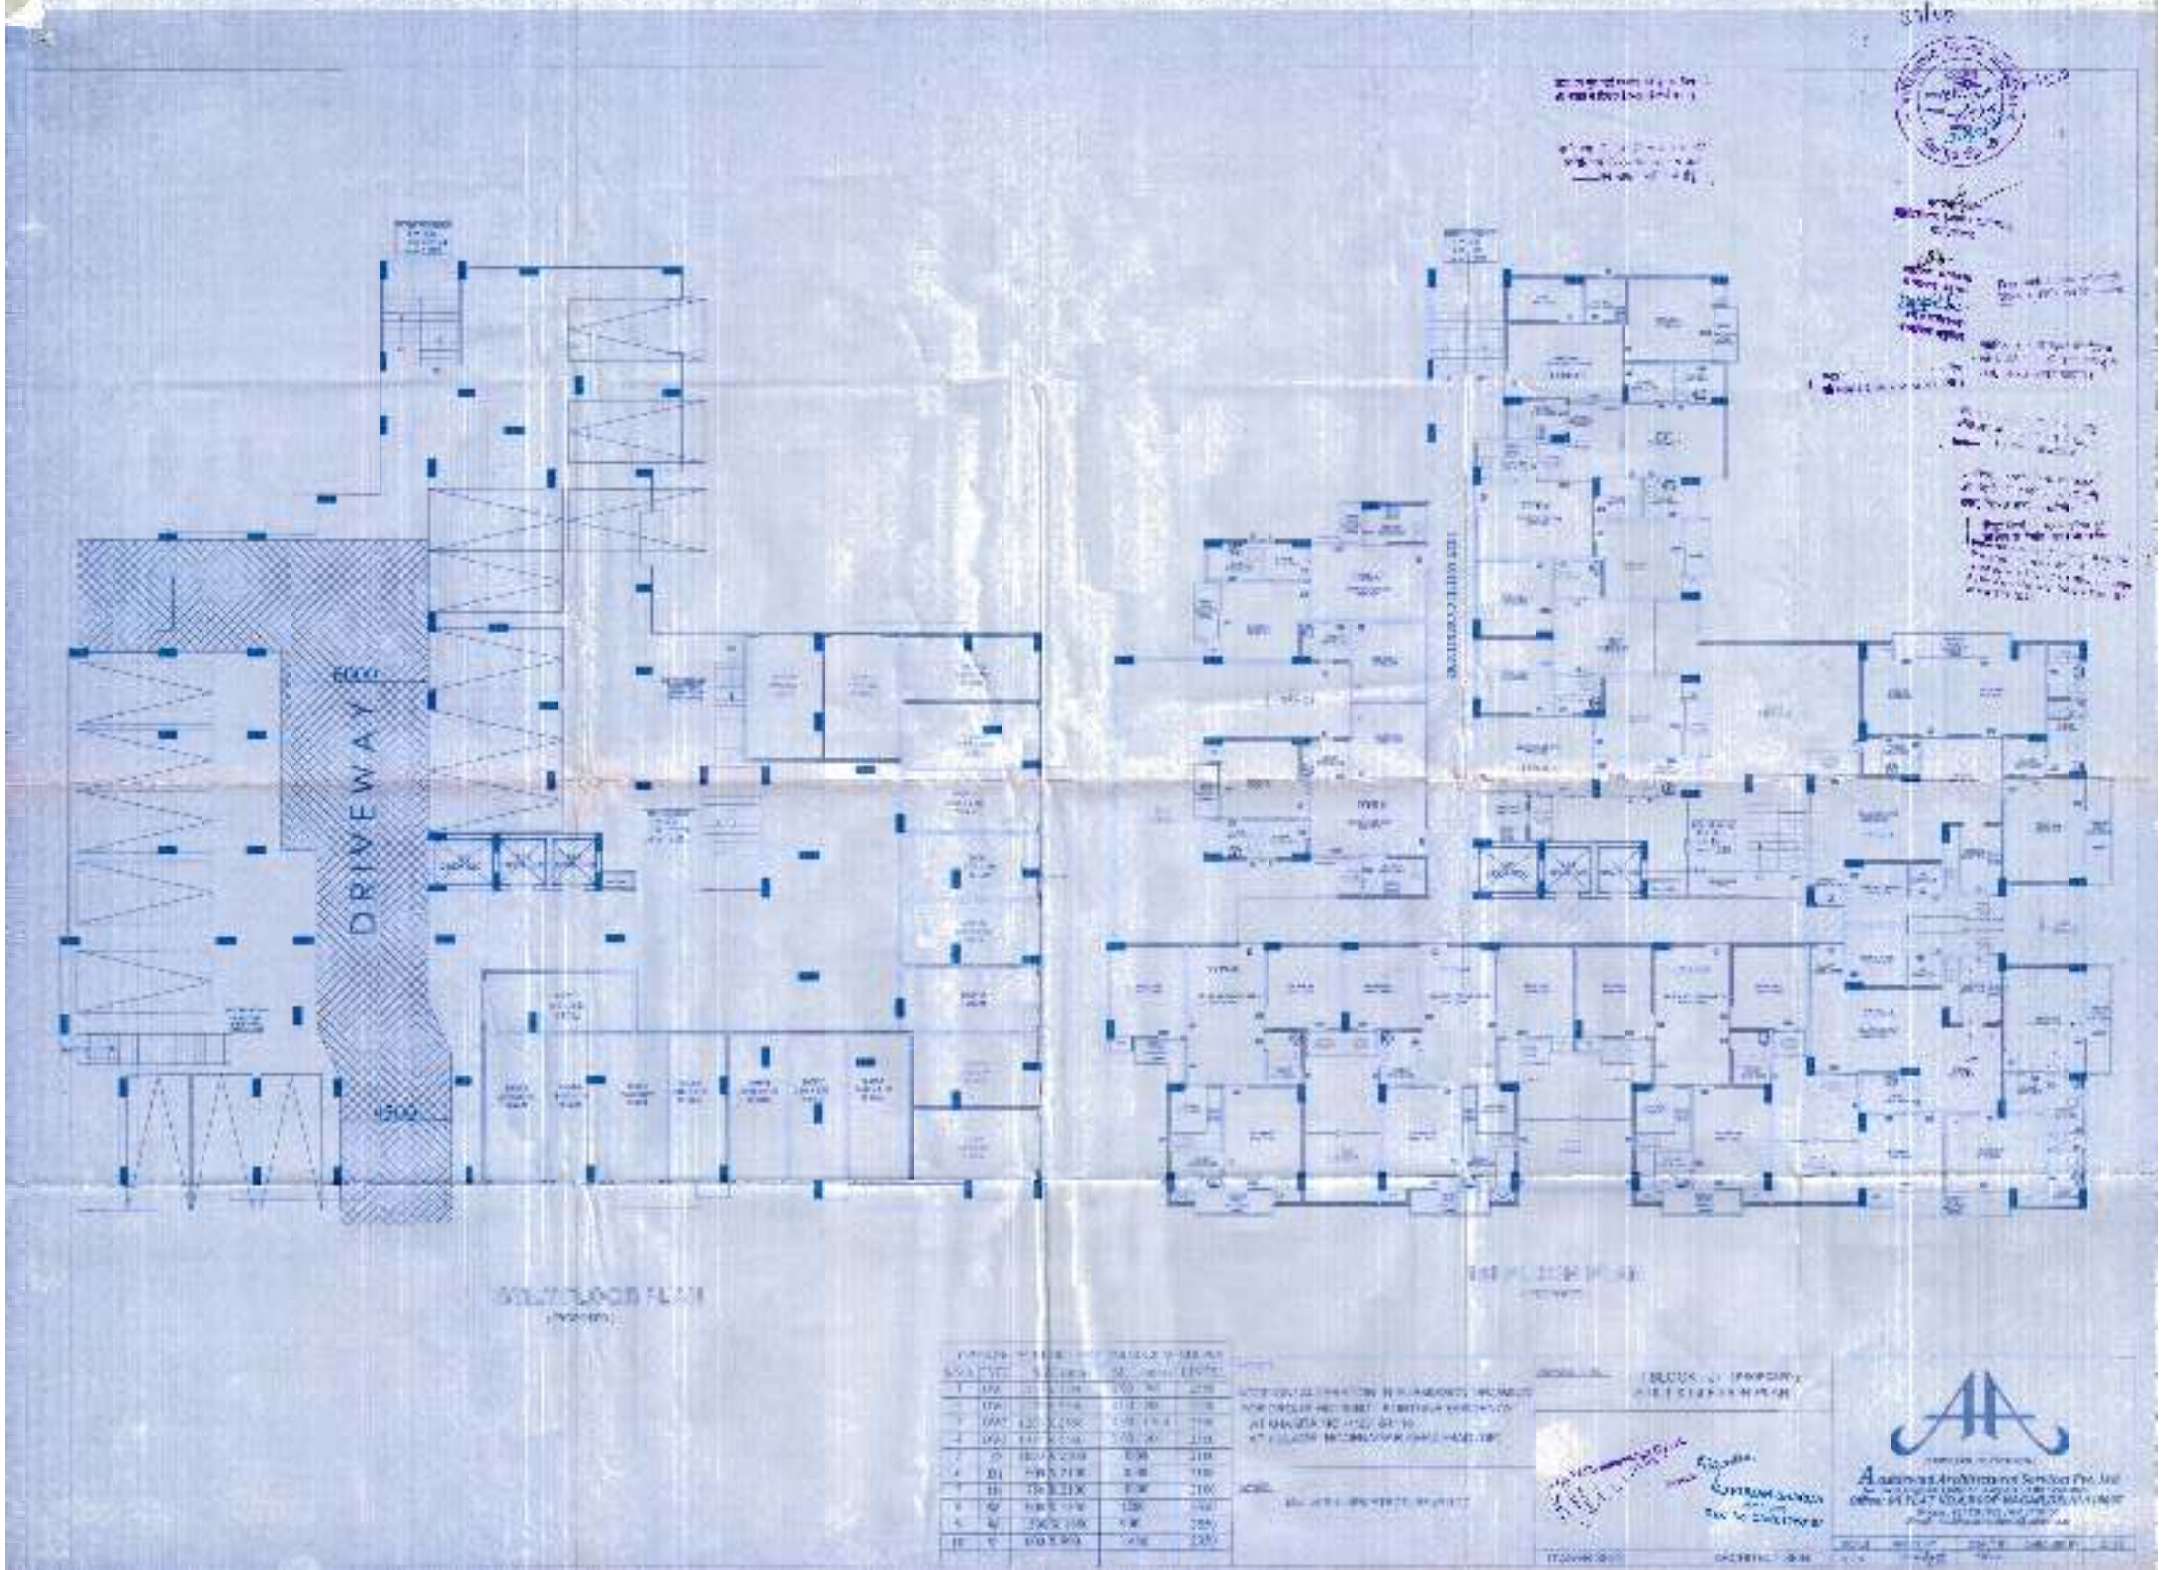
DRIVEWAY
6000
4500

AREA STATEMENT (TYPE -1)

S.NO.	DIMENSION	AREA (sq.mt.)
1.	1.525 X 3.890	5.932
2.	5.220 X 3.890	20.305
3.	1.987 X 1.67	3.035
4.	1.640 X 4.565	7.486
5.	3.580 X 4.690	16.794
6.	1.365 X .600	.819
	TOTAL	56.371

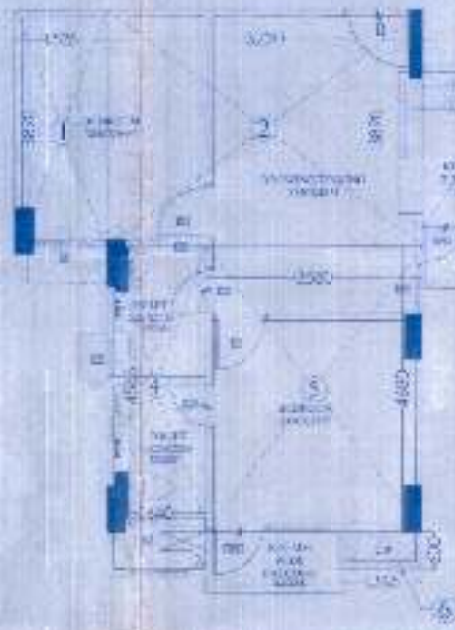

BLOCK - 2

Flat Area

Type - 3 | 56.334 | 09 Nos. | 507.006 SQ.MT

TOTAL AREA (FLATS) 507.006 SQ.MT

CIRCULATION AREA DEMOLISH

TOTAL UPP. GROUND FLOOR AREA 591.471 SQ.MT

TOTAL STILT FLOOR AREA(W/W FLAT) 591.471 SQ.MT

LIFT (A) 4.717 sq.m

LIFT (B) 4.717 sq.m

TOTAL LIFT AREA 9.434 sq.mt

FIRST FLOOR AREA

= TOTAL UPPER GROUND FLOOR AREA - LIFT AREA

= 591.471 - 9.434 SQ.MT

= 582.036 SQ.MT.

FIRE STAIRCASE AREA

TOTAL FIRE STAIRCASE AREA

2. MUMTY AREA

3. MACHINEROOM AREA

CIRCULATION AREA

S.NO.	DIMENSION	AREA (sq.mt.)
1.	3.862 X 1.525	5.939
2.	3.230 X .965	3.131
3.	3.287 X 5.185	16.780
4.	2.195 X 3.835	8.417
5.	1.515 X 1.640	2.484
6.	1.325 X 17.440	26.506
7.	3.010 X 2.310	6.953
8.	1.640 X 5.390	8.835
9.	3.580 X 1.525	5.459
	TOTAL	84.485

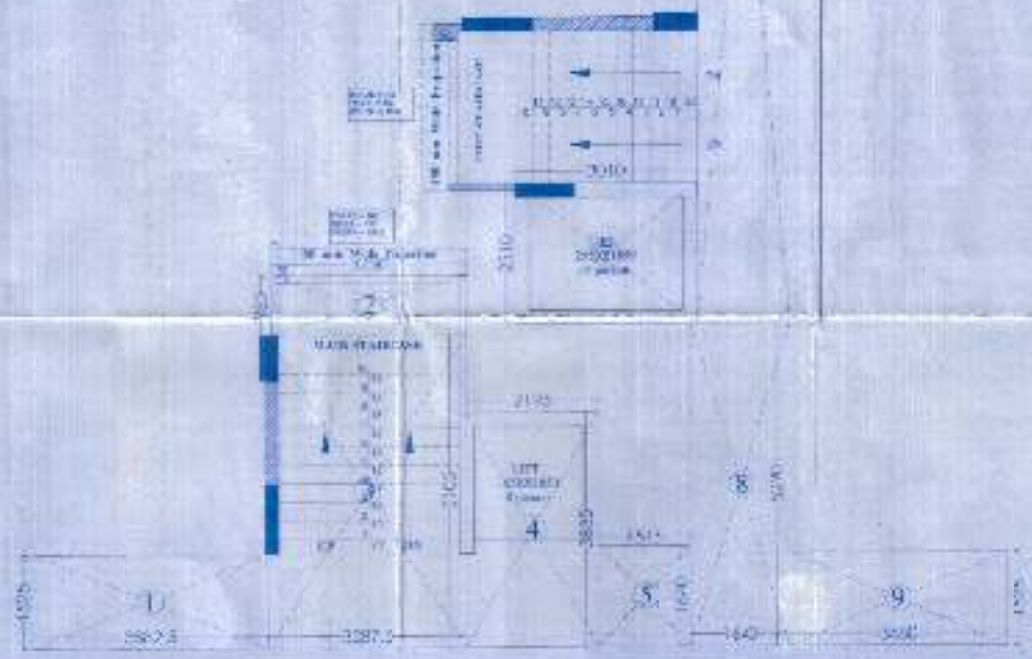

AREA STATEMENT

S.No.	FLOORS	AREA in sq.m	UNITS
1	STILT FLOOR	591.471	
2	FIRST FLOOR	[illegible]	9
3	SECOND FLOOR	[illegible]	9
4	THIRD FLOOR	[illegible]	9
5	FOURTH FLOOR	[illegible]	9
6	FIFTH FLOOR	[illegible]	9
7	SIXTH FLOOR	[illegible]	9
8	SEVENTH FLOOR	[illegible]	9
9	EIGHTH FLOOR	[illegible]	9
10	NINTH FLOOR	[illegible]	9
11	TENTH FLOOR	[illegible]	9
12	ELEVENTH FLOOR	[illegible]	9
13	TWELVE TH FLOOR	[illegible]	9
14	THIRTEENTH FLOOR	[illegible]	9
15	FOURTEENTH FLOOR	[illegible]	9
	TOTAL AREA	517.707	135

OWNER:

[illegible]

NAME:

M/S VASUDHA INFRASTRUCTURE PVT. LTD. AND OTHERS

ARCHITECT:

[illegible]

PARTNER:

ARCHITECTS:

[illegible]

Aaswad Architectural Services Pvt. Ltd.

[illegible]

[illegible]

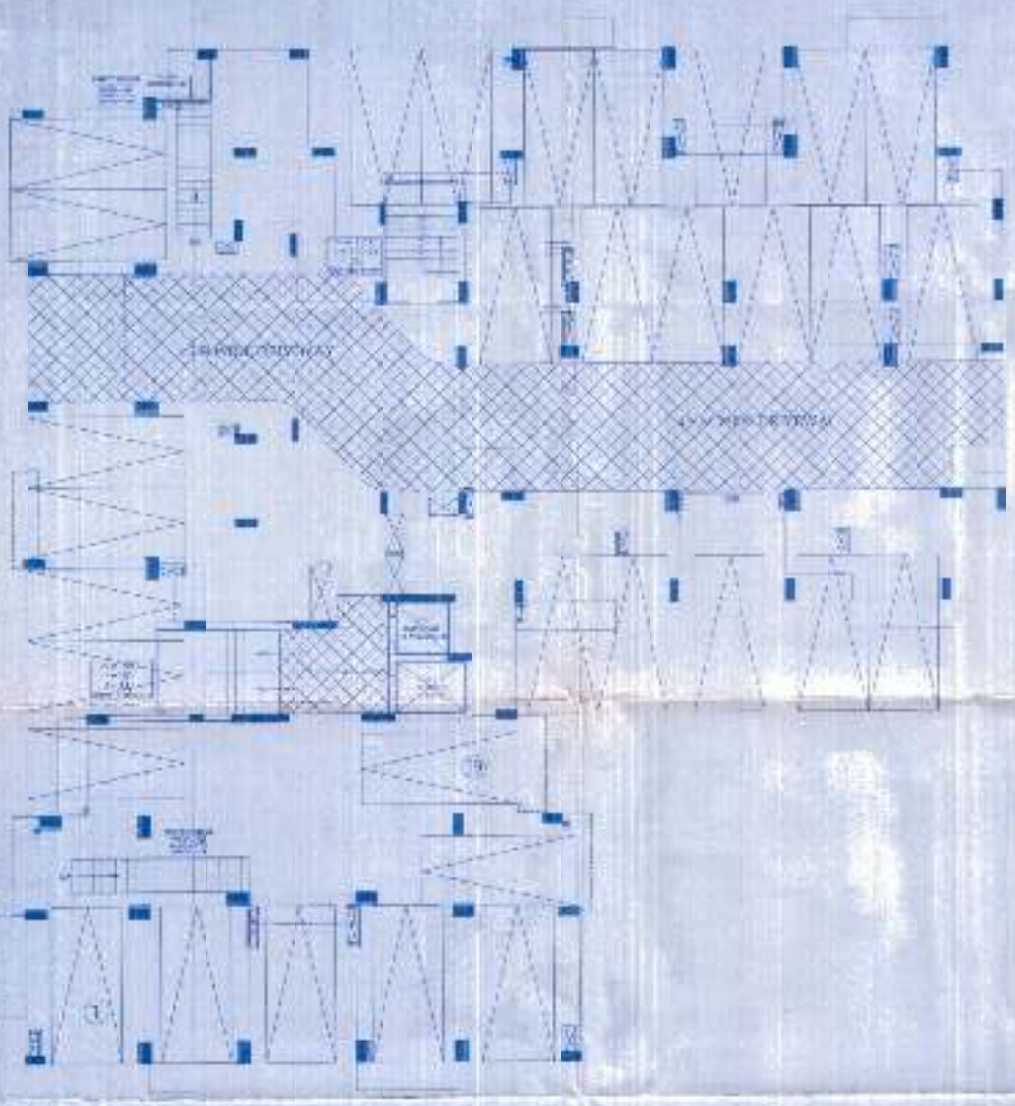

STILT PLAN
(PROPOSED)

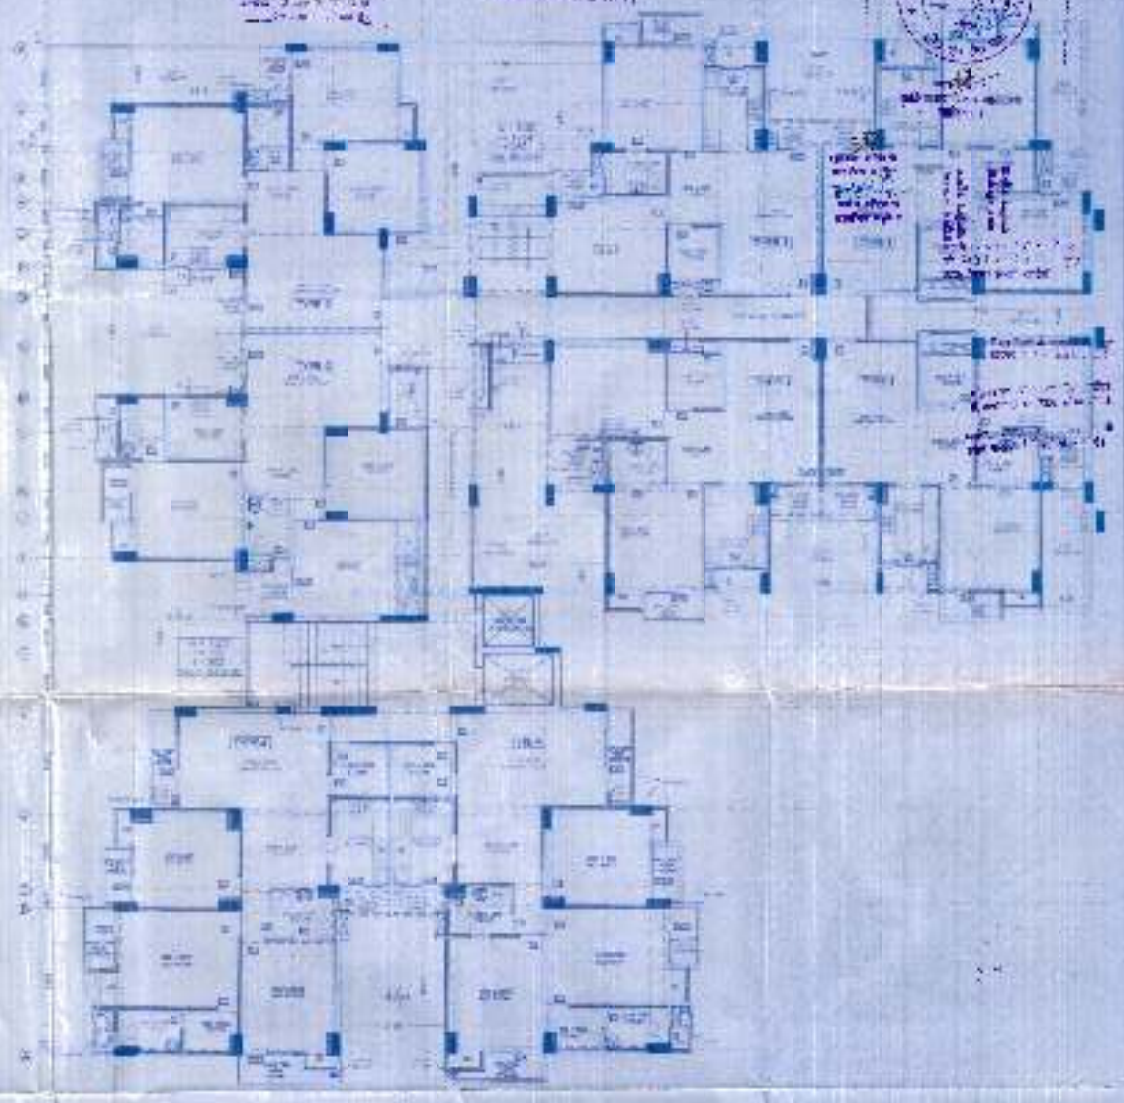

1ST FLOOR PLAN
(PROPOSED)

DRAWING SCHEDULE OF DOORS & WINDOWS

S.NO.	TYPE	SIZE (mm)	SILL (mm)	LINTEL
1	D/W1	1000 X 2100	1100 / 900	2300
2	D/W2	2200 X 2300	100 / 900	2300
3	D	1000 X 2100	100	2100
4	D1	900 X 2400	100	2100
5	D2	750 X 2100	100	2100
6	W	700 X 1200	1200	2300
7	V	600 X 1100	1200	2300
8	V1	600 X 900	1400	2300

ARCHITECT & CONSULTANT IN ARCHITECTURE

DRAWING NO. PROPOSED
STILT & 1st FLOOR PLAN


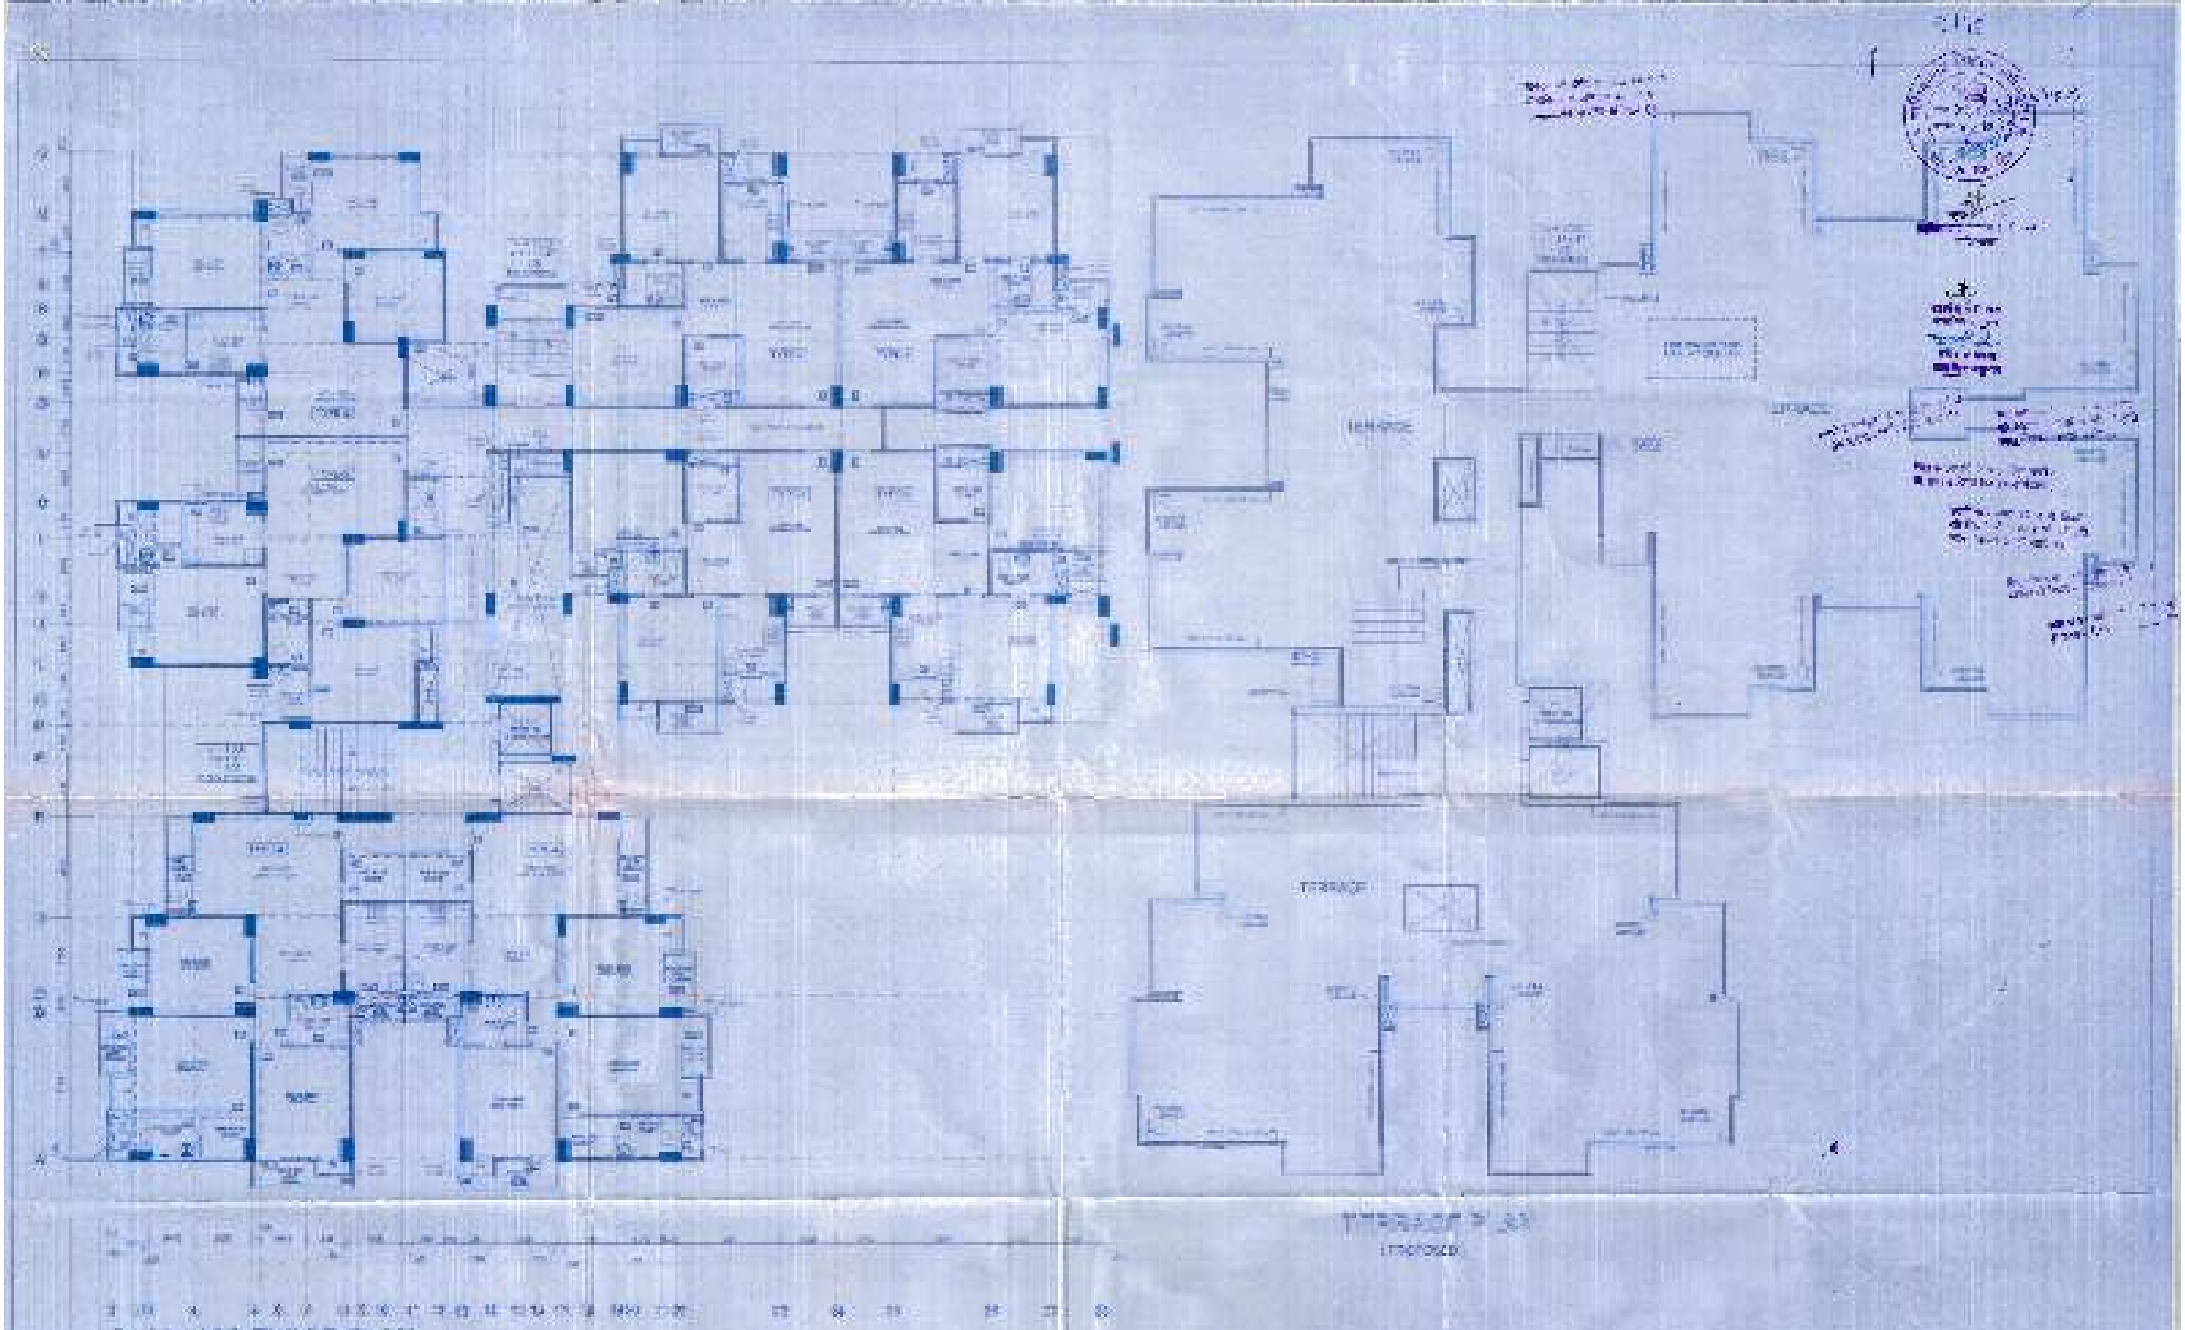

OPENING SCHEDULE FOR DOORS & WINDOWS			
SLNO. TYPE	SIZE (MM)	SILL LEVEL	HEIGHT
1	D1	1000 X 2100	0.00 / 300	2100
2	D2	1200 X 2100	0.00 / 300	2100
3	D	1000 X 2100	0.00	2100
4	D1	900 X 2100	0.00	2100
5	D2	1000 X 2100	0.00	2100
6	V	750 X 1200	1200	2400
7	V	600 X 1100	1300	2400
8	V1	600 X 1100	1400	2400



PROPOSED
2ND FLOOR PLAN

PRELIMINARY

ARCHITECTURE

Architecture & Interiors

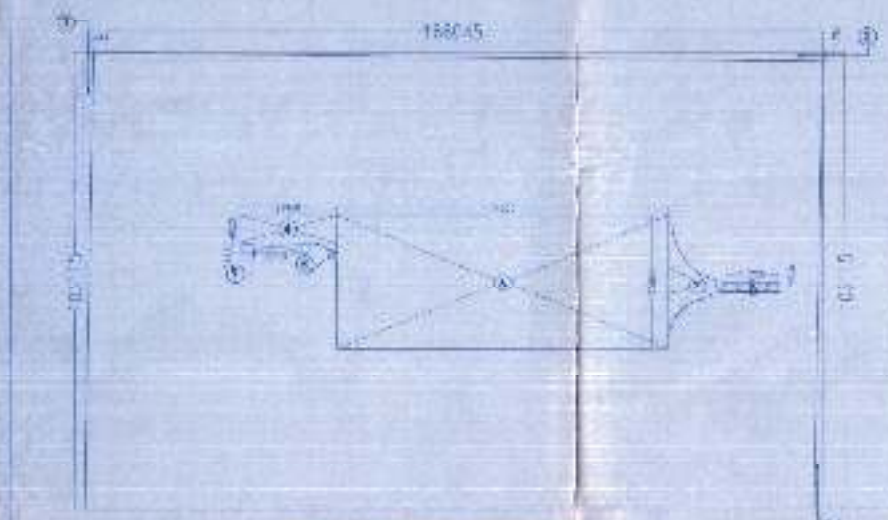

BASEMENT- 1 (PHASE-1 & PHASE-2)

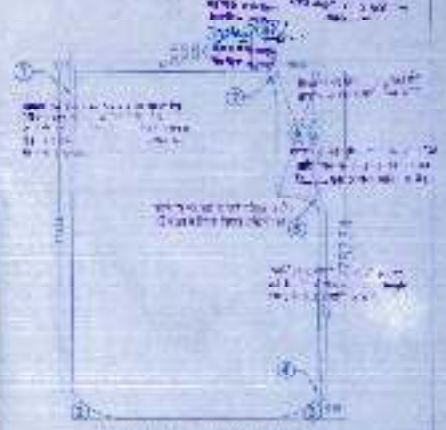

BASEMENT - 1,2 &3 (PHASE-3)

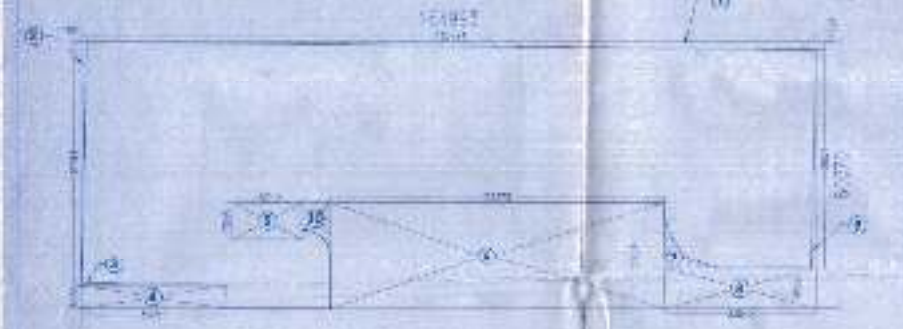

BASEMENT-4 & 5 (PHASE-3)

PLOT AREA CALCULATION

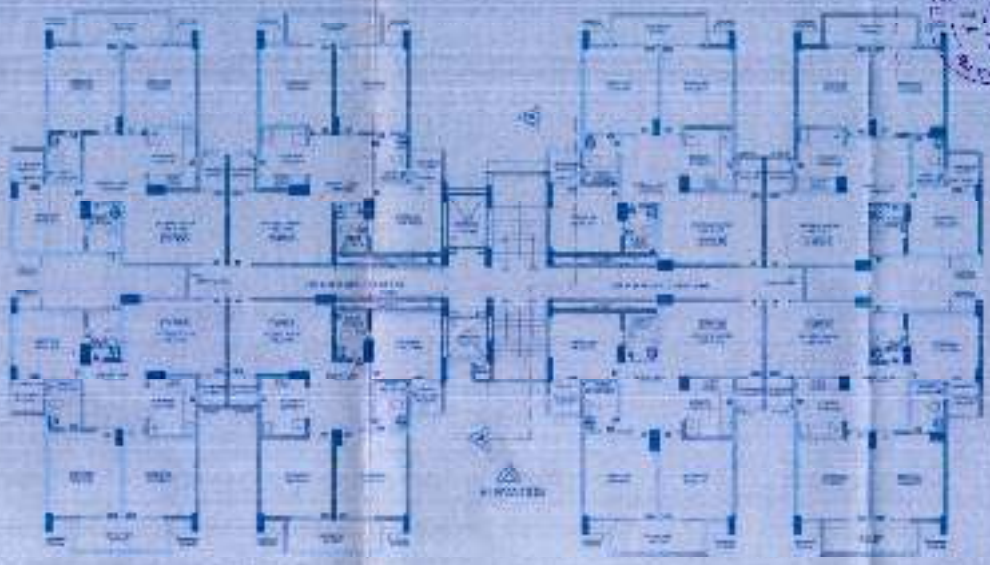

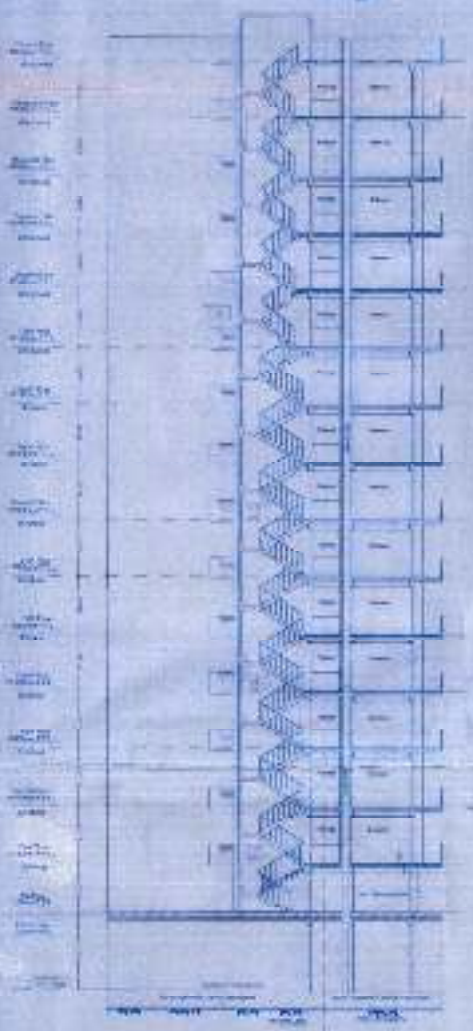

FRONT ELEVATION

PROJECT :

ADDITION & ALTERATION IN SUBMISSION DRAWING FOR GROOP HOUSING "FORTUNE RESIDENCY" AT KHASRA NO. [illegible] AT VILLAGE KOORNAGAR GHAZIABAD (UP)

OWNER

MS. [illegible] AND OTHERS

DRAWINGS TITLE

ELEVATION & SECTION (BLOCK - B)

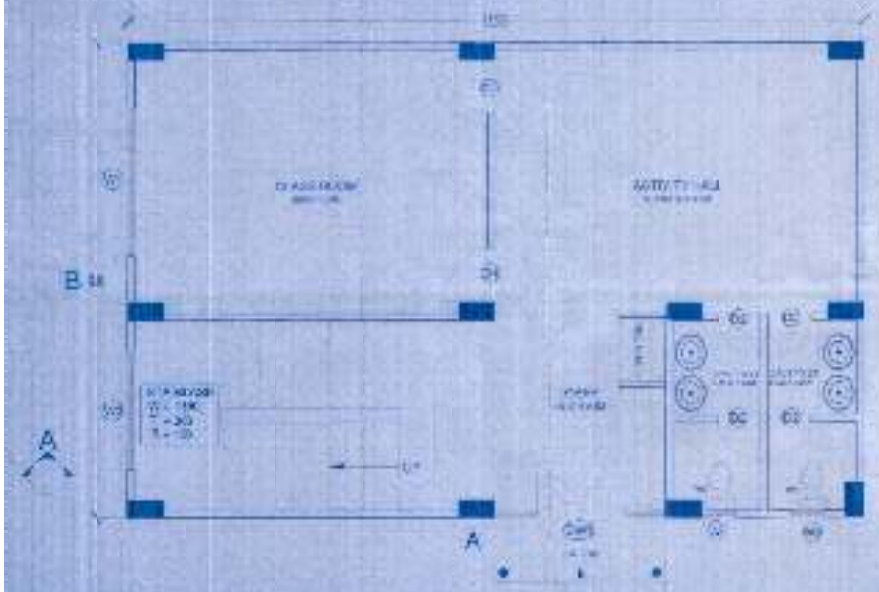

GROUND FLOOR PLAN

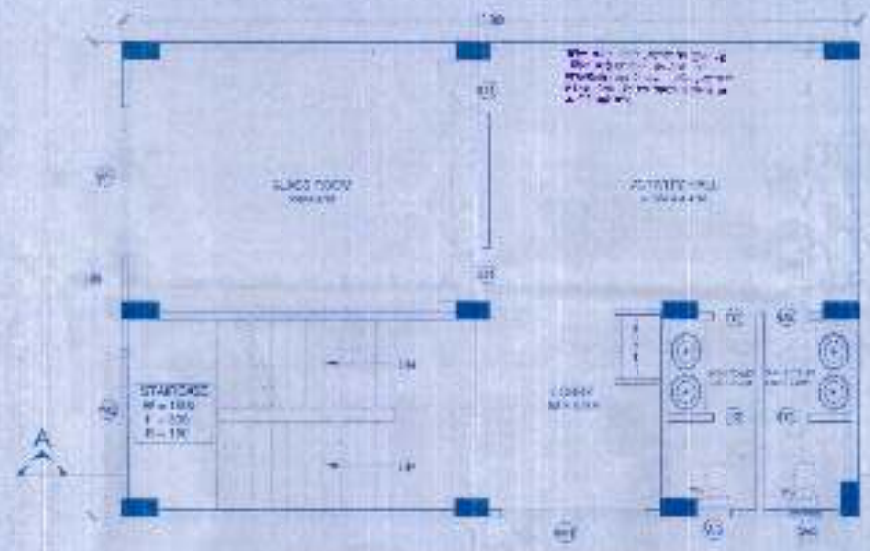

FIRST TO THIRD FLOOR PLAN

NURSERY SCHOOL AREA DETAIL		
S. NO.	DIMENSION	AREA (SQ. MTR)
1	12.50 M X 8.00 M	100.0
	TOTAL	100.0

AREA STATEMENT

S.NO.	FLOORS	AREA (sq.mt.)
1.	GROUND FLOOR	100.00
2.	1st FLOOR	100.00
3.	2nd FLOOR	100.00
4.	3rd FLOOR	100.00
	TOTAL AREA	400.00

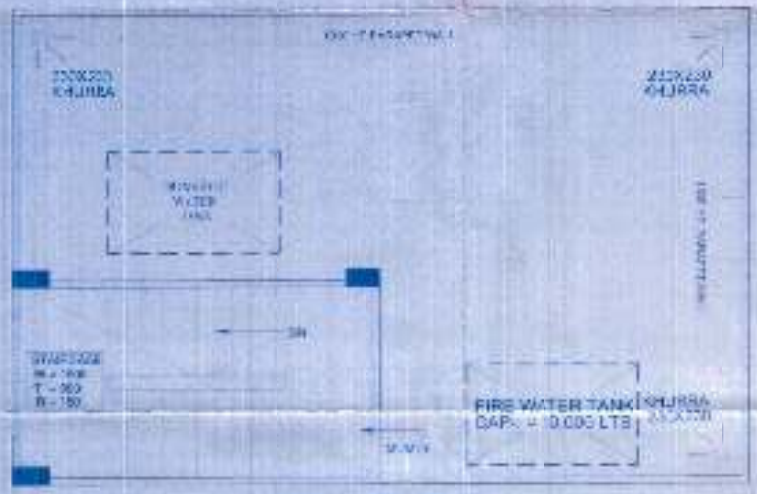

TERRACE PLAN

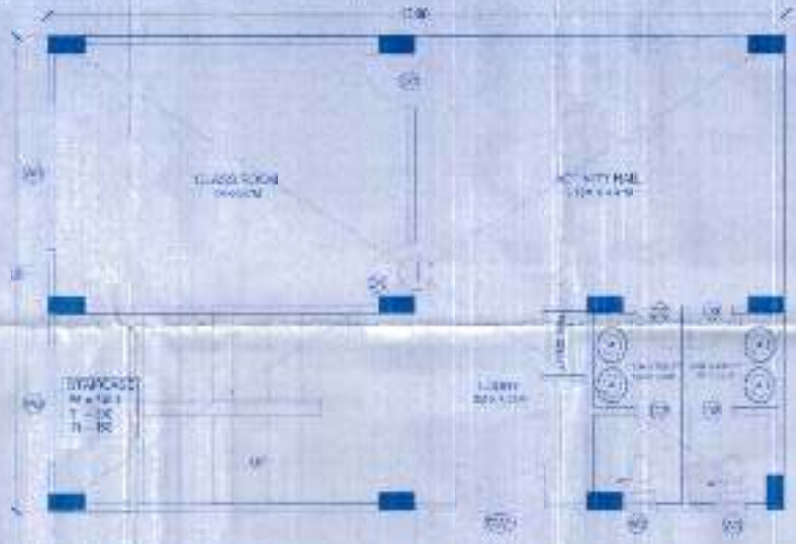

AREA CALCULATION

DOORS WINDOWS SEHEDULE

NURSERY SCHOOL

ARCHITECT'S SIGN

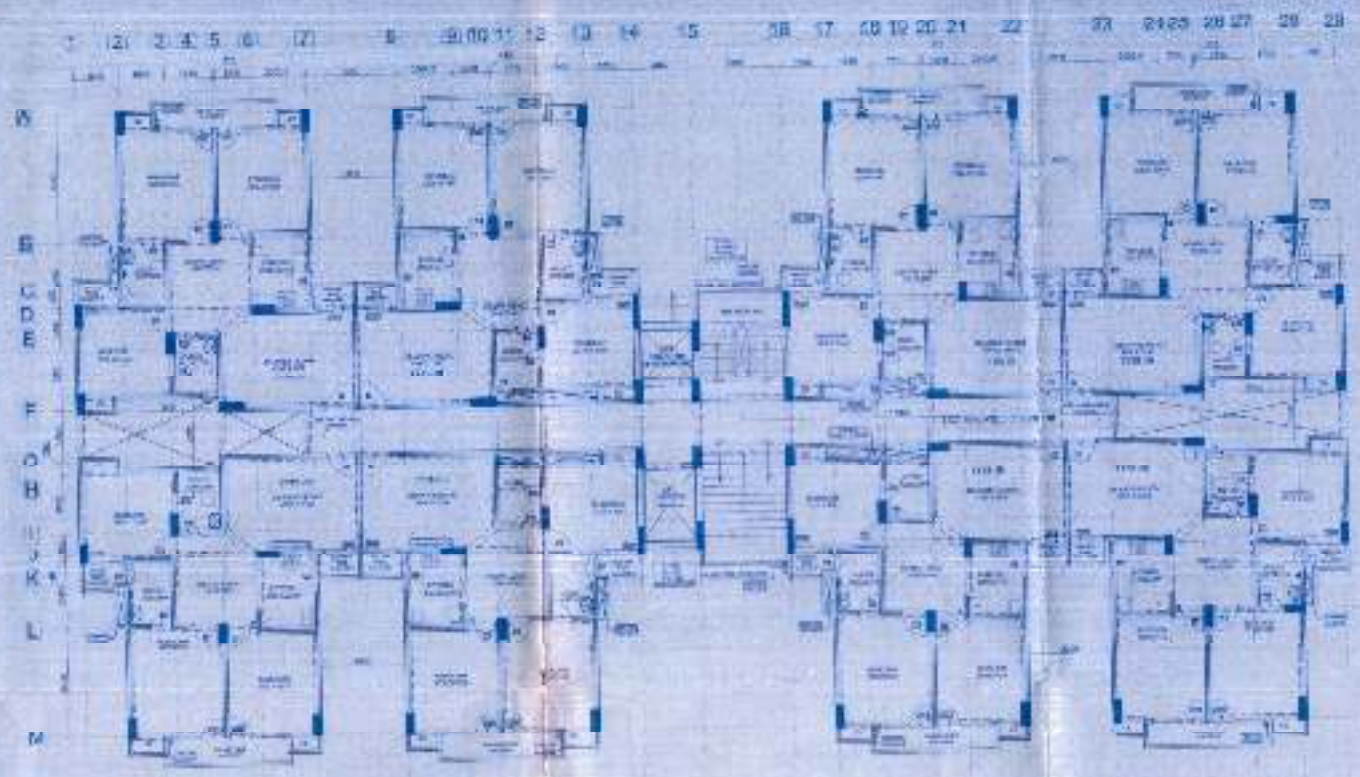

SECOND FLOOR PLAN

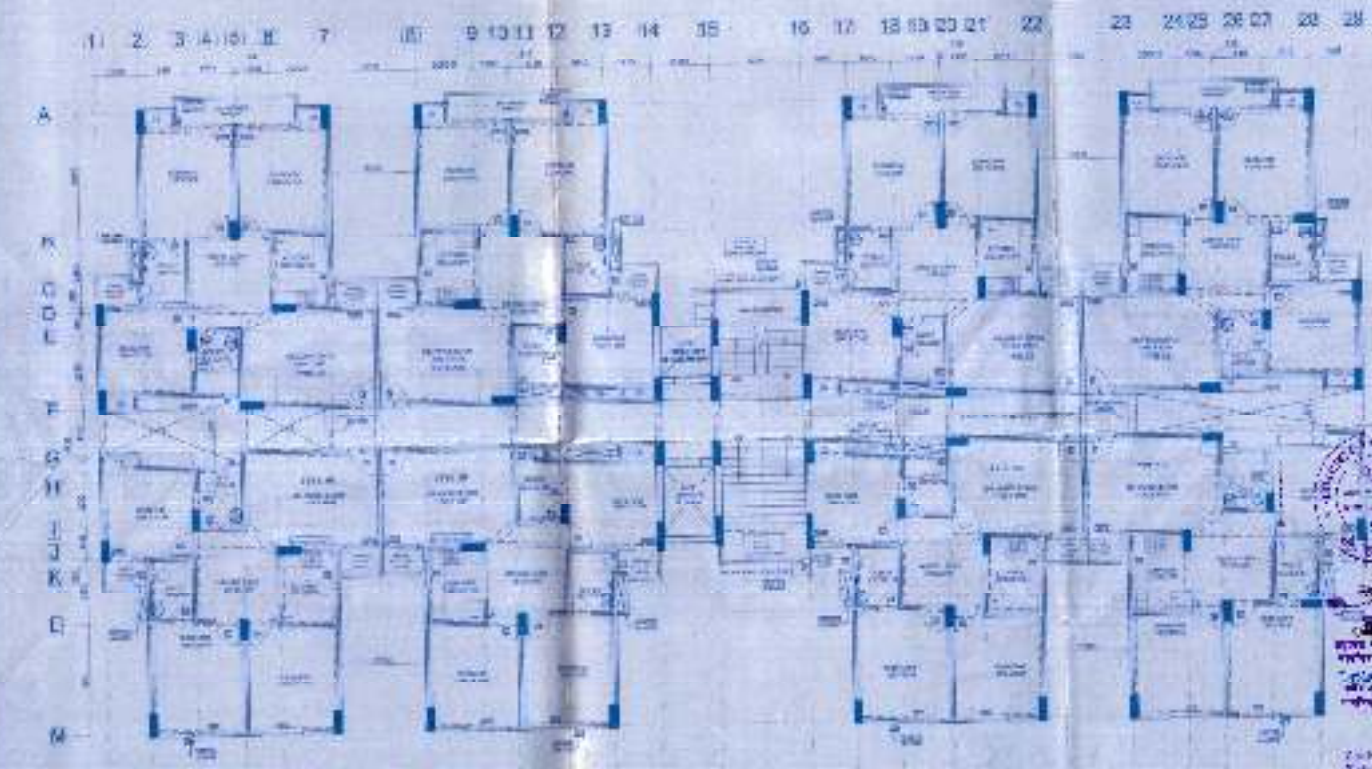

SECOND FLOOR PLAN

DESIGN SCHEDULE OF DOORS & WINDOWS

1				2100
2				2100
3				2100
4	D1	900 X 2100		2100
5				
6	W1	700 X 1200		2100
7				2100
8				2100
9				2100

ALL DOOR WINDOW FRAME

SECOND FLOOR PLAN

Architects & Interior Designers Pvt. Ltd.

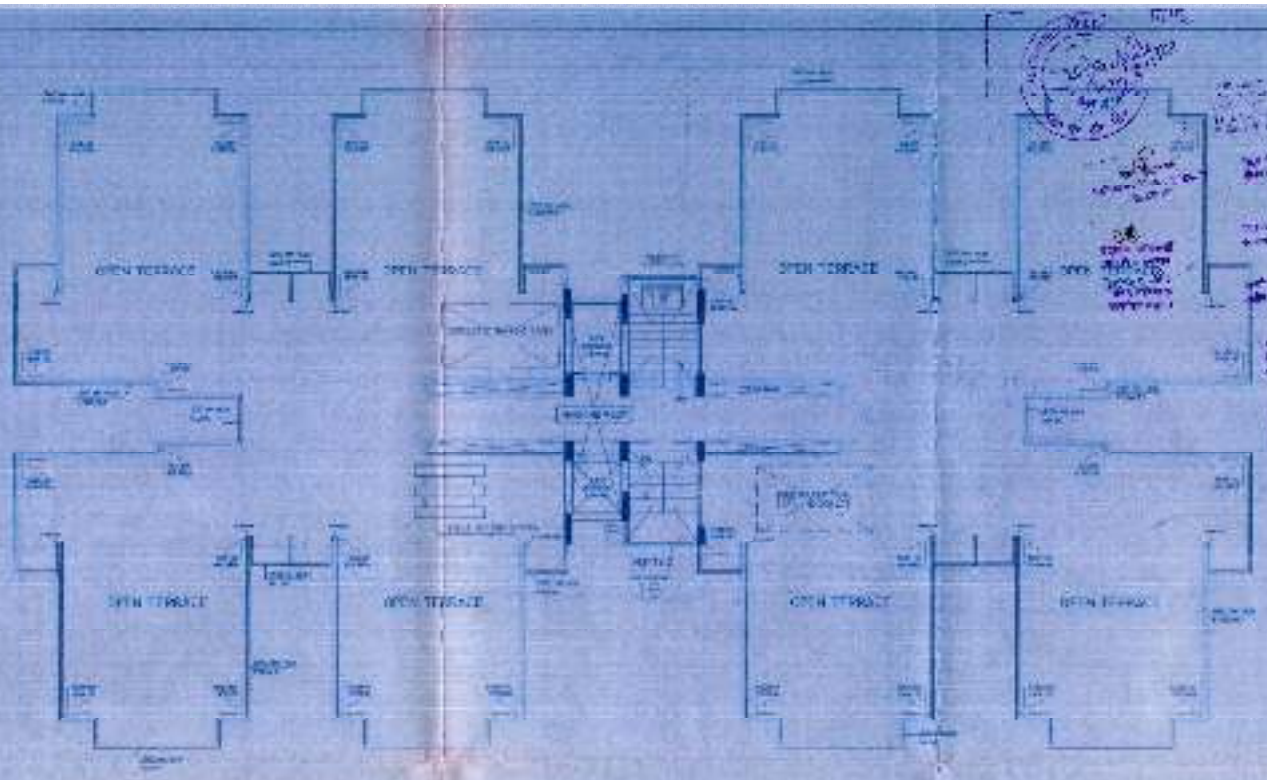

TERRACE FLOOR PLAN

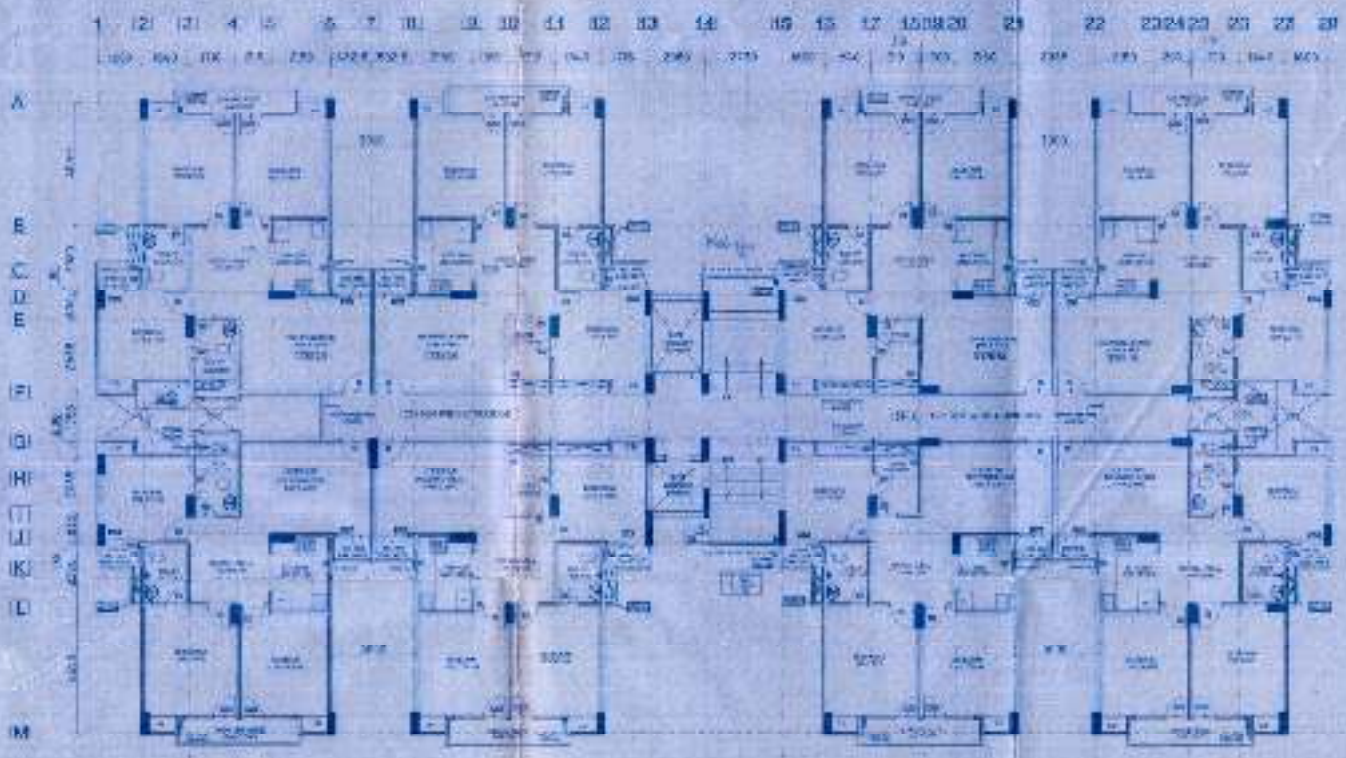

TYPICAL FLOOR PLAN

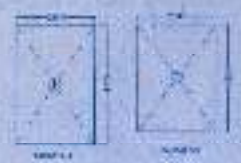

Architecture Services Pvt. Ltd.

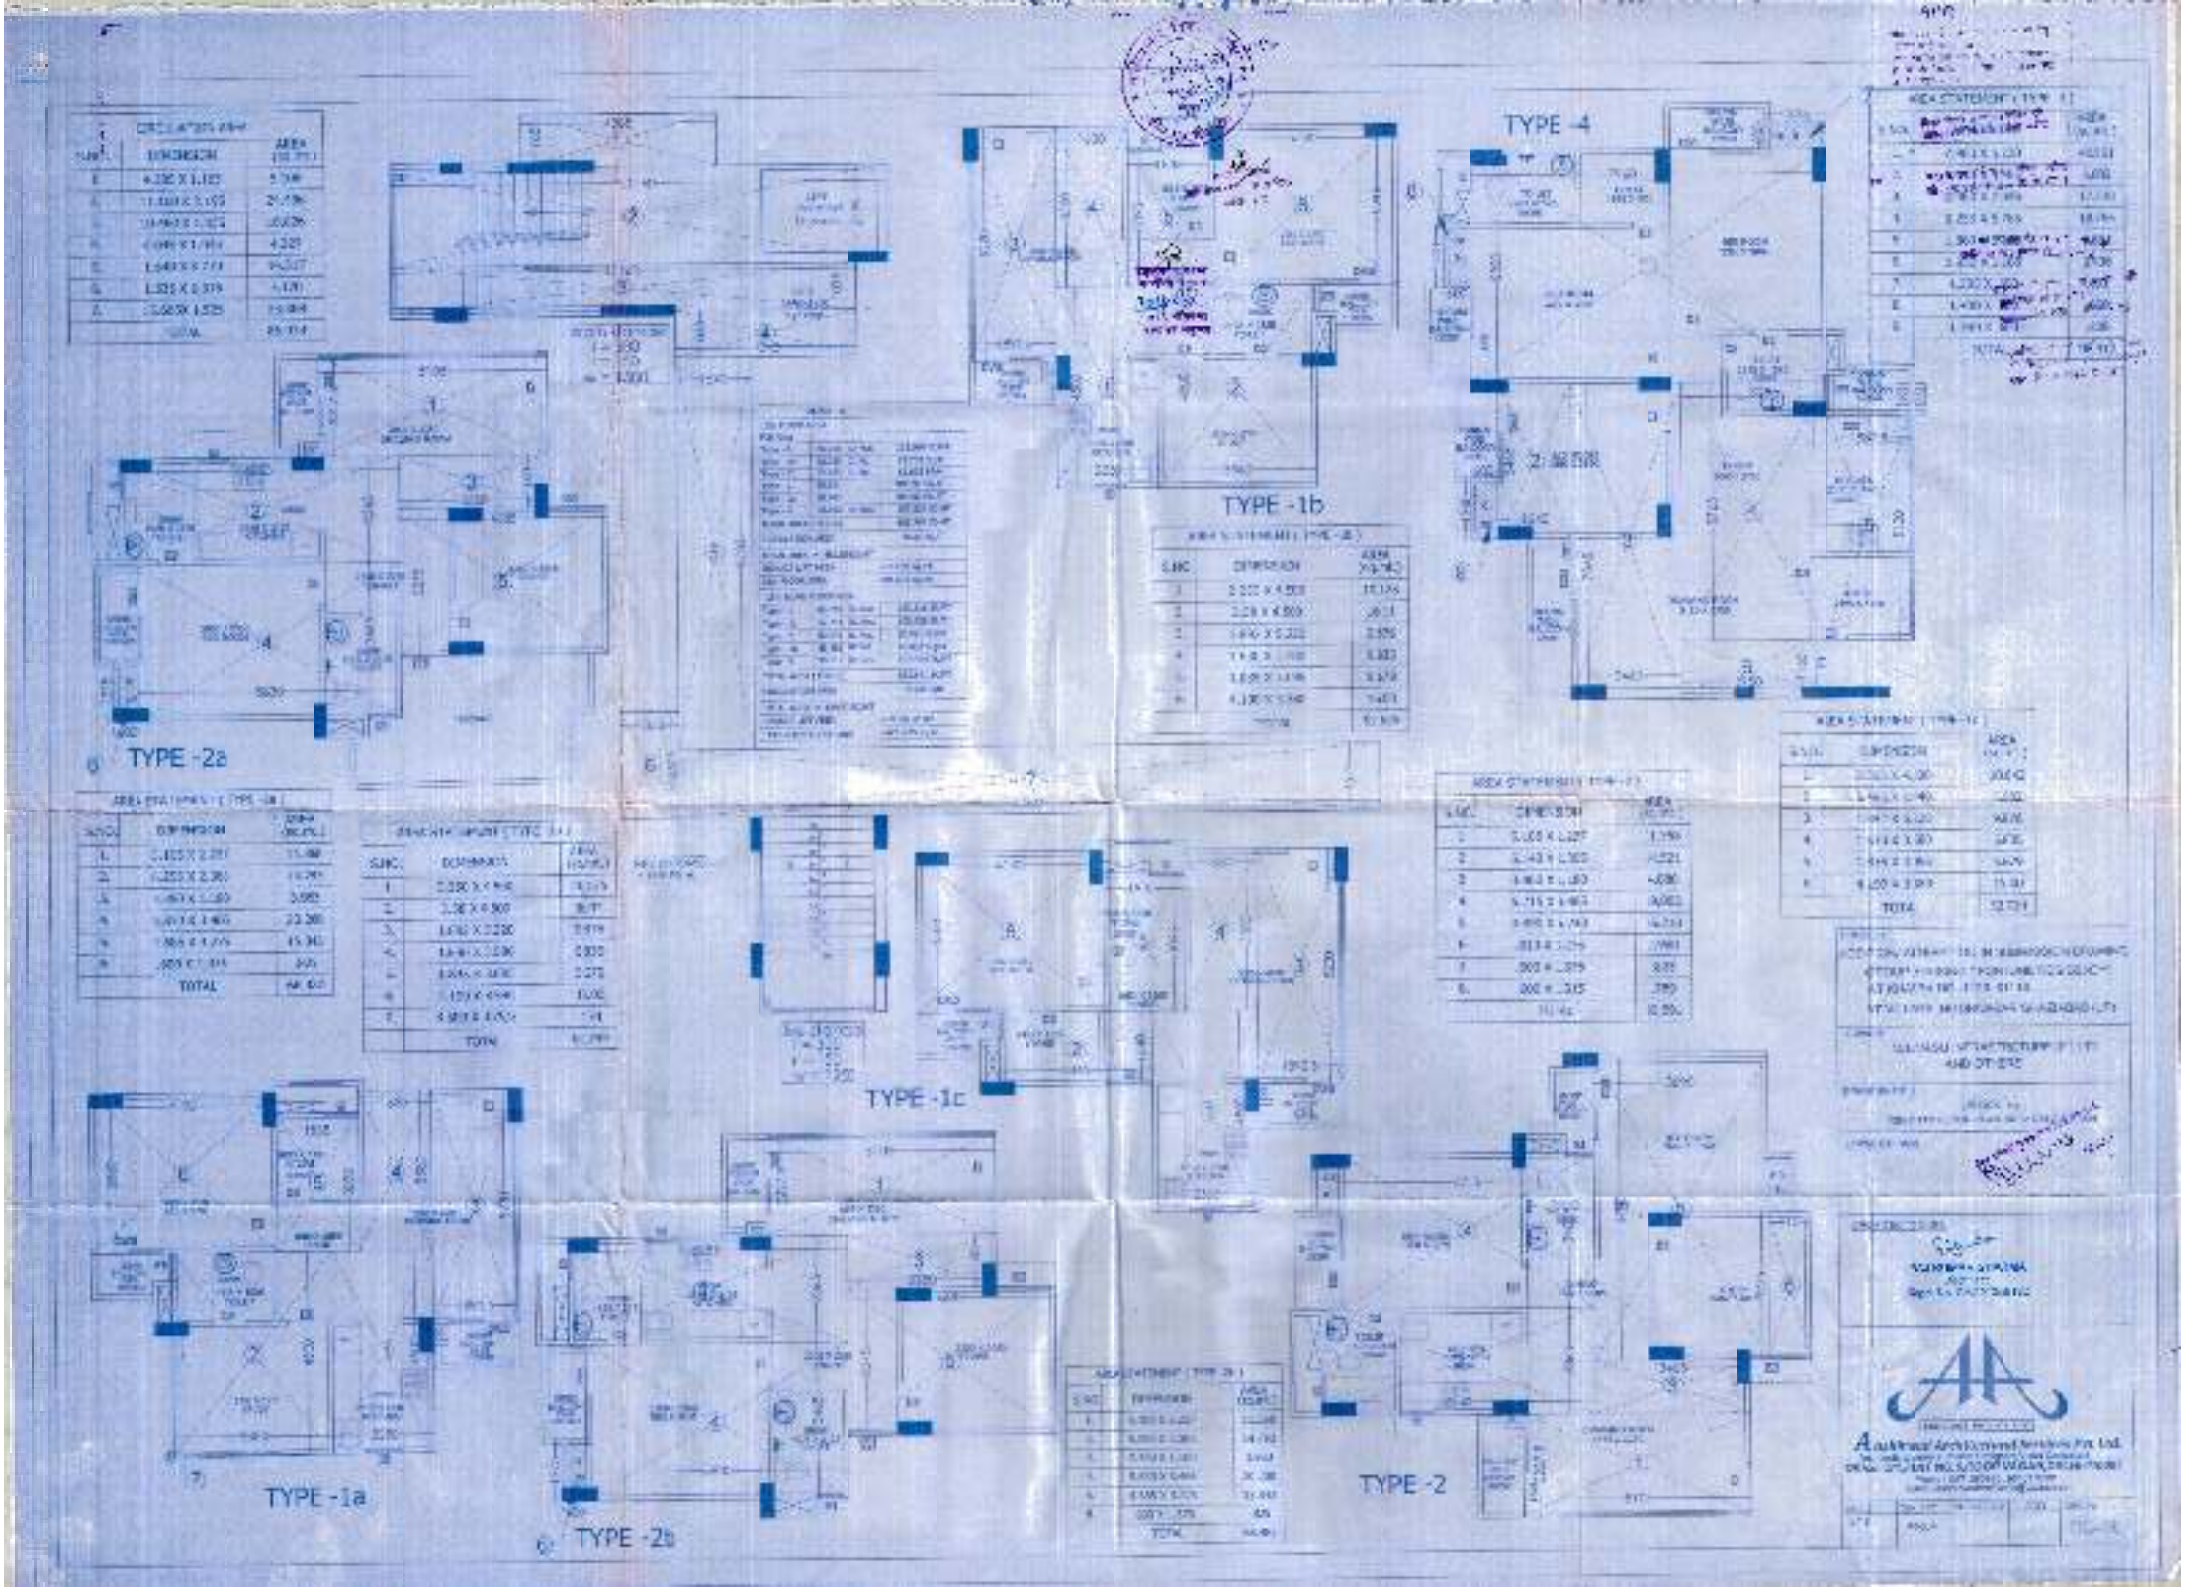
TYPE -4
TYPE -1b
TYPE -2a
TYPE -1c
TYPE -1a
TYPE -2b
TYPE -2

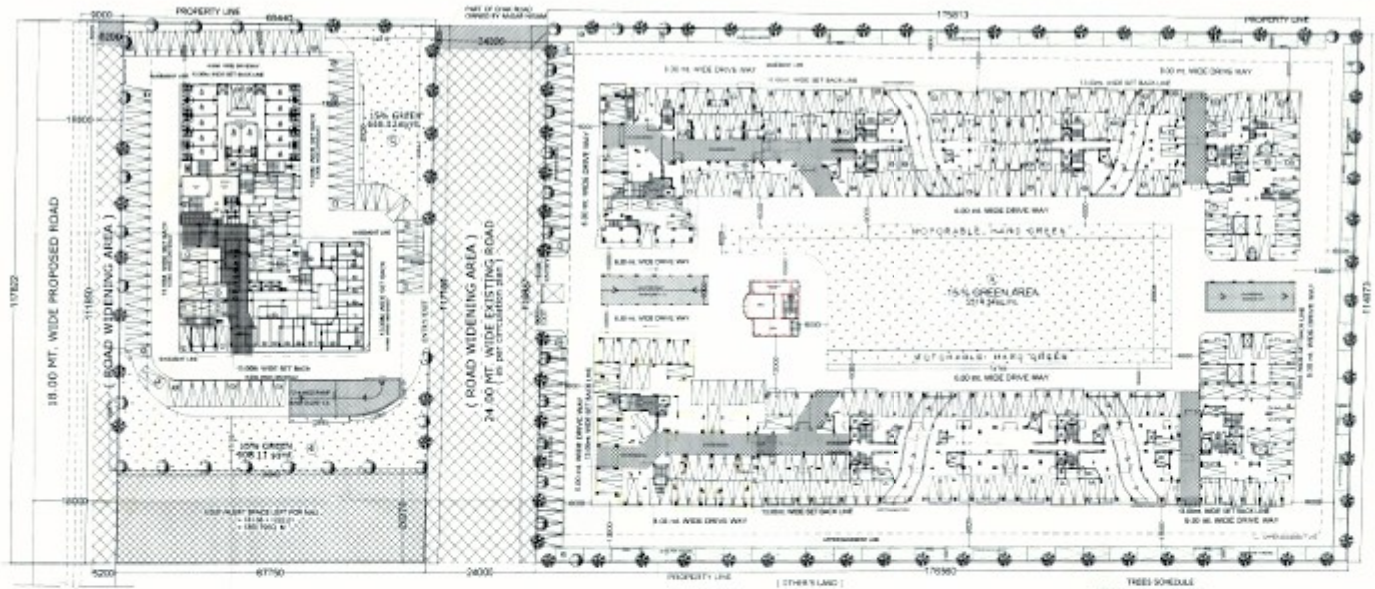

STILT PLAN

TREES DETAIL	
1	REQUIRED TREES AS PER DE TREES INCHME OF PLOT AREA
	[illegible]
	REQUIRED NO. OF TREES [illegible]
	PROVIDED NO. OF TREES [illegible]

PROJECT:
COMPLIANCE DRAWINGS FOR
GROUP HOUSING FORTUNE RESIDENCY
AT KHASRA NO. [illegible]
AT VILLAGE NOORNAGAR GHAZIABAD U.P.

OWNER: M/S. [illegible] INFRASTRUCTURE (P) LTD

DRAWING TITLE:
STILT PARKING PLAN LANDSCAPE PLAN

OWNER SIGN. ARCHITECT SIGN.

ARCHITECTS, ENGINEERS, LANDSCAPE & INTERIOR DESIGNERS
INDIA WARRIAL ARCHITECTS P. LTD.
[illegible]

SCALE	DATE	DRAWN BY	CHECKED BY	DRAWING NO.
[illegible]		[illegible]		CD-03

PARKING REQUIREMENT (SF WC) (AS PER ADMISSIBLE)	
A. PREVIOUS SANCTIONED F.A.R. AREA = [illegible] (Residential Block - [illegible])	
B. PREVIOUS SANCTIONED PARKING = [illegible] E.C.S.	
C. AREA AS PER CURRENT PARKING = [illegible] (Residential)	
D. TO BALANCE F.A.R. AREA APPLY NEW SCHEME = [illegible]	
E. REQUIRED PARKING NEW SCHEME = [illegible]	
TOTAL E.C.S. REQUIRED = [illegible] = [illegible] = [illegible] E.C.S.	[illegible]
PROVIDED PARKING DETAIL (AS PER ARCHITECT)	
TOTAL E.C.S. PROVIDED	[illegible]
A. LOWER BASEMENT (TYPICAL PARKING - [illegible] / TYPICAL PARKING - [illegible] / TOTAL PARKING - [illegible] (proposed) / ADD. PARKING - [illegible] (proposed))	[illegible]
B. 2nd BASEMENT (TYPICAL PARKING - [illegible] / ADD. PARKING - [illegible])	[illegible]
C. 3rd BASEMENT (TYPICAL PARKING - [illegible] / ADD. PARKING - [illegible])	[illegible]
D. STILT PARKING (TYPICAL PARKING - [illegible] / ADD. PARKING - [illegible] / TOTAL PARKING - [illegible] (proposed))	[illegible]
E. OPEN (TYPICAL PARKING - [illegible] / ADD. PARKING - [illegible] / TOTAL PARKING - [illegible] (proposed))	[illegible]
TOTAL (A + B + C + D + E)	[illegible]

2WS PARKING REQUIREMENT = ON EACH UNIT 2
[illegible] AREA IS REQUIRED FOR MOTOR CYCLE / SCOOTER BICYCLE
TOTAL NO. OF DWS = [illegible]
PROVIDED PARKING FOR DWS = 40 TWO WHEELER PARKING


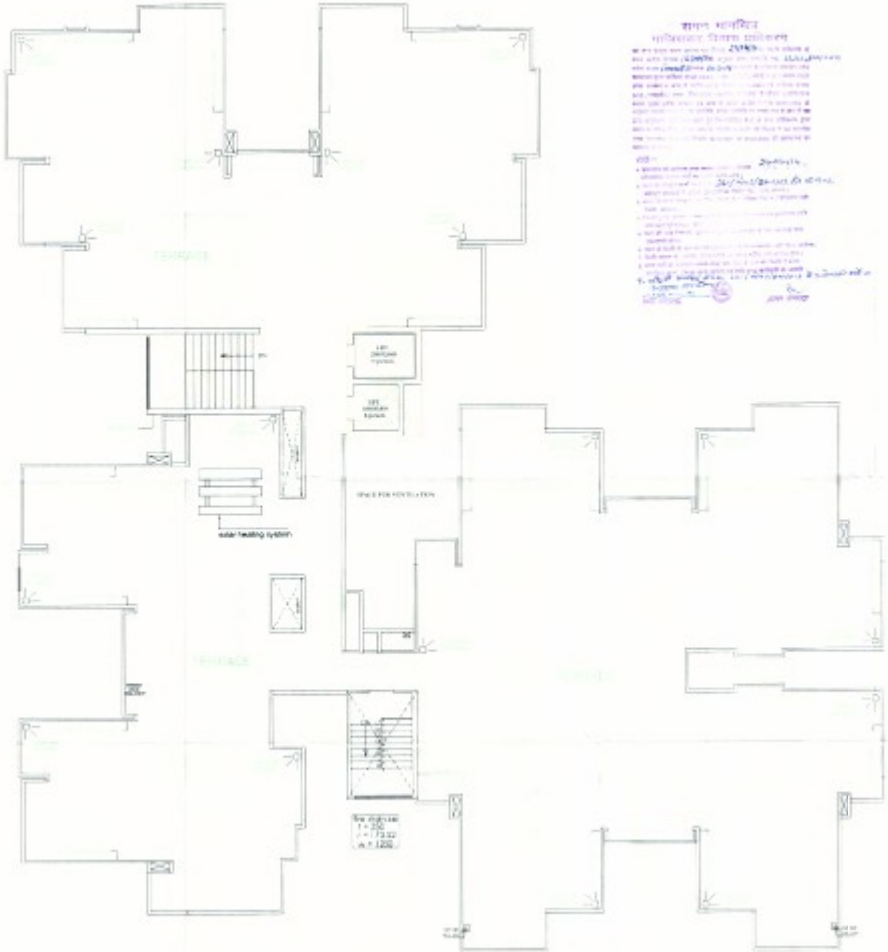

TERRACE PLAN

(EXISTING)

PROJECT :
COMPOUNDING DRAWINGS FOR
GROUP HOUSING "FORTUNE RESIDENCY"

OWNER :

DRAWING TITLE : BLOCK - A
TERRACE PLAN

OWNER SIGN | ARCHITECT SIGN

ARCHITECT
ARCHITECTS, ENGINEERS, LANDSCAPE & INTERIOR DESIGNERS
[illegible]
TEL : [illegible]
FAX : [illegible]
EMAIL : [illegible]
WEB : [illegible]

SCALE	DATE	DRAWN BY	CHECKED BY	SHEET NO.
1:100		ACDM		CD-05

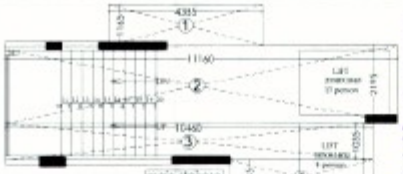

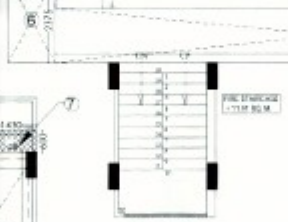

SECTION - AA

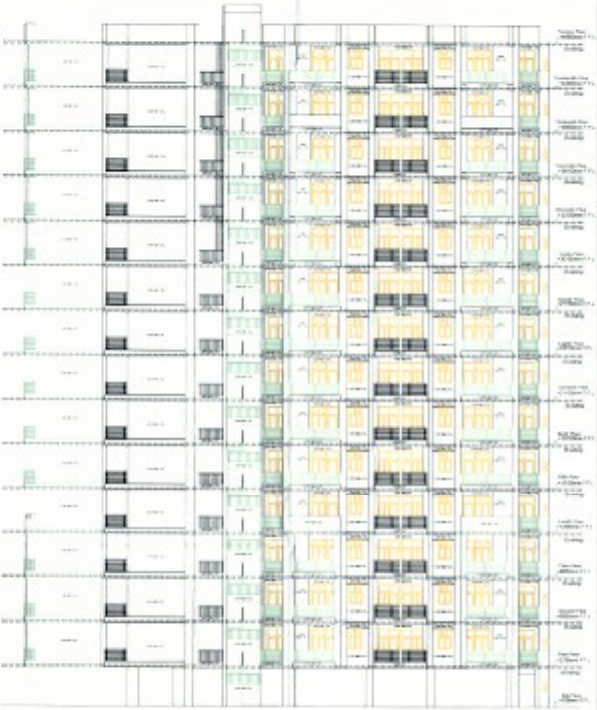

ELEVATION - SIDE B

PROJECT :	OWNER:			DRAWING TITLE		
COMPOUNDING DRAWINGS FOR GROUP HOUSING " FORTUNE RESIDENCY " AT KHASRA NO -1123 &1116 AT VILLAGE NOORNAGAR GHAZIABAD (UP)	M/s. VASU INFRASTRUCTURE (P) LTD AND OTHERS	OWNER'S SIGN	ARCHITECT'S SIGN	ELEVATION & SECTION (BLOCK - A)		SCALE 1:100 DATE DRAWN BY CHECKED BY DWG. NO. CD-07

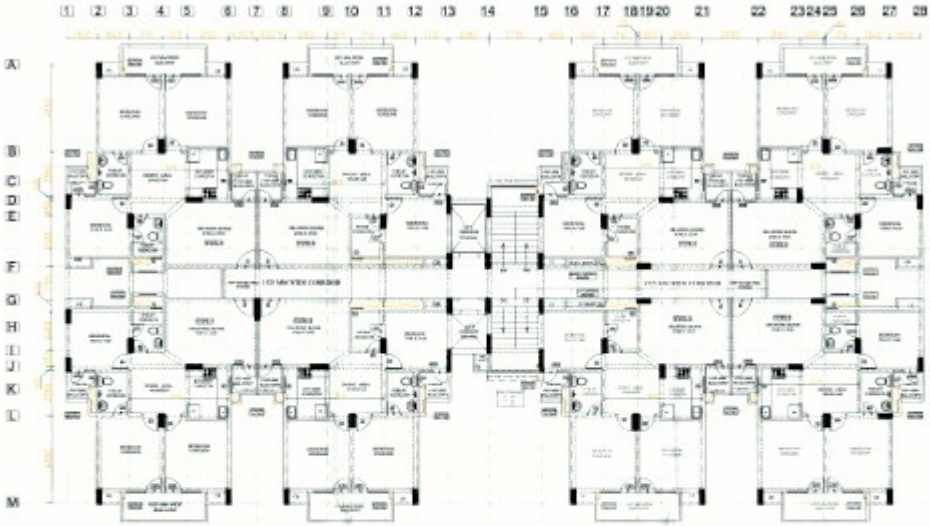

1st TO 14th FLOOR PLAN

(EXISTING)

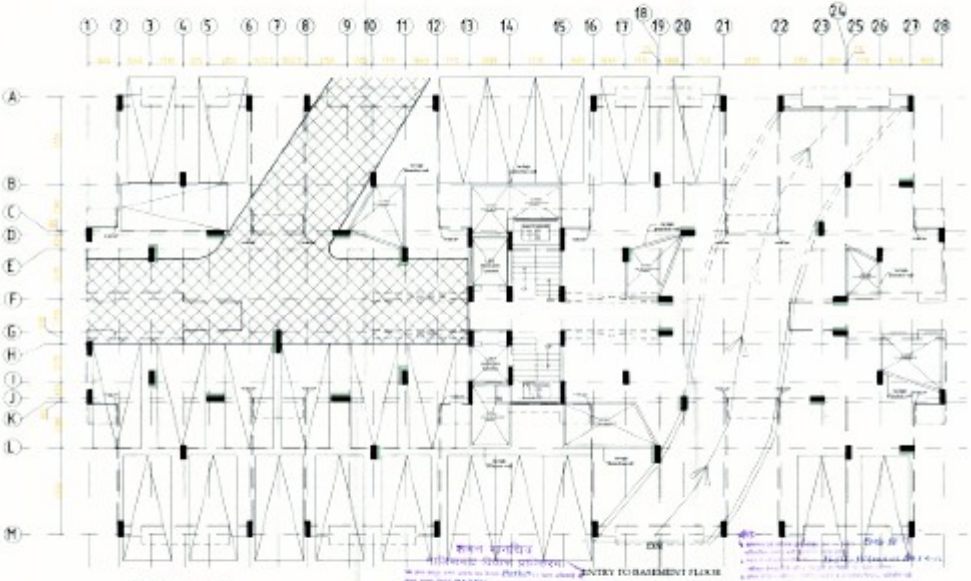

STILT PLAN

(EXISTING)

OPENING SCHEDULE OF DOORS & WINDOWS				
S.NO	TYPE	SIZE (mm)	SILL (mm)	LINTEL
1	DWD	1800 X 2950	0.00 / 900	2950
2	DWD	1220 X 2950	0.00 / 900	2950
3	D	1050 X 2100	0.00	2100
4	D1	900 X 2100	0.00	2100
5	D2	750 X 2100	0.00	2100
6	W	750 X 1350	1350	2550
7	V	900 X 1100	1250	2350
8	V1	900 X 900	1450	2350

COMPOUNDING DRAWING FOR

(BLOCK - B1) (EXISTING)
STILT to 14th FLOOR PLAN

OWNER SIGN

ARCHITECT SIGN


DATE: 03-08

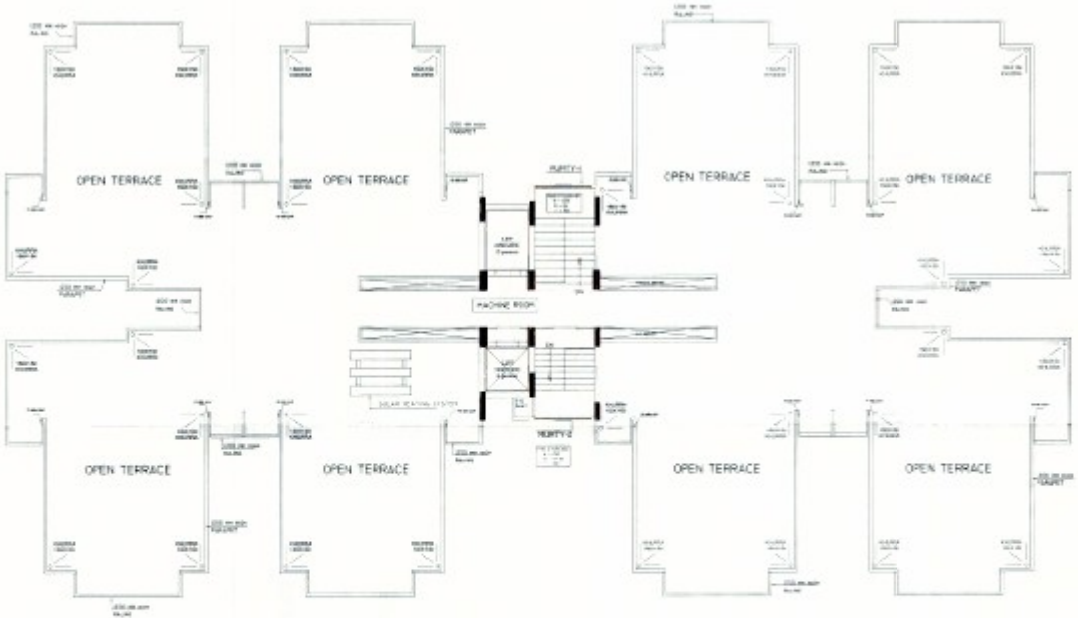

TERRACE FLOOR PLAN

(EXISTING)

COMPOUNDING DRAWINGS FOR
GROUP HOUSING " FORTUNE RESIDENCY"
AT KHASRA NO -1123 &1176
AT VILLAGE NOORNAGAR GHAZIABAD (UP)

(BLOCK - B1) (EXISTING)
TERRACE PLAN

OWNER SIGN | ARCHITECT SIGN

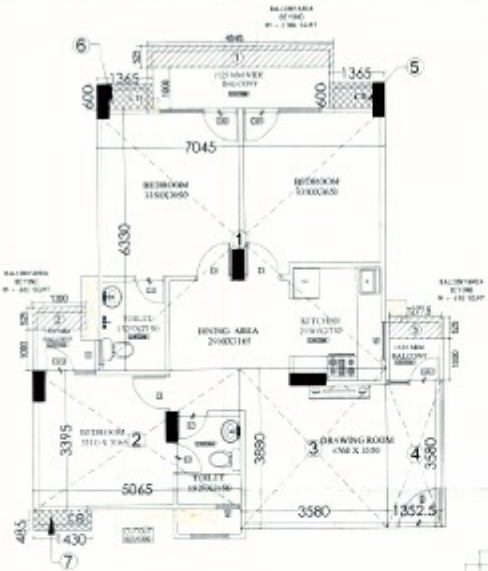

AREA STATEMENT (TYPE -5)

S.NO.	DIMENSION	AREA (sq.mt.)
1.	7.045 X 6.330	44.594
2.	5.065 X 3.395	17.195
3.	3.580 X 3.880	13.890
4.	1.352 X 3.580	4.840
5.	1.365 X .600	.819
6.	1.365 X .600	.819
7.	1.430 X .485	.693
	TOTAL	82.85

BALCONY AREA IN COMPOUNDING (Type -5)

TYPE OF FLAT	BALCONY NO	TOTAL BALCONY AREA PER FLOOR
TYPE-5	1	[illegible]
	2	[illegible]
	3	[illegible]
	TOTAL	[illegible] sq.mt

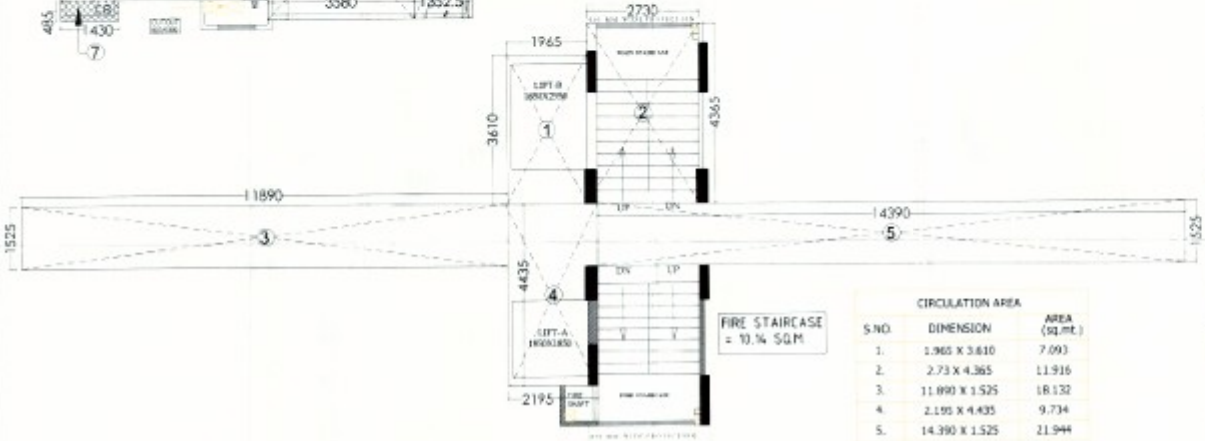

FIRE STAIRCASE = 10.14 SQ.M

CIRCULATION AREA

S.NO.	DIMENSION	AREA (sq.mt.)
1.	1.965 X 3.610	7.093
2.	2.73 X 4.365	11.916
3.	11.890 X 1.525	18.132
4.	2.195 X 4.435	9.734
5.	14.390 X 1.525	21.944
	TOTAL	68.819

BLOCK - B

Flat Area			
Type - 5	82.85	08 Nos.	662.80 SQ.MT
TOTAL AREA (FLATS)			662.80 SQ.MT
CIRCULATION AREA			68.819 SQ.MT
TOTAL FIRST FLOOR AREA = 731.619 SQ.MT			

(LIFT - A) = (1.850 X 1.850) = 3.422 sq.m
(LIFT - B) = (2.550 X 1.850) = 4.717 sq.m
TOTAL LIFT AREA = 8.139 sq.m.

TYPICAL FLOOR AREA
= TOTAL FIRST FLOOR AREA - LIFT AREA
= 731.619 - 8.139 SQ.MT.
= 723.48 SQ.MT

AREA STATEMENT

S.No.	FLOORS	AREA (sq.m)	UNITS
1	STILT (PARKING FLOOR)		
2	FIRST FLOOR (DWELLING)		8
3	SECOND FLOOR (DWELLING)		8
4	THIRD FLOOR (DWELLING)		8
5	FOURTH FLOOR (DWELLING)		8
6	FIFTH FLOOR (DWELLING)		8
7	SIXTH FLOOR (DWELLING)		8
8	SEVENTH FLOOR (DWELLING)		8
9	EIGHT FLOOR (DWELLING)		8
10	NINETH FLOOR (DWELLING)		8
11	TENTH FLOOR (DWELLING)		8
12	ELEVENTH FLOOR (DWELLING)		8
13	TWELVETH FLOOR (DWELLING)		8
14	THIRTEENTH FLOOR (DWELLING)		8
15	FOURTEENTH FLOOR (DWELLING)		8
	TOTAL (1 TO 15)	[illegible]	112

PROJECT :
COMPOUNDING DRAWING FOR
GROUP HOUSING " FORTUNE RESIDENCY "
AT KHASRA NO. 1321 & 1176
AT VILLAGE - NEERWADAR GHAZIABAD UP

OWNER :
M/s. [illegible] INFRASTRUCTURE PVT. LTD.

DRAWING TITLE :
BLOCK - B
FLOOR PLAN (AREA CALCULATION)
(for 15 THE FLOOR PLAN)

OWNER SIGN | ARCHITECT SIGN

AREA AGARWAL ARCHITECTS
architects, engineers, landscape & interior designers
AREA AGARWAL ARCHITECTS P. LTD.
A-2/11 SAUDAMINI GHAZIABAD (U.P.)
1 km angle [illegible]
Ph. [illegible] Mobile : [illegible]
E-mail : [illegible]
Website : [illegible]

DATE	DESIGN	DRAWN BY	CHECKED BY	SHEET NO.
[illegible]	[illegible]	[illegible]	[illegible]	CD - 18

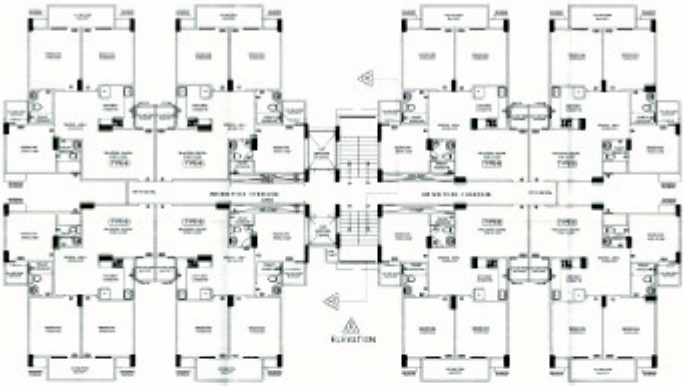

SECTION - AA

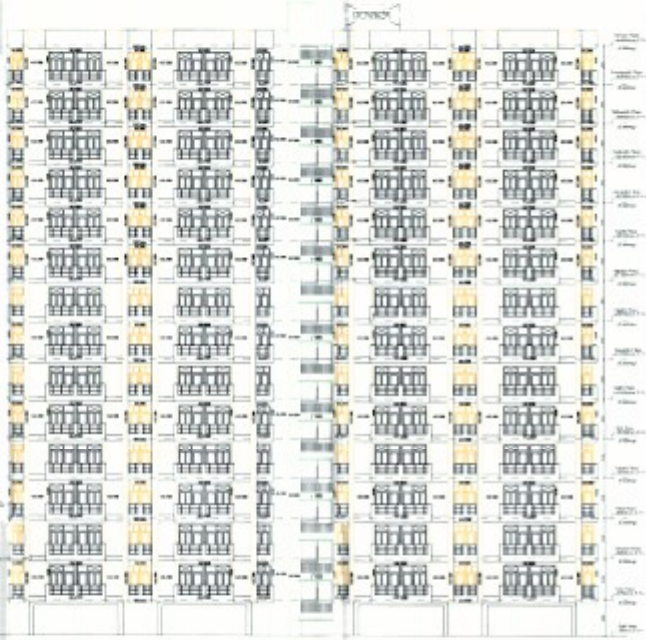

FRONT ELEVATION

PROJECT :	OWNER.		DRAWING TITLE		
COMPOUNDING DRAWINGS FOR GROUP HOUSING " FORTUNE RESIDENCY" AT KHASRA NO -1103 &1116 AT VILLAGE NOORNAGAR (GHAZIABAD) (UP)	M/s. VASU INFRASTRUCTURE (P) LTD AND OTHERS	OWNERS SIGN	ARCHITECTS SIGN	ELEVATION & SECTION (BLOCK - B)	CD-11

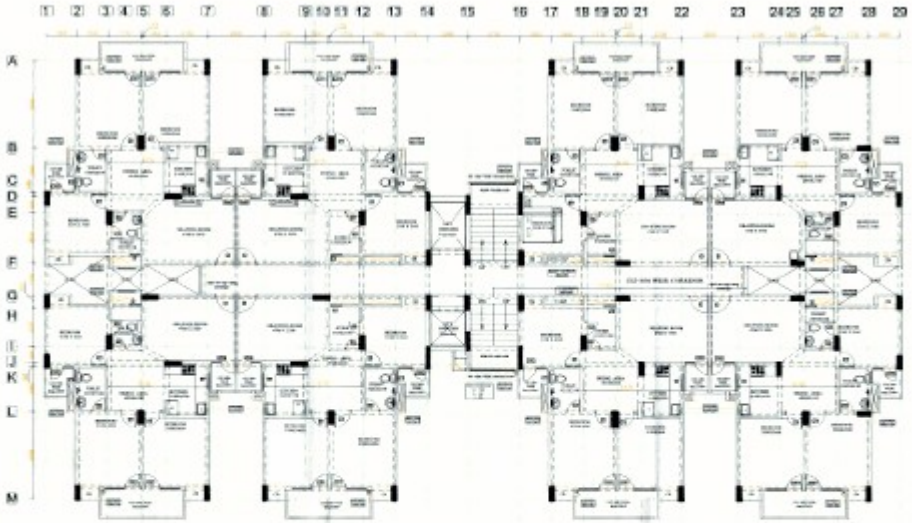

1st to 14th FLOOR PLAN

(EXISTING)

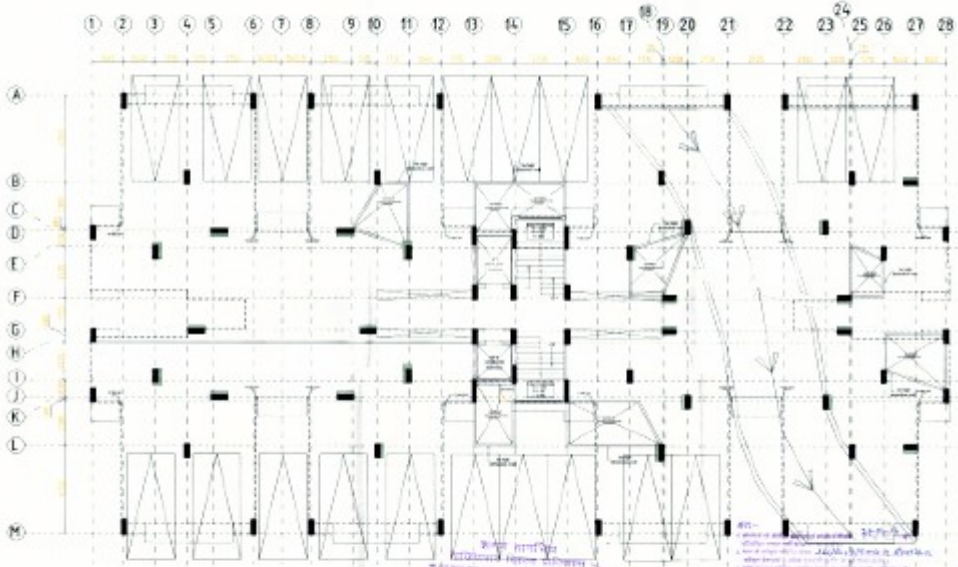

STILT PLAN

(EXISTING)

OPENING SCHEDULE OF DOORS & WINDOWS				
S.NO.	TYPE	SIZE (mm)	SILL (mm)	LINTEL
1	DW1	1000 X 2400	0.00 / 900	2400
2	DW2	1200 X 2400	0.00 / 900	2400
3	D	1050 X 2100	0.00	2100
4	D1	900 X 2100	0.00	2100
5	D2	750 X 2100	0.00	2100
6	W	750 X 1350	1200	2350
7	V	600 X 1100	1200	2350
8	V1	600 X 900	1400	2350

PROJECT :
(APPROVING DRAWING FOR)
GROUP HOUSING - FORTUNE RESIDENCY


DRAWING TITLE :
(BLOCK - A, C) (EXISTING)
STILT to 14th FLOOR PLAN

OWNER SIGN | ARCHITECT SIGN


SCALE	DATE	DRAWN BY	CHECKED BY	DWG. NO.
1:100				CD-12

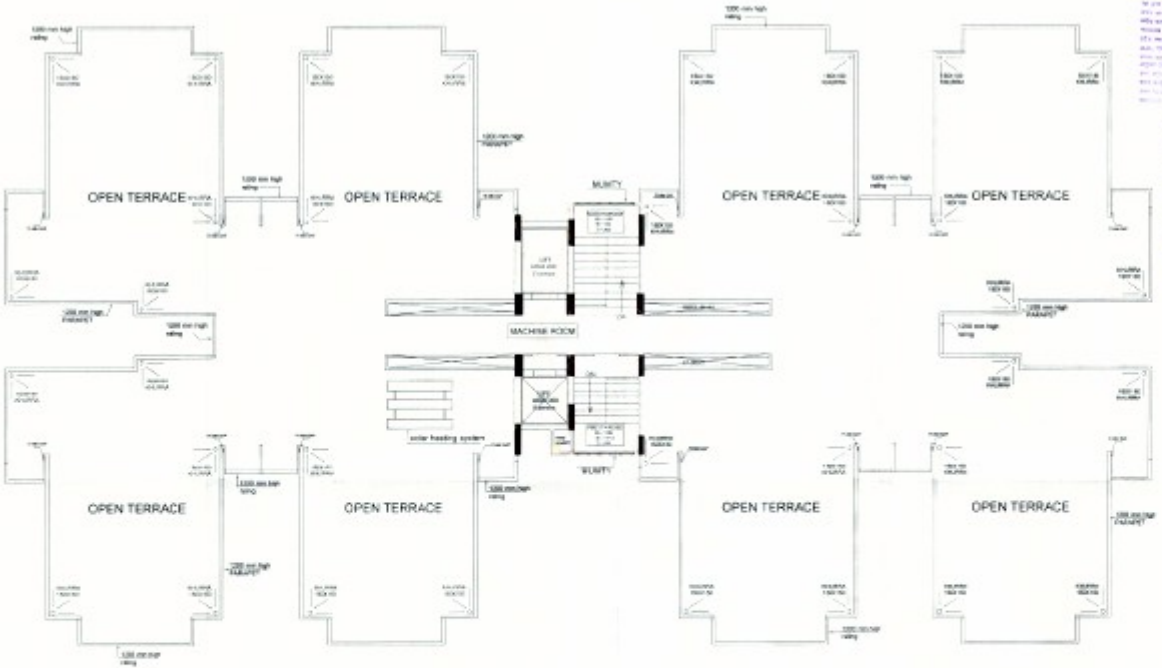

TERRACE FLOOR PLAN

(EXISTING)

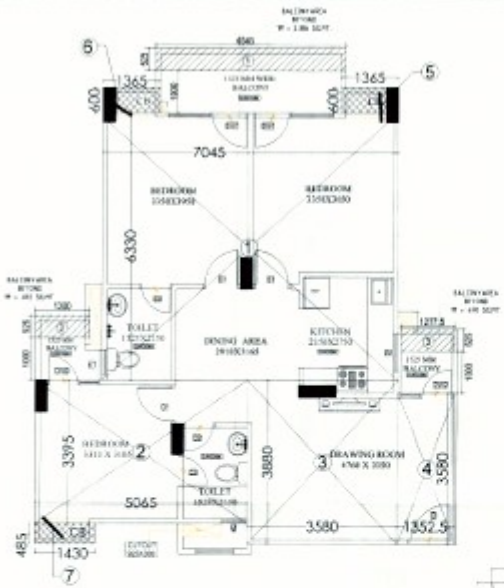

AREA STATEMENT (TYPE -5)

S.NO.	DIMENSION	AREA (sq.mt.)
1.	7.045 X 6.330	44.594
2.	5.065 X 3.395	17.195
3.	3.580 X 3.880	13.890
4.	1.352 X 3.580	4.840
5.	1.365 X .600	.819
6.	1.365 X .600	.819
7.	1.430 X .485	.693
	TOTAL	82.85

BALCONY AREA IN COMPOUNDING (Type -5)

TYPE OF FLAT	BALCONY NO	TOTAL BALCONY AREA PER FLOOR
TYPE-5	1	2.38 X 3 nos. = 15.000
	2	1.00 X 3 nos. = 3.0
	3	6.00 X 0 nos. = 5.30
	TOTAL	18.000 sq.mt

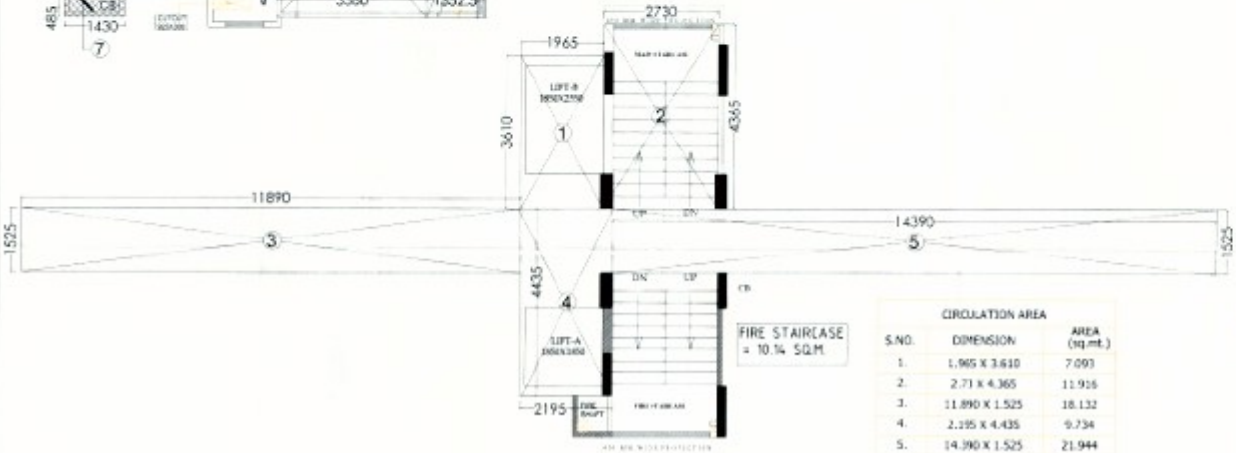

CIRCULATION AREA

S.NO.	DIMENSION	AREA (sq.mt.)
1.	1.965 X 3.610	7.093
2.	2.71 X 4.365	11.916
3.	11.890 X 1.525	18.132
4.	2.195 X 4.435	9.734
5.	14.390 X 1.525	21.944
	TOTAL	68.819

BLOCK - C			
Flat Area			
Type - 5	82.85	08 Nos.	662.80 SQ.MT
TOTAL AREA (FLATS)			662.80 SQ.MT
CIRCULATION AREA			68.819 SQ.MT
TOTAL FIRST FLOOR AREA = 731.619 SQ.MT			
TOTAL STILT FLOOR AREA(PARKING) = 731.619 SQ.MT			
(LIFT - A) = (1.850 X 1.850)		= 3.423 sq.m	
(LIFT - B) = (1.850 X 1.850)		= 3.423 sq.m	
TOTAL LIFT AREA		= 6.846 sq.mt.	

TYPICAL FLOOR AREA
= TOTAL FIRST FLOOR AREA - LIFT AREA
= 731.619 - 6.846 SQ. MT.
= 724.48 SQ. MT.

AREA STATEMENT

S.No.	FLOORS	AREA (sq.mt.)	UNITS
1	STILT (PARKING)		
2	FIRST FLOOR (RESIDENTIAL)		5
3	SECOND FLOOR (RESIDENTIAL)		5
4	THIRD FLOOR (RESIDENTIAL)		5
5	FOURTH FLOOR (RESIDENTIAL)		5
6	FIFTH FLOOR (RESIDENTIAL)		5
7	SIXTH FLOOR (RESIDENTIAL)		5
8	SEVENTH FLOOR (RESIDENTIAL)		5
9	EIGHT FLOOR (RESIDENTIAL)		5
10	NINETH FLOOR (RESIDENTIAL)		5
11	TENTH FLOOR (RESIDENTIAL)		5
12	ELEVENTH FLOOR (RESIDENTIAL)		5
13	TWELVETH FLOOR (RESIDENTIAL)		5
14	THIRTEENTH FLOOR (RESIDENTIAL)		5
15	FOURTEENTH FLOOR (RESIDENTIAL)		5
	TOTAL (2 TO 15 FL.)	10104.893	70

SUBJECT:
COMPOUNDING DRAWINGS FOR
GROUP HOUSING " PRITUNE RESIDENCY"
AT KHASRA NO. 1101 & 1116
AT VILLAGE HIDAYAGAR GHAZIABAD (UP)

OWNER:
M/s. KALL INFRASTRUCTURE (P) LTD.

DRAWING TITLE:
(BLOCK - C)
FLOOR PLAN (AREA CALCULATION)
(TYPICAL FLOOR PLAN)

OWNER SIGN — ARCHITECT SIGN


DATE	DRAWN BY	CHECKED BY	DRAWING NO.
8/11			CD-14

SECTION - AA

FRONT ELEVATION

PROJECT :	OWNER:		DRAWING TITLE	
COMPOUNDING DRAWINGS FOR GROUP HOUSING " FORTUNE RESIDENCY" AT KHASRA NO -1123 &1116 AT VILLAGE NOORNAGAR GHAZIABAD (UP)	M/s VASU INFRASTRUCTURE P.) LTD AND OTHERS	DIRECTOR	ELEVATION & SECTION (BLOCK - C)	CO-15

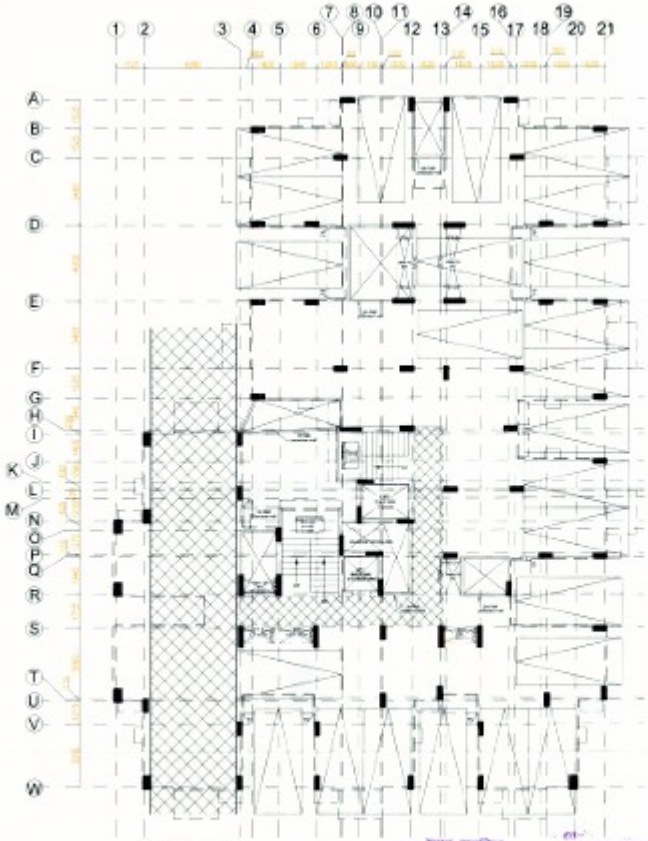

STILT PLAN
(EXISTING)

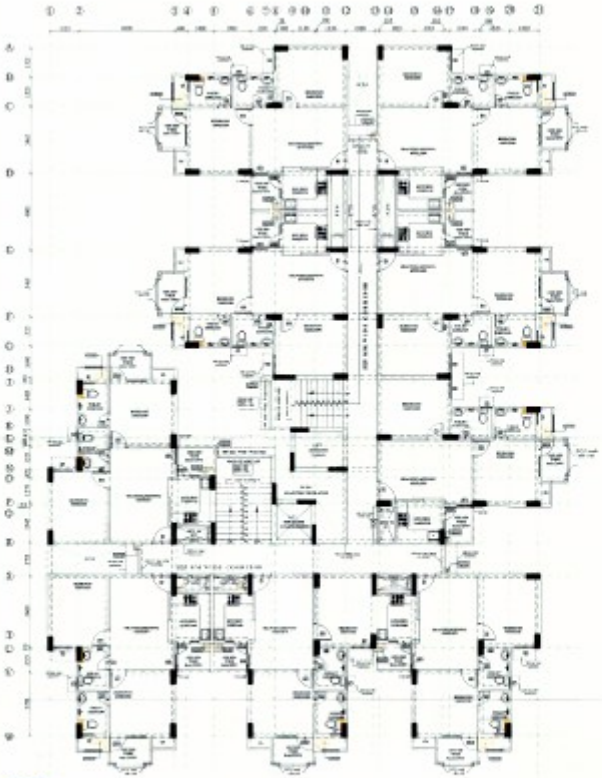

1st to 14th FLOOR PLAN
(EXISTING)

OPENING SCHEDULE OF DOORS & WINDOWS					
SNO	TYPE	SIZE (MM)	SILL (MM)	LINTEL
1	D1	1000 X 2100	0.00	2100
2	D2	1200 X 2100	0.00	2100
3	D	1000 X 2100	0.00	2100
4	D1	900 X 2100	0.00	2100
5	D2	750 X 2100	0.00	2100
6	W	1500 X 1100	1200	2350
7	W1	900 X 1100	1200	2350
8	V	600 X 1100	1200	2350
9	V1	600 X 900	1200	2350

PROJECT
COMPOUNDING DRAWINGS FOR
GROUP HOUSING "FORTUNE RESIDENCY"
AT KHASRA NO. 1125 &1118
AT VILLAGE NOORNAGAR GHAZIABAD (UP)

OWNER
M/s. AMU INFRASTRUCTURE (P.) LTD
AND OTHERS

DRAWING TITLE
(BLOCK - D) (EXISTING)
STILT to 14th FLOOR PLAN

DRAWER SIGN
ARCHITECT SIGN


SCALE 1:100 | DATE | DRAWN BY | CHECKED BY | DRAWING NO.
CD-16

TERRACE FLOOR PLAN

(EXISTING)

PROJECT

COMPOUNDING DRAWINGS FOR
GROUP HOUSING " FORTUNE RESIDENCY"
AT KHASRA NO. 1123 &1198
AT VILLAGE NOORNAGAR GHAZIABAD (UP)

OWNER

M/s. VASU INFRASTRUCTURE (P.) LTD
AND OTHERS

DRAWING TITLE

(BLOCK - D) (EXISTING)
TERRACE FLOOR PLAN

OWNER SIGN	ARCHITECT SIGN	SCALE	DATE	DRAWN BY	CHECKED BY	SHEET NO
		N.T.S.		POOJA		CD-17

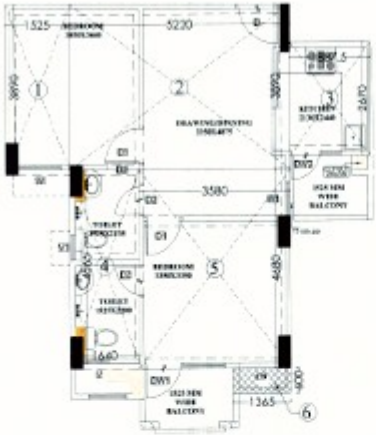

AREA STATEMENT (TYPE -3)

S.NO.	DIMENSION	AREA (sq.mt.)
1.	1.525 X 3.890	5.932
2.	5.220 X 3.890	20.305
3.	1.887 X 2.67	5.038
4.	1.640 X 4.565	7.486
5.	3.580 X 4.680	16.754
6.	1.365 X .600	.819
	TOTAL	56.334

BALCONY AREA IN COMPOUNDING (Type -3)

TYPE OF FLAT	BALCONY NO.	TOTAL BALCONY AREA PER FLOOR
TYPE-3	1	1.146 X 9 nos. = 10.314
	2	.951 x 9 nos. = 8.559
	TOTAL	18.873 sq.mt.

CIRCULATION AREA

S.NO.	DIMENSION	AREA (sq.mt.)
1.	3.882 X 1.525	5.920
2.	3.230 X .985	3.181
3.	3.287 X 5.105	16.780
4.	2.195 X 3.835	8.417
5.	1.515 X 1.640	2.484
6.	1.525 X 17.440	26.596
7.	3.010 X 2.310	6.953
8.	1.640 X 5.290	8.675
9.	3.580 X 1.525	5.459
	TOTAL	84.465

FIRE STAIRCASE = 10.82 SQ. M.

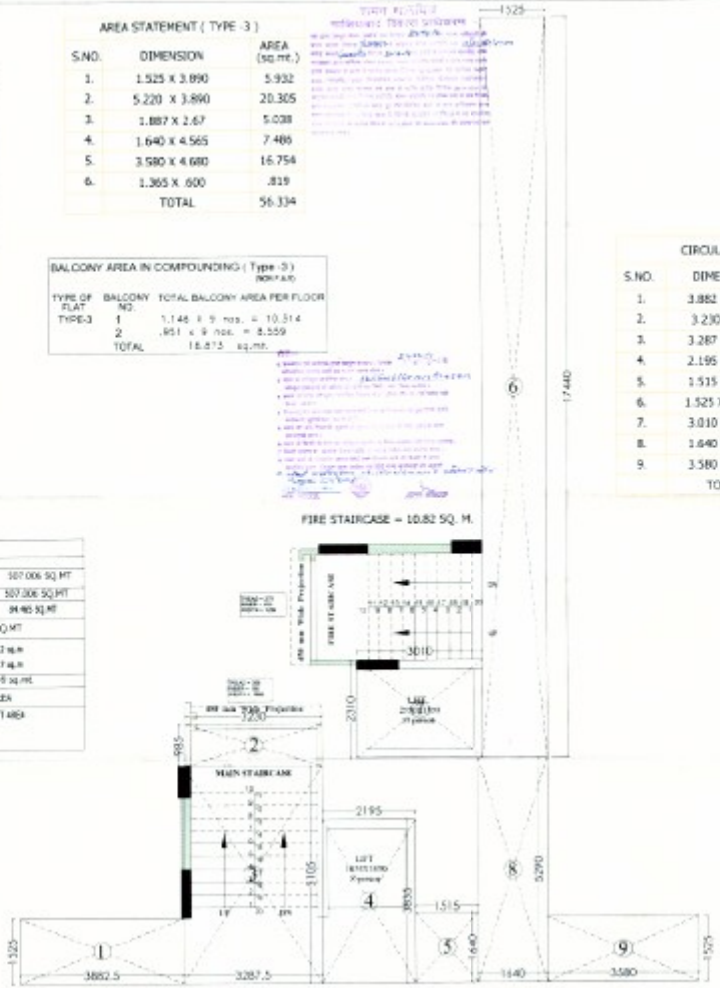

BLDCK - D (FIRST FLOOR AREA)

Flat Area			
Type - 3	56.334	09 Nos.	507.006 SQ MT
TOTAL AREA (FLATS)			507.006 SQ MT
CIRCULATION AREA			84.465 SQ MT
TOTAL b/e FLOOR AREA = 591.471 SQ MT			
(LIFT - A) = (1.850 X 1.850)			= 3.423 sq.m
(LIFT - B) = (2.030 X 1.850)			= 4.717 sq.m
TOTAL LIFT AREA			= 8.139 sq.mt.
SECOND TO FOURTEENTH FLOOR AREA			
= TOTAL UPPER GROUND FLOOR AREA - LIFT AREA = 591.471 - 8.139 SQ MT. = 583.332 SQ MT.			

AREA STATEMENT

S.NO.	FLOORS	AREA (sq.mt.)	UNITS
1	STILT (NON F.A.R. USAGE)		
2	FIRST FLOOR (USAGE)		9
3	SECOND FLOOR (USAGE)		9
4	THIRD FLOOR (USAGE)		9
5	FOURTH FLOOR (USAGE)		9
6	FIFTH FLOOR (USAGE)		9
7	SIXTH FLOOR (USAGE)		9
8	SEVENTH FLOOR (USAGE)		9
9	EIGHTH FLOOR (USAGE)		9
10	NINETH FLOOR (USAGE)		9
11	TENTH FLOOR (USAGE)		9
12	ELEVENTH FLOOR (USAGE)		9
13	TWELVETH FLOOR (USAGE)		9
14	THIRTEENTH FLOOR (USAGE)		9
15	FOURTEENTH FLOOR (USAGE)		9
	TOTAL(Col. 11)	6174.787	

PROJECT:
COMPOUNDING DRAWINGS FOR
GROUP HOUSING " FORTUNE RESIDENCY"
AT KHASRA NO.-1123, 1118
AT VILLAGE NIZORNAGAR GHAZIABAD (UP)

OWNER:
M/s. UJJU INFRASTRUCTURE PVT. LTD.

DRAWING TITLE: (BLOCK - D)
FLOOR PLAN (AREA CALCULATION)
(UP TO 14th FLOOR PLAN)

OWNER SIGN | ARCHITECT SIGN


SCALE	DATE	DRAWN BY	CHECKED BY	SHEET NO.
NTS				CD-10

ELEVATION

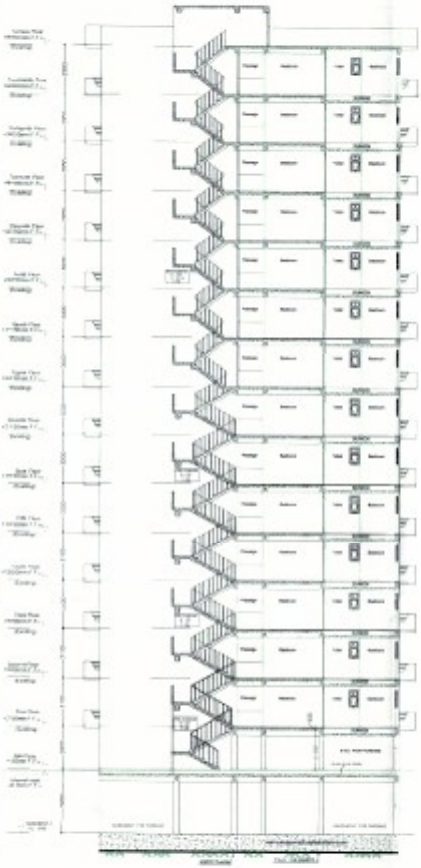

SECTION - AA

ELEVATION X

PROJECT :	OWNER:			DRAWING TITLE	
COMPOUNDING DRAWINGS FOR GROUP HOUSING " FORTUNE RESIDENCY" AT KHASRA NO.-1123, 1116 AT VILLAGE NOORNAGAR GHAZIABAD (UP)	M/s. VASU INFRASTRUCTURE P. LTD AND OTHERS	OWNER'S SIGN	ARCHITECT'S SIGN	ELEVATION & SECTION (BLOCK - D)	SD-03

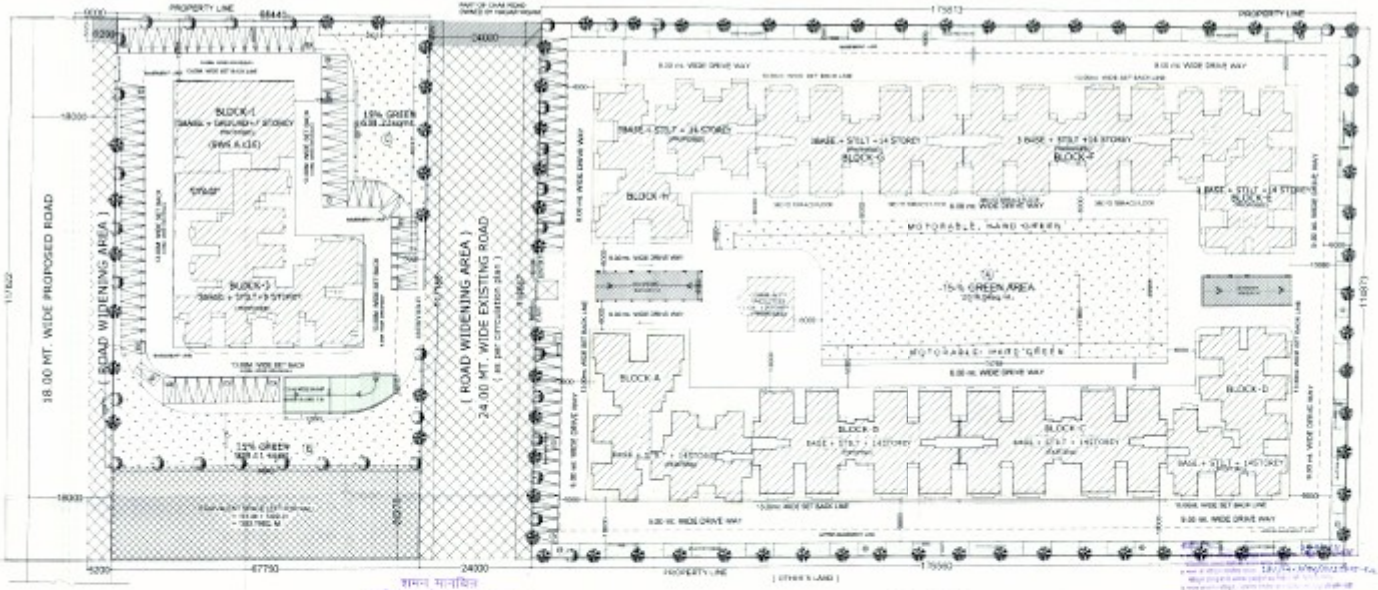

SITE PLAN

AREA STATEMENT

KHASRA/KEY PLAN

PREVIOUS COMPOUNDING AREA DETAIL

PROJECT:
COMPOUNDING DRAWINGS FOR
GROUP HOUSING "FORTUNE RESIDENCY"
AT KHSRA NO. 1123, 1178

DRAWING TITLE:
SITE PLAN

OWNER SIGN | ARCHITECT SIGN

ARCHITECTS ENGINEERS & PLANNERS

SCALE | DATE | DRAWN BY | CHECKED BY | SHEET NO.
CD-01

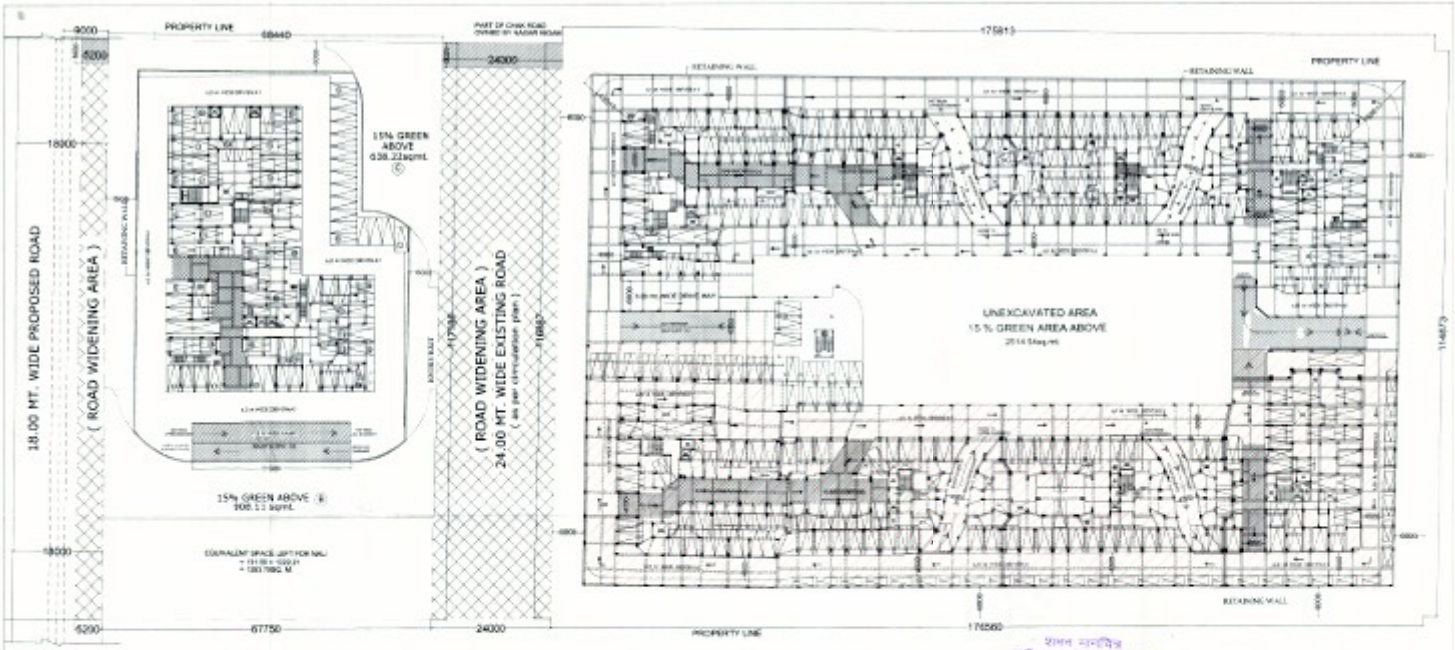

FIRST BASEMENT FLOOR PLAN

EXISTING BASEMENT AREA

PROJECT:
COMPOUNDING DRAWINGS FOR
GROUP HOUSING " FORTUNE RESIDENCY "
AT KHASRA NO.-1125 &1126
AT VILLAGE- ROORKHAGAR GHAZIABAD (UP)

BASEMENT PLAN

OWNER SIGN | ARCHITECT SIGN

SHEET NO. CD-02