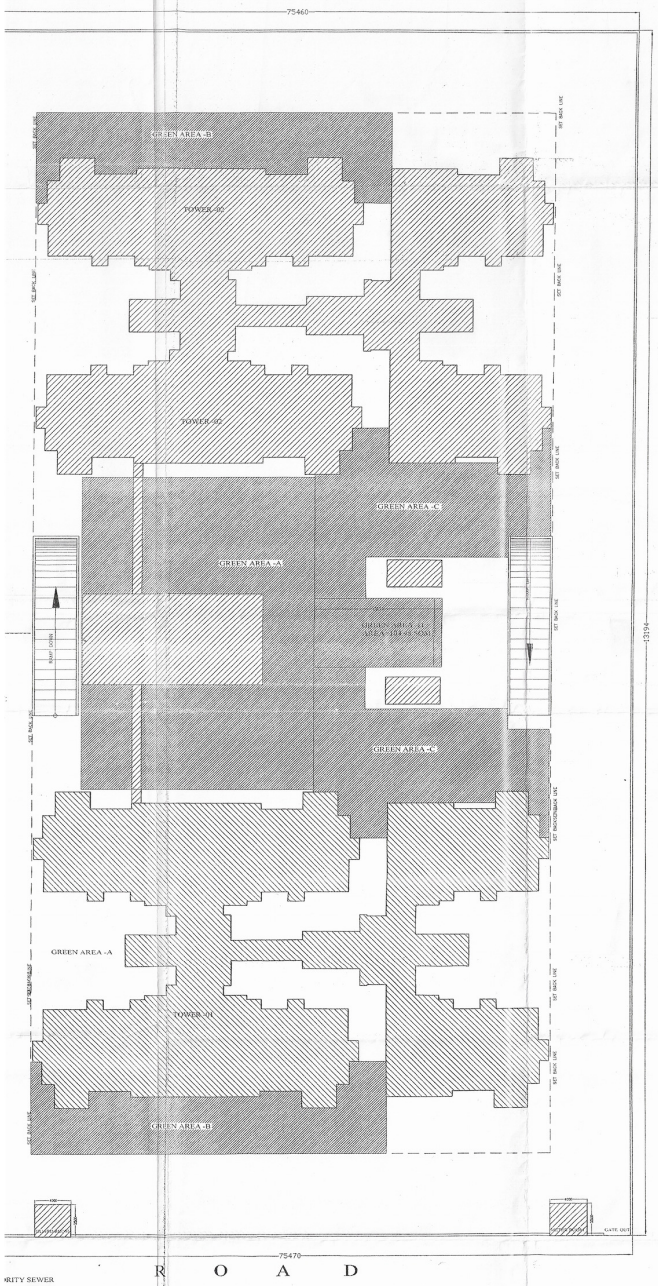

SITE PLAN

SERVICES PLAN

DRG. NO.

AREA STATEMENT

TOTAL PLOT AREA = 10000.37 SQM.
PERM. COVD. AREA ON GROUND FLOOR@35% =3500.00 SQM.
PROP. COVD. AREA ON GROUND FLOOR = ~~2554.382~~ SQM.
PERM. FAR@275% = 27500.00 SQM.
PROP. FAR = ~~27377.86 SQM. (@275~~)

AREA UNDER STILT=1133.091 SQM.
CARS PROVIDED UNDER STILTS=1133/30=37.7 SAY 37 NOS.
CARS PROVIDED IN BASEMENT=173 NOS.

TREES REQ = 7029.52/100 = 71 NOS
TREES PROP = 100 ALL ABOVE GROUND.

LANDSCAPE DETAIL

TOTAL GR. COVERAGE=10000.37 - 2554.382 = 2027.52 SQM.
GREEN REQ= ~~7445.82/4=1861.46 SQM.~~
7029.52/4 = 1757.382

GREEN PROPOSED 2004.39 SQM.

SUBMISSION DRAWING

SHEET TITLE
LANDSCAPE PLAN

ARCHITECT:

PROJECT
KAMRUP HOUSING PROJECTS (PVT)LTD.
PROPOSED GROUP HOUSING FOR
PLOT NO. GH-08A, SECTOR-CHI-V
GREATER NOIDA.

SCALE	DATE

ARCHITECT'S SIGNATURE

OWNER'S SIGNATURE

KAMRUP HOUSING PROJECTS PVT
L1/7, Hauz Khas Enclave
New Delhi-110016
Ph..26516696/9899415575