12.0 MT. WIDE ROAD

45.0 MT. WIDE ROAD

ADJ. GROUP HOUSING

45.0 MT. WIDE ROAD

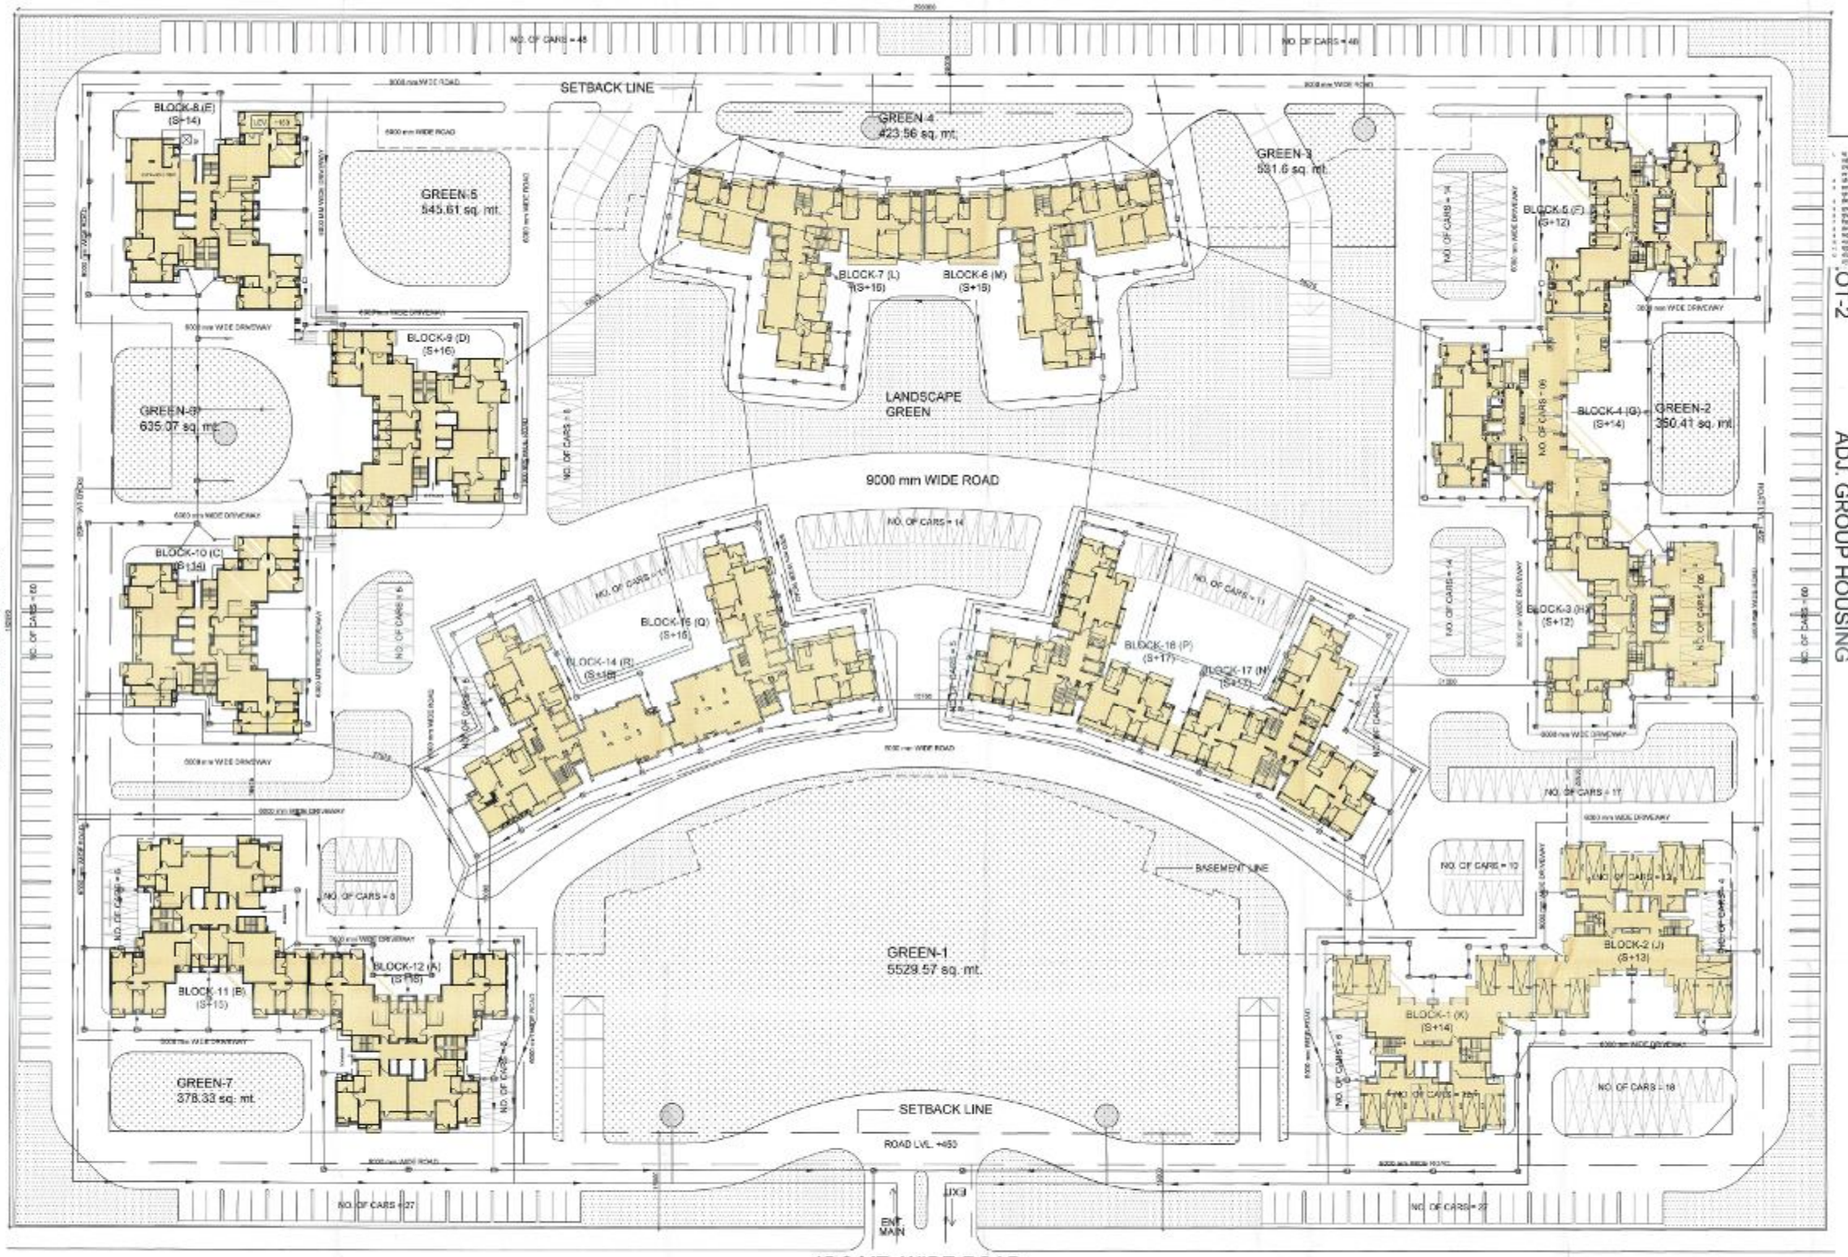

PROJECT:

AS BUILT DRAWING OF GROUP HOUSING (CELEBRITY GREENS) ON PLOT -1 (13.83 ACRES) AT POCKET-1,SECTOR-B , SUSHANT GOLF CITY, HI-TECH TOWNSHIP, LUCKNOW.

CALCULATIONS OF AREAS						
			AREA			
SL. NO.		No./(%)	(sq.m.)	(acres)	(hac)
1	PLOT AREA		**55961.000**	**13.82**	**5.6**
2	PERMISSIBLE GROUND COVERAGE ON PLOT AREA	40%	22,384.400	5.53	2.24
3	ACHIEVED GROUND COVERAGE	15%	8,191.928		
4	PERMISSIBLE FAR ON PLOT AREA	2.5	1,39,902.50	34.56	13.99
5	ACHIEVED F.A.R.	2.2	1,23,139.590		
6	PERMISSIBLE DENSITY ON NET PLOT AREA	1119	UNITS		
	@200 UNITS/ HACTARE				
7	ACHIEVED UNITS	827	UNITS		
8	PROVIDED GREEN AREA	15.00%	8,394.15	2.07	0.84

Detailed Calculation of Green

Name	Area (in Sq.mt.)
G1	5529.57
G2	350.41
G3	531.6
G4	423.56
G5	545.61
G6	635.07
G7	378.33
TOTAL	**8394.15**

legend

- sewer line
- water supply line
- drain line
- MH man hole
- r.w.h. pit

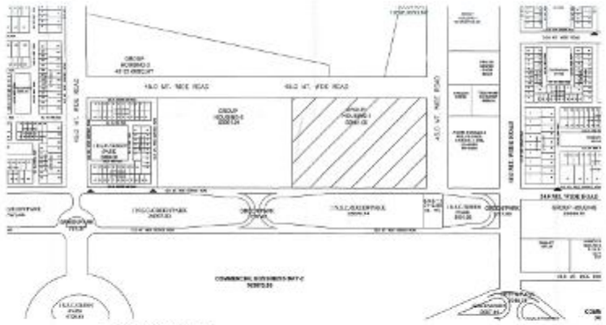

LOCATION PLAN
(SCALE N.T.S)

AS BUILT DRG. TILL DATE 25.06.15

CELEBRITY GREENS

OWNERS
ANSAL PROPERTIES & INFRASTRUCTURE LTD.
115, ANSAL BHAWAN, 16 KG MARG
NEW DELHI-110001

CONSULTANT
REPL
RISHABHDEV ENTERPRISES PVT. LTD.
TOWN & COUNTRY PLANNERS, ARCHITECTS & INTERIOR DESIGNERS,SURVEY CIVIL, SERVICES DESIGNERS
GROUND FLOOR, YUVA BHAWAN, HCA COMPLEX, 13 RANA PRATAP MARG, LUCKNOW.
CALL – (0522) 2206165

SHEET TITLE
LANDSCAPE AND SERVICES PLAN

DRAWN BY: VIRENDRA KUMAR
CHECKED BY:
DRAWN BY: SALEEM
CHECKED BY:

Scale 1:200 | Date 25.06.2015 | Drg. No. LKO/CELEBRITY GREEN/ | Rev.

PROJECT:

AS BUILT DRAWING OF GROUP HOUSING (CELEBRITY GREENS) ON PLOT -1 (13.83 ACRES) AT POCKET-1,SECTOR-B , SUSHANT GOLF CITY, HI-TECH TOWNSHIP, LUCKNOW.

BASEMENT PLAN
28173.63 sq. mt.

TOTAL PARKING IN BASEMENT =640 ECS

CELEBRITY GREENS

OWNERS
ANSAL PROPERTIES & INFRASTRUCTURE LTD.
115, ANSAL BHAWAN , 16 K.G MARG
NEW DELHI-110001

CONSULTANT
REPL
RUDRABHISHEK ENTERPRISES PVT. LTD.
TOWN & COUNTRY PLANNERS, ARCHITECTS & INTERIOR DESIGNERS,SURVEY CIVIC, SERVICES DESIGNERS.
GROUND FLOOR, YUVA BHAWAN,YMCA COMPLEX, 13 RANA PRATAP MARG LUCKNOW.
CALL – (0522) 2206165

SHEET TITLE
BASEMENT PLAN

DEALT BY	CHECKED BY
BALNEET	VIRESH KUMAR

OWNER	ARCHITECT

Scale	Date	Drg. NO.	REV.
1:300	28-06-2015	LKO/GH/B-2/...03/53	

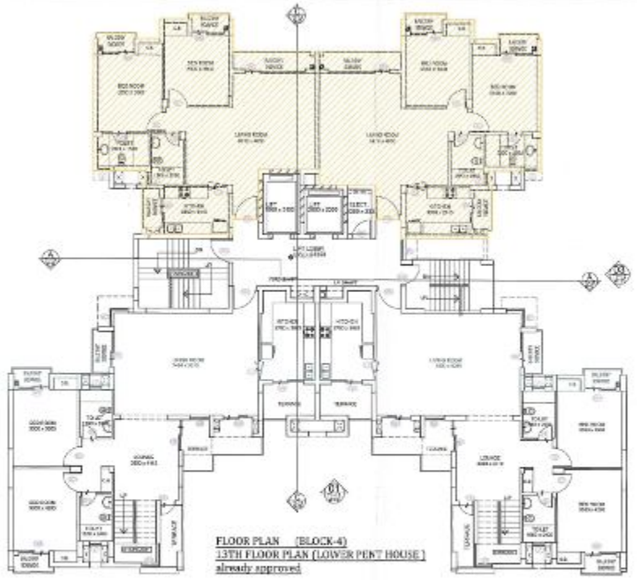

FLOOR PLAN (BLOCK-4)
13TH FLOOR PLAN (LOWER PENT HOUSE)
already approved

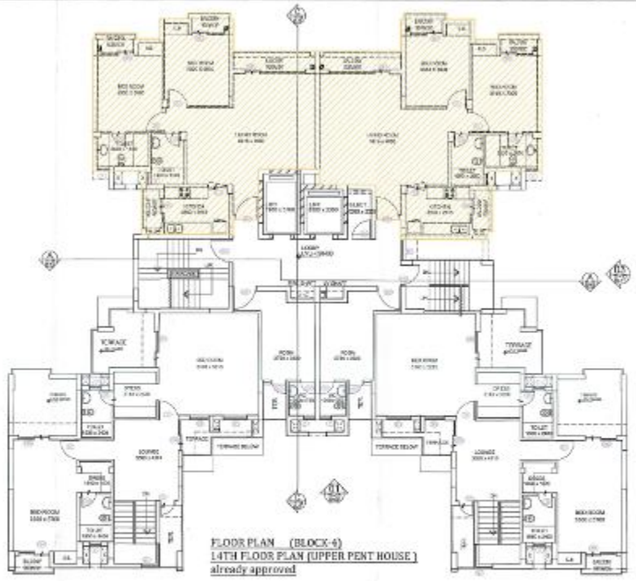

FLOOR PLAN (BLOCK-4)
14TH FLOOR PLAN (UPPER PENT HOUSE)
already approved

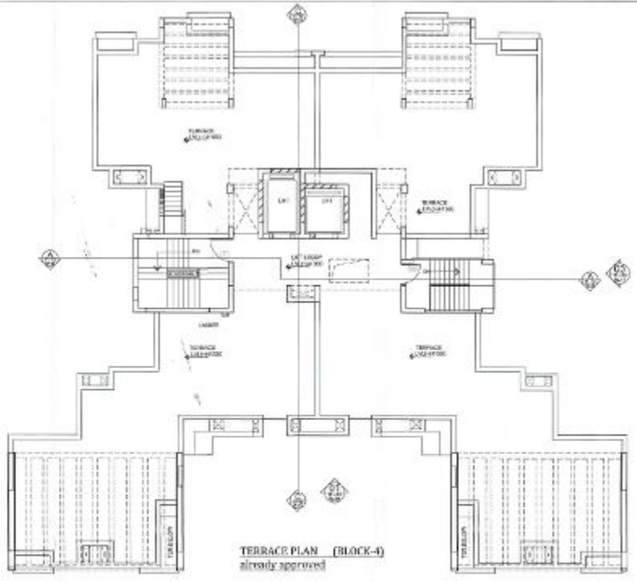

TERRACE PLAN (BLOCK-4)
already approved

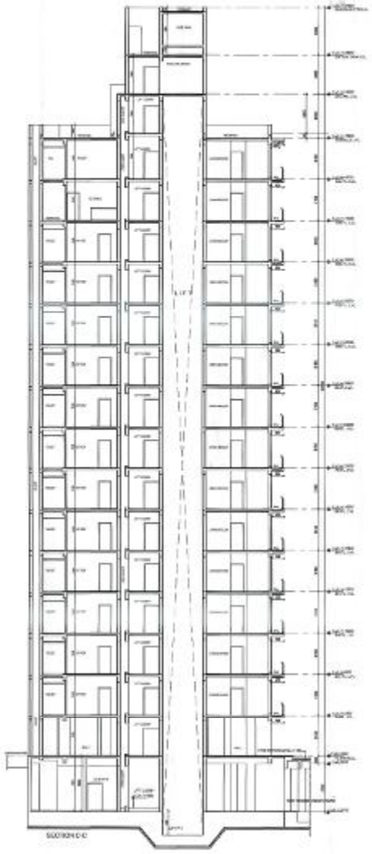

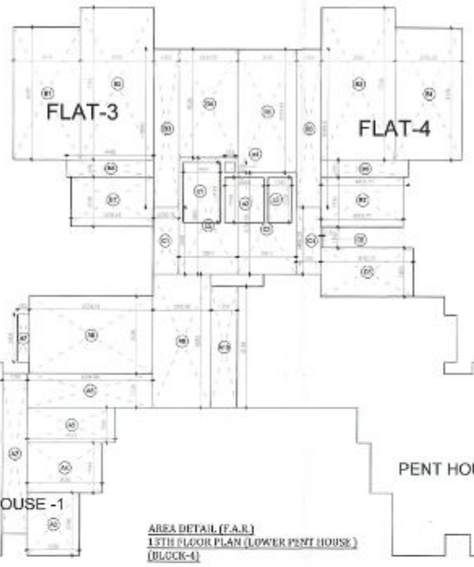

AREA DETAIL (F.A.R.)
13TH FLOOR PLAN (LOWER PENT HOUSE)
(BLOCK-4)

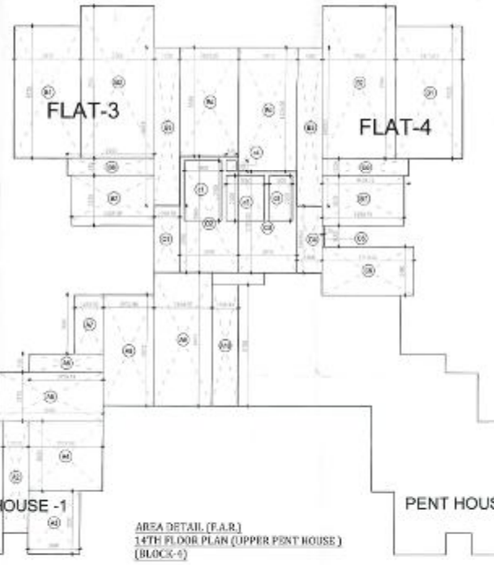

AREA DETAIL (F.A.R.)
14TH FLOOR PLAN (UPPER PENT HOUSE)
(BLOCK-4)

AREA (13TH FLOOR (F.A.R. AREA)				
AREA FOR FLAT-3				
TO BE ADDED				
NAME	LEN (FT-INCH)	WIDTH (FT-I	NO.	AREA (SQ.MT.)
A1	3.000	5.374	1	16.122
A3	11.260	8.376	1	94.284
A2	1.000	5.000	1	5.000
A5	5.460	3.876	1	21.167
A6	4.000	1.800	1	7.200
A4	5.460	1.376	1	7.513
A7	5.000	3.500	1	17.500
A8	6.500	4.500	1	29.250
A9	3.960	4.800	1	19.008
A10	3.260	4.000	1	13.040
		TOTAL	=	240.084
TOTAL AREA FOR FLAT-3			=	240.084
TOTAL AREA FOR FLAT-3			=	240.084

AREA FOR FLAT-2				
TO BE ADDED				
NAME	LEN (FT-INCH)	WIDTH (FT-I	NO.	AREA (SQ.MT.)
B1	5.915	4.708	1	27.844
B2	2.000	1.740	1	3.480
B3	3.960	4.000	1	15.840
B4	3.960	3.960	1	14.602
B5	3.960	4.960	1	19.642
B6	4.960	3.960	1	19.642
B7	4.833	3.500	1	16.916
TOTAL AREA FOR FLAT-2			=	117.966

AREA FOR FLAT-4				
TO BE ADDED				
NAME	LEN (FT-INCH)	WIDTH (FT-I	NO.	AREA (SQ.MT.)
B1	5.915	4.708	1	27.844
B2	5.750	7.750	1	44.563
B3	3.750	7.750	1	29.063
B4	3.960	4.960	1	19.642
B5	3.960	3.960	1	15.682
B6	4.960	3.960	1	19.642
B7	4.833	3.500	1	16.916
TOTAL AREA FOR FLAT-4			=	173.352

AREA FOR CIRCULATION				
TO BE ADDED				
NAME	LEN (FT-INCH)	WIDTH (FT-I	NO.	AREA (SQ.MT.)
C1	3.000	5.000	1	14.850
C2	3.810	3.740	1	13.249
C3	3.834	5.740	1	20.450
C4	5.260	3.496	1	17.730
C5	3.510	3.160	1	10.309
C6	3.510	3.160	1	10.309
		TOTAL	=	96.894
		STAIRCASE		
S1	5.260	3.126	1	15.850
S2	3.960	3.126	1	11.933
S3	5.260	3.126	1	15.850
S4	7.000	3.126	1	21.882
		TOTAL	=	65.515
TOTAL AREA FOR CIRCULATION			=	162.409
TOTAL (F.A.R. AREA)			=	693.811

AREA (14TH FLOOR (F.A.R. AREA)				
AREA FOR FLAT-1				
TO BE ADDED				
NAME	LEN (FT-INCH)	WIDTH (FT-I	NO.	AREA (SQ.MT.)
A1	3.000	5.500	1	15.907
A3	11.260	8.376	1	94.284
A2	1.000	5.000	1	5.000
A5	5.460	3.876	1	21.167
A6	4.000	1.800	1	7.200
A4	5.460	1.376	1	7.513
A7	5.000	3.500	1	17.500
A8	6.500	4.500	1	29.250
A9	3.960	4.800	1	19.008
A10	3.260	4.000	1	13.040
		TOTAL	=	238.869
TOTAL AREA FOR FLAT-1			=	238.869
TOTAL AREA FOR FLAT-1			=	238.869

AREA FOR FLAT-3				
TO BE ADDED				
NAME	LEN (FT-INCH)	WIDTH (FT-I	NO.	AREA (SQ.MT.)
B1	5.915	4.708	1	27.844
B2	3.750	7.750	1	29.063
B3	3.960	3.960	1	15.682
B4	3.960	3.960	1	15.682
B5	4.960	3.960	1	19.642
B6	4.960	3.960	1	19.642
B7	4.833	3.500	1	16.916
TOTAL AREA FOR FLAT-3			=	144.467

AREA FOR FLAT-5				
TO BE ADDED				
NAME	LEN (FT-INCH)	WIDTH (FT-I	NO.	AREA (SQ.MT.)
B1	5.915	4.725	1	27.934
B2	5.750	7.750	1	44.563
B3	3.960	3.960	1	15.682
B4	3.960	3.960	1	15.682
B5	4.960	3.960	1	19.642
B6	4.960	3.960	1	19.642
B7	4.833	3.500	1	16.916
TOTAL AREA FOR FLAT-5			=	159.861

AREA FOR CIRCULATION				
TO BE ADDED				
NAME	LEN (FT-INCH)	WIDTH (FT-I	NO.	AREA (SQ.MT.)
C1	3.000	5.000	1	14.850
C2	3.810	3.740	1	13.249
C3	3.834	5.740	1	20.450
C4	5.260	3.496	1	17.730
C5	3.510	3.160	1	10.309
C6	3.510	3.160	1	10.309
		TOTAL	=	96.894
		STAIRCASE		
S1	5.260	3.126	1	15.850
S2	3.960	3.126	1	11.933
S3	5.260	3.126	1	15.850
S4	7.000	3.126	1	21.882
		TOTAL	=	65.515
TOTAL AREA FOR CIRCULATION			=	162.409
TOTAL (F.A.R. AREA)			=	547.736

AREA (13TH & 14TH FLOOR (COMPOUNDING AREA)				
TO BE ADDED				

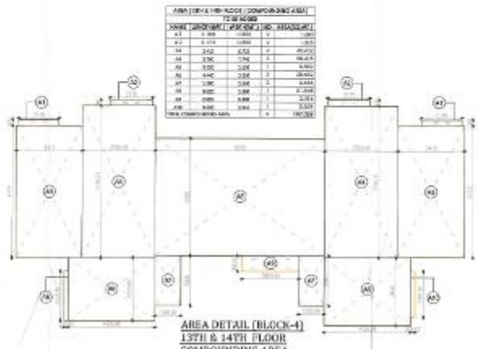

AREA DETAIL (BLOCK-4)
13TH & 14TH FLOOR
COMPOUNDING AREA

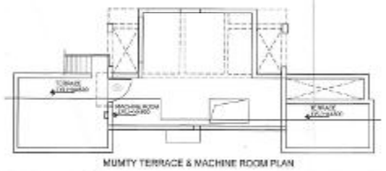

MUMTY TERRACE & MACHINE ROOM PLAN

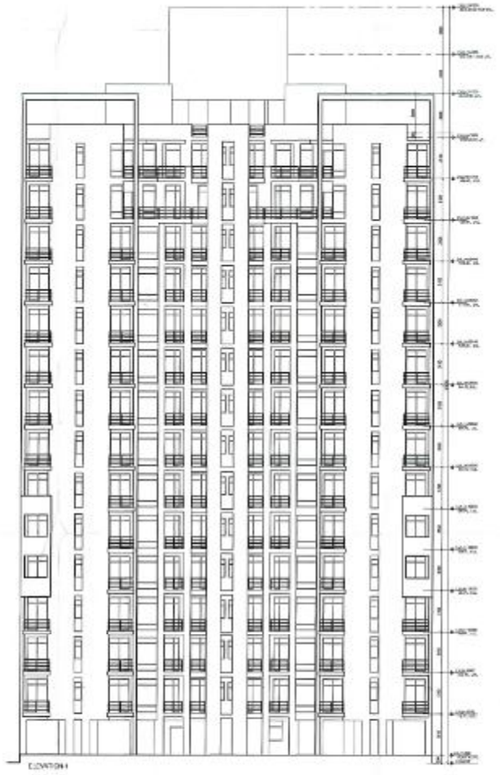

ELEVATION

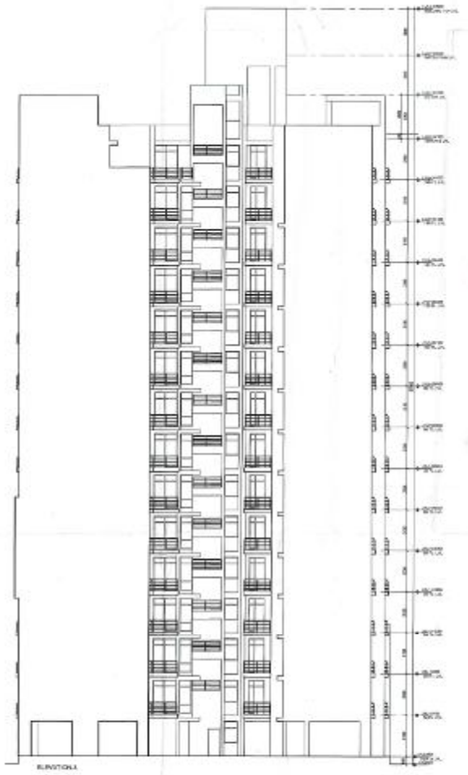

ELEVATION

PROJECT:

AS BUILT DRAWING OF GROUP HOUSING (CELEBRITY GREENS) ON PLOT -1 (13.83 ACRES) AT POCKET-1,SECTOR-B , SUSHANT GOLF CITY, HI-TECH TOWNSHIP, LUCKNOW.

COMPOUNDABLE AREA

VARIATIONS

BLOCK-4(G)
(CELEBRITY GREENS)

OWNERS

ANSAL PROPERTIES & INFRASTRUCTURE LTD.
115, ANSAL BHAWAN , 15 K.G MARG
NEW DELHI-110001

CONSULTANT

REPL

RUDRAM+ISHIKA ENTERPRISES PVT. LTD.
TOWN & COUNTRY PLANNERS, ARCHITECTS & INTERIOR DESIGNERS,BUILDING CIVIL SERVICES DESIGNERS.
GROUND FLOOR, YUKA BHAWAN(YKOK COMPLEX), SHAKA PRATAP MARG LKO(NOW
CALL -(0522) 2300185

SHEET TITLE

FLOOR PLANS,ELEV. & AREA DETAIL
13th Floor to terrace lvl.

BLOCK TYPE	FLOOR
BLOCK - 4 (G)	G+14
DRAWN BY	CHECKED BY
BALWEET	
OWNER	ARCHITECT

Scale	Date	Drg. No.	REV.
1:128	23-06-2015	LKO/BRB/SD...1/1/02	



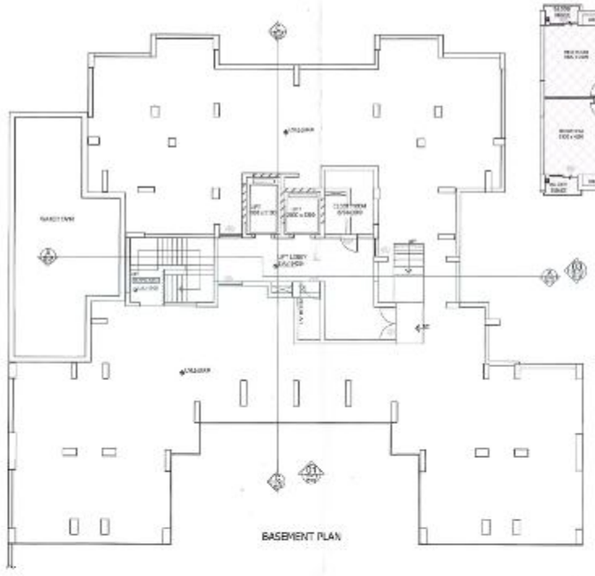

BASEMENT PLAN

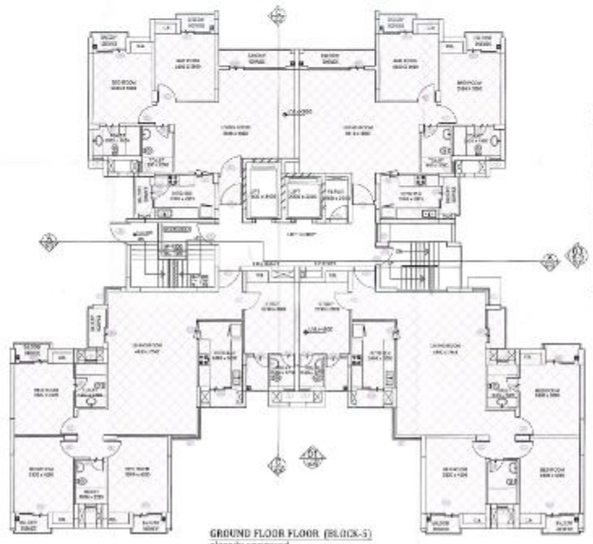

GROUND FLOOR FLOOR (BLOCK-S)
already approved

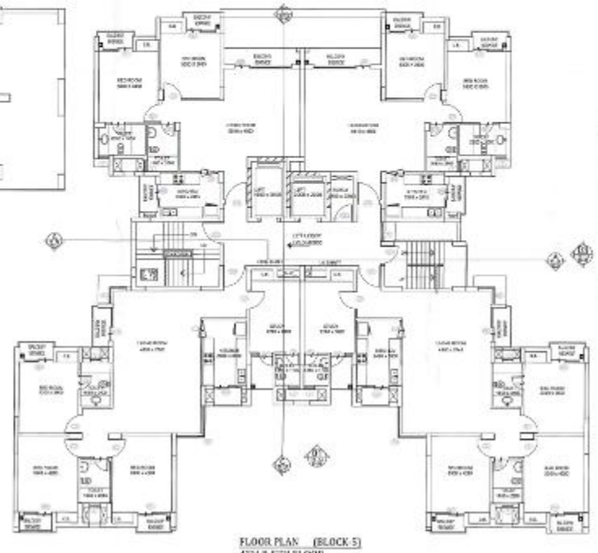

FLOOR PLAN (BLOCK-S)
4TH & 5TH FLOOR
already approved

FLOOR PLAN (BLOCK-S)
1 ST & 2ND FLOOR
already approved

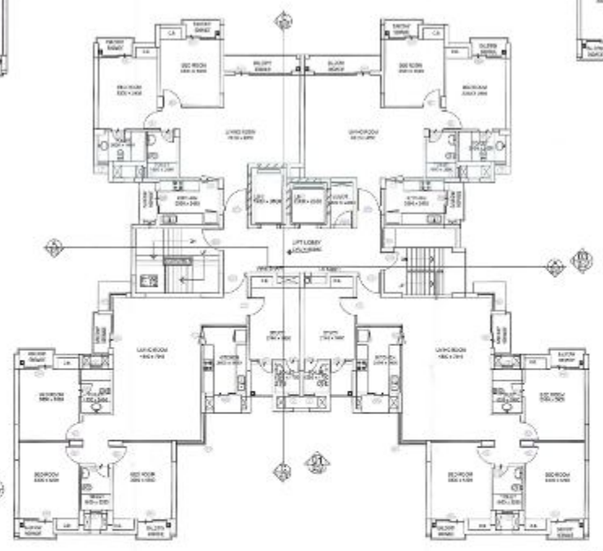

FLOOR PLAN (BLOCK-S)
6TH TO 10TH FLOOR
already approved

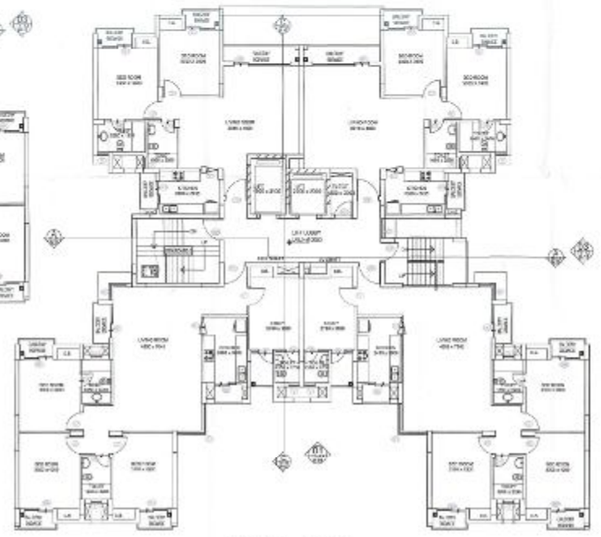

FLOOR PLAN (BLOCK-S)
3RD FLOOR
already approved

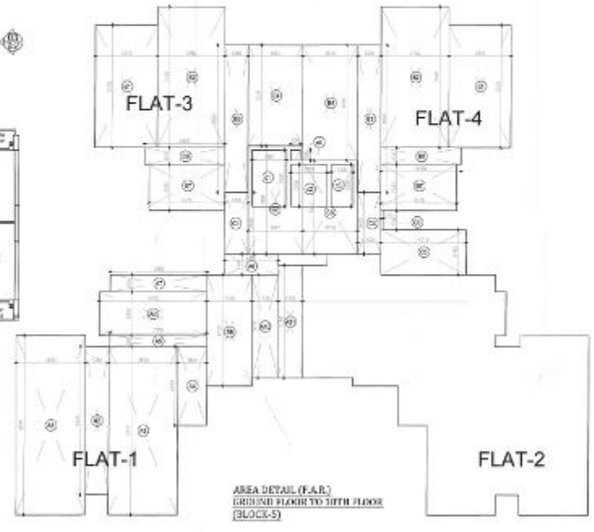

AREA DETAIL (F.A.R.)
GROUND FLOOR TO 10TH FLOOR
(BLOCK-S)

PROJECT

AS BUILT DRAWING OF GROUP HOUSING (CELEBRITY GREENS) ON PLOT -1 (13.83 ACRES) AT POCKET-1,SECTOR-B , SUSHANT GOLF CITY, HI-TECH TOWNSHIP, LUCKNOW.

COMPOUNDABLE AREA

VARIATIONS

AREA (GROUND TO 10TH FLOOR) (F.A.R. AREA)

AREA FOR FLAT-1

TO BE ADDED










TOTAL (F.A.R.) AREA			=	680.619

BLOCK-5 (F)
(CELEBRITY GREENS)

OWNERS
ANSAL PROPERTIES & INFRASTRUCTURE LTD.
115, ANSAL BHAWAN, 16 KG MARG
NEW DELHI-110001

CONSULTANT
REPL
REPL

SHEET TITLE
FLOOR PLANS & AREA DETAIL
Basement,Ground, 1st to 10th Floor

BLOCK TYPE	FLOOR
(BLOCK - S/F)	G+10
DRAWN BY	CHECKED BY
RAJU/FET	

Scale	Date	Dwg. No.	REV.
1:100	22/03/2013	LKO/GHS-2L-16/01	

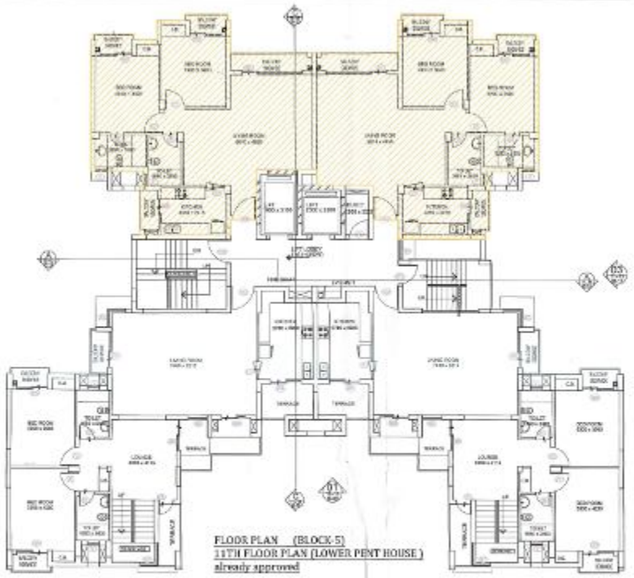

FLOOR PLAN (BLOCK-5)
11TH FLOOR PLAN (LOWER PENT HOUSE)
already approved

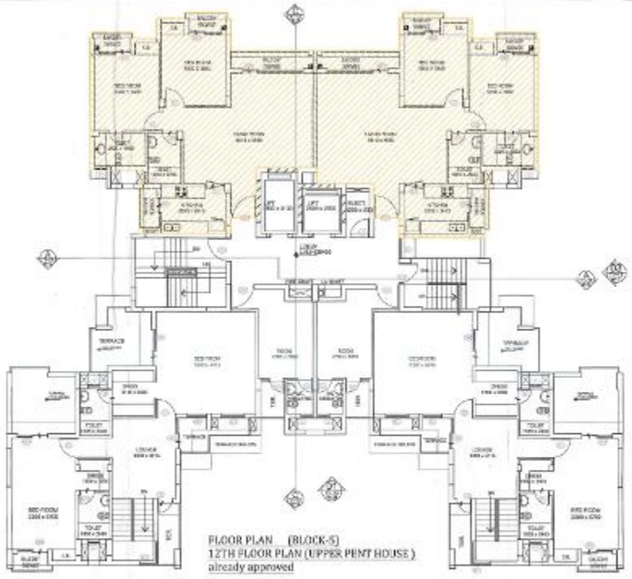

FLOOR PLAN (BLOCK-5)
12TH FLOOR PLAN (UPPER PENT HOUSE)
already approved

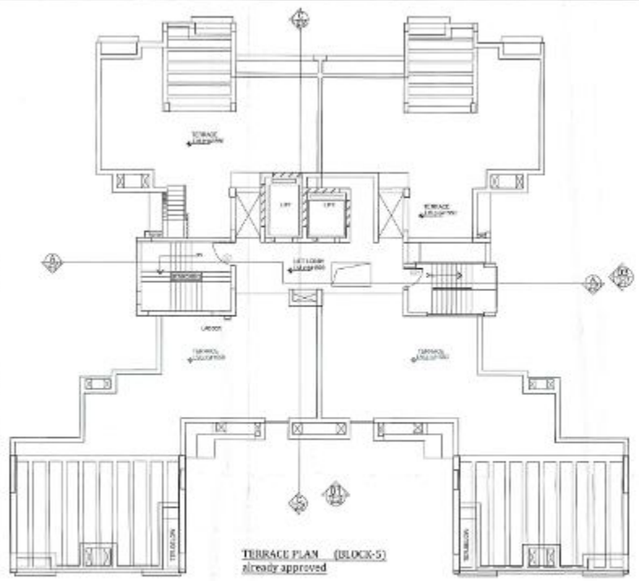

TERRACE PLAN (BLOCK-5)
already approved

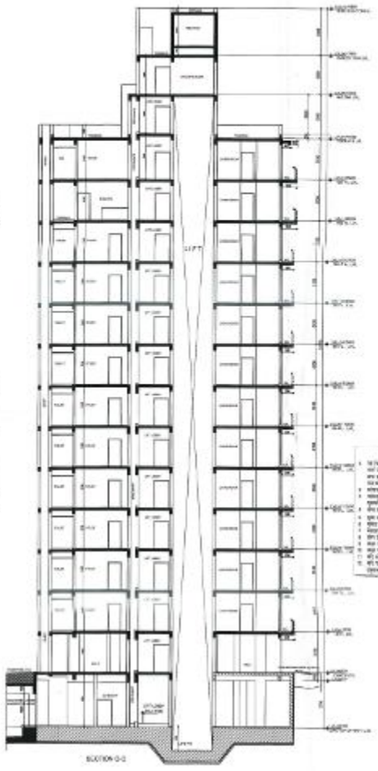

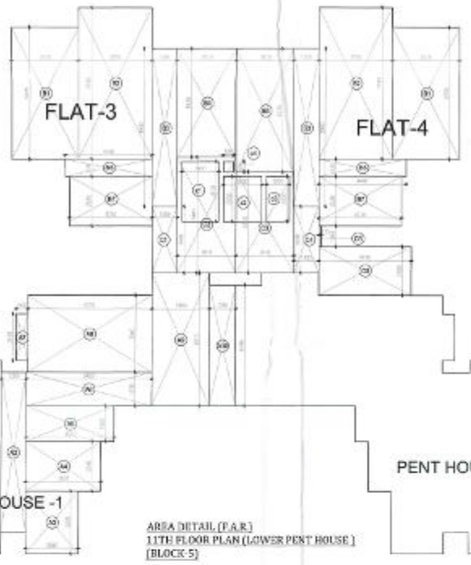

AREA DETAIL (F.A.R.)
11TH FLOOR PLAN (LOWER PENT HOUSE)
(BLOCK-5)

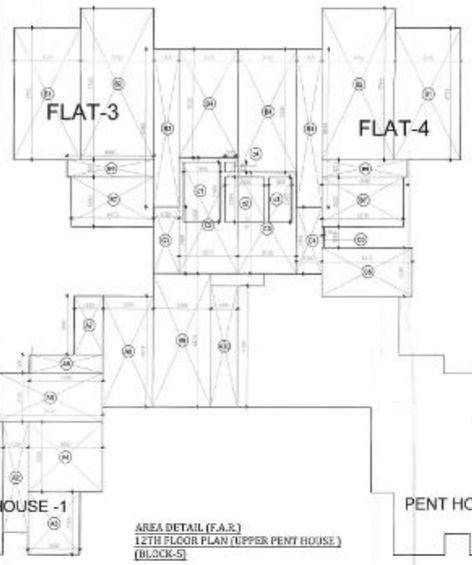

AREA DETAIL (F.A.R.)
12TH FLOOR PLAN (UPPER PENT HOUSE)
(BLOCK-5)

AREA (11TH FLOOR) (F.A.R. AREA)				
AREA FOR FLAT-3				
TO BE ADDED				
NAME	LENGTH(MT.)	WIDTH(MT.)	NO.	AREA(SQ.MT.)
A1	3.600	4.875	1	17.55
A2	1.280	5.150	1	12.864
A3	3.680	3.980	1	14.646
A4	5.880	0.500	1	2.940
A5	4.500	1.480	1	6.660
A6	3.400	3.700	1	12.580
A7	1.500	2.480	1	3.720
A8	5.000	3.600	1	18.000
A9	3.980	5.875	1	23.382
A10	3.680	6.380	1	23.478
TOTAL AREA FOR FLAT-3			=	160.104
TOTAL AREA FOR FLAT-3			=	160.104
AREA FOR FLAT-4				
TO BE ADDED				
NAME	LENGTH(MT.)	WIDTH(MT.)	NO.	AREA(SQ.MT.)
B1	3.415	4.750	1	16.221
B2	3.740	7.240	1	27.078
B3	3.680	4.680	1	17.222
B4	3.600	3.600	1	12.960
B5	3.400	3.700	1	12.580
B6	5.230	3.980	1	20.815
TOTAL AREA FOR FLAT-4			=	126.876
AREA FOR CIRCULATION				
TO BE ADDED				
NAME	LENGTH(MT.)	WIDTH(MT.)	NO.	AREA(SQ.MT.)
C1	1.300	3.400	1	4.420
C2	3.210	4.750	1	15.248
C3	3.680	3.980	1	14.646
C4	1.300	3.400	1	4.420
C5	4.130	3.980	1	16.437
C6	3.210	1.300	1	8.373
		TOTAL	=	54.116
	DOOR OPEN			
D1	1.000	2.100	1	2.100
D2	1.200	2.100	1	2.520
D3	0.900	2.100	1	1.890
D4	0.900	2.100	1	1.890
		TOTAL	=	8.400
TOTAL AREA FOR DOOR OPENING			=	62.516
TOTAL (F.A.R. AREA)			=	660.213

AREA (12TH FLOOR) (F.A.R. AREA)				
AREA FOR FLAT-1				
TO BE ADDED				
NAME	LENGTH(MT.)	WIDTH(MT.)	NO.	AREA(SQ.MT.)
A1	3.600	4.750	1	17.100
A2	1.280	5.150	1	13.248
A3	3.680	3.980	1	14.646
A4	5.880	0.500	1	2.940
A5	4.500	1.500	1	10.800
A6	3.400	3.700	1	12.580
A7	1.500	2.480	1	3.720
A8	5.000	3.600	1	18.000
A9	3.980	5.875	1	23.382
A10	3.680	6.380	1	23.478
TOTAL AREA FOR FLAT-1			=	160.024
TOTAL AREA FOR FLAT-1			=	160.024
AREA FOR FLAT-2				
TO BE ADDED				
NAME	LENGTH(MT.)	WIDTH(MT.)	NO.	AREA(SQ.MT.)
B1	3.415	4.750	1	16.221
B2	3.740	7.240	1	27.078
B3	3.680	4.680	1	17.222
B4	3.600	3.600	1	12.960
B5	3.400	3.700	1	12.580
B6	5.230	3.980	1	20.815
B7	4.130	4.750	1	19.617
TOTAL AREA FOR FLAT-2			=	126.473
AREA FOR CIRCULATION				
TO BE ADDED				
NAME	LENGTH(MT.)	WIDTH(MT.)	NO.	AREA(SQ.MT.)
C1	1.300	3.400	1	4.420
C2	3.210	4.750	1	15.248
C3	3.680	3.980	1	14.646
C4	1.300	3.400	1	4.420
C5	4.130	3.980	1	16.437
C6	3.210	1.300	1	8.373
		TOTAL	=	63.574
	DOOR OPEN			
D1	1.000	2.100	1	2.100
D2	1.200	2.100	1	2.520
D3	0.900	2.100	1	1.890
D4	0.900	2.100	1	1.890
		TOTAL	=	15.398
TOTAL AREA FOR CIRCULATION			=	63.574
TOTAL (F.A.R. AREA)			=	441.750

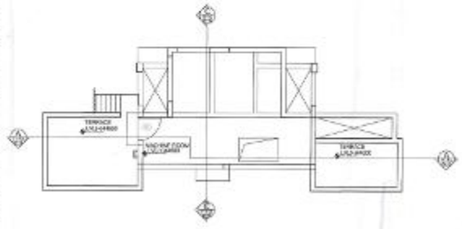

MUMTY TERRACE & MACHINE ROOM PLAN

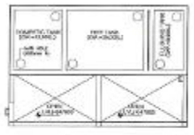

WATER TANK PLAN

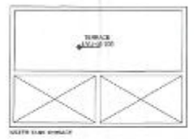

AREA (11TH & 12TH FLOOR) (COMPOUNDING AREA)				
TO BE ADDED				
NAME	LEN.(FEET)	WIDTH(MT.)	NO.	AREA(SQ.FT.)
A1	31.00	9.500	2	589
A3	31.00	9.500	2	589
M1	3.83	0.833	2	6.382
M1	3.750	2.166	2	16.245
N1	0.000	0.000	1	0.000
M2	3.660	1.166	2	25.620
N2	3.660	0.666	2	4.881
N4	3.660	0.666	1	51.540
N5	3.660	0.666	1	2.210
N6	0.000	0.000	1	0.000
TOTAL COMPOUNDING AREA			=	1117.000

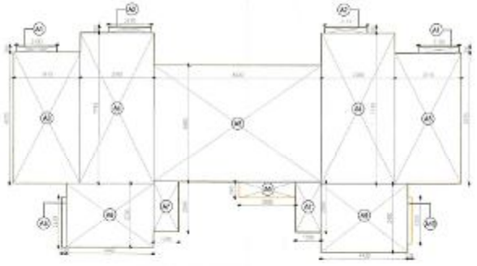

AREA DETAIL (BLOCK-5)
11TH & 12TH FLOOR
COMPOUNDING AREA

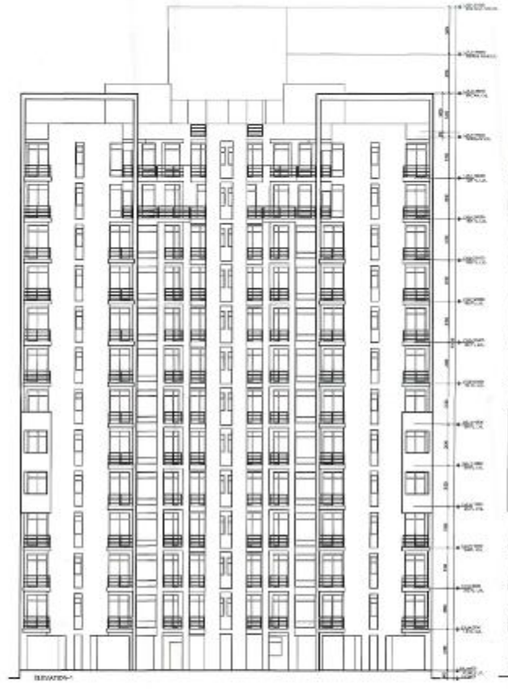

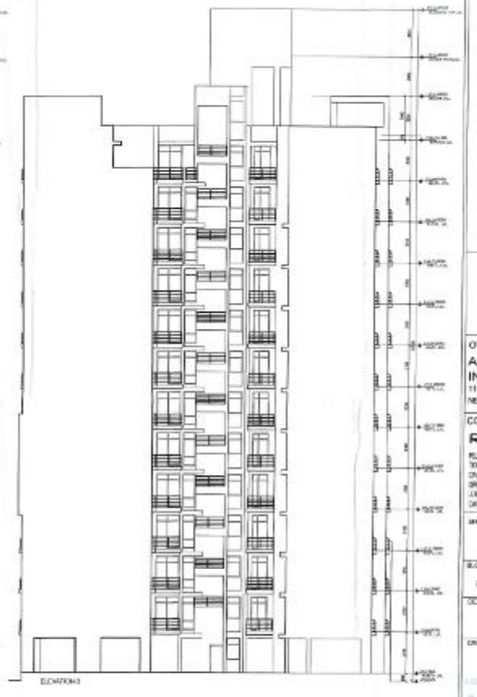

PROJECT:

AS BUILT DRAWING OF GROUP HOUSING (CELEBRITY GREENS) ON PLOT -1 (13.83 ACRES) AT POCKET-1,SECTOR-B , SUSHANT GOLF CITY, HI-TECH TOWNSHIP, LUCKNOW.

COMPOUNDABLE AREA

VARIATIONS

BLOCK-5 (F)
(CELEBRITY GREENS)

OWNERS
ANSAL PROPERTIES & INFRASTRUCTURE LTD.
115, ANSAL BHAWAN , 16 K.G MARG
NEW DELHI-110001

CONSULTANT
REPL
RUDRABHISHEK ENTERPRISES PVT. LTD.
TOWN & COUNTRY PLANNERS, ARCHITECTS & INTERIOR DESIGNERS SURVEY ONS, IN HOUSE CONSUMER,
GROUND FLOOR, TARA BHAWAN, MEA COMPLEX, LOHIA PATH MARG
LUCKNOW
CALL : (0522) 2208116

SHEET TITLE
FLOOR PLANS,ELEV. & AREA DETAIL
11th Floor to Terrace fir.

BLOCK TYPE	FLOOR
BLOCK - 5(F)	G+12
QUALITY	CHECKED BY
RAJ NEET	

OWNER | ARCHITECT

Scale	Date	Dg. No	REV.
1:100	23-06-2015	U/02/GH/5-B...1103	