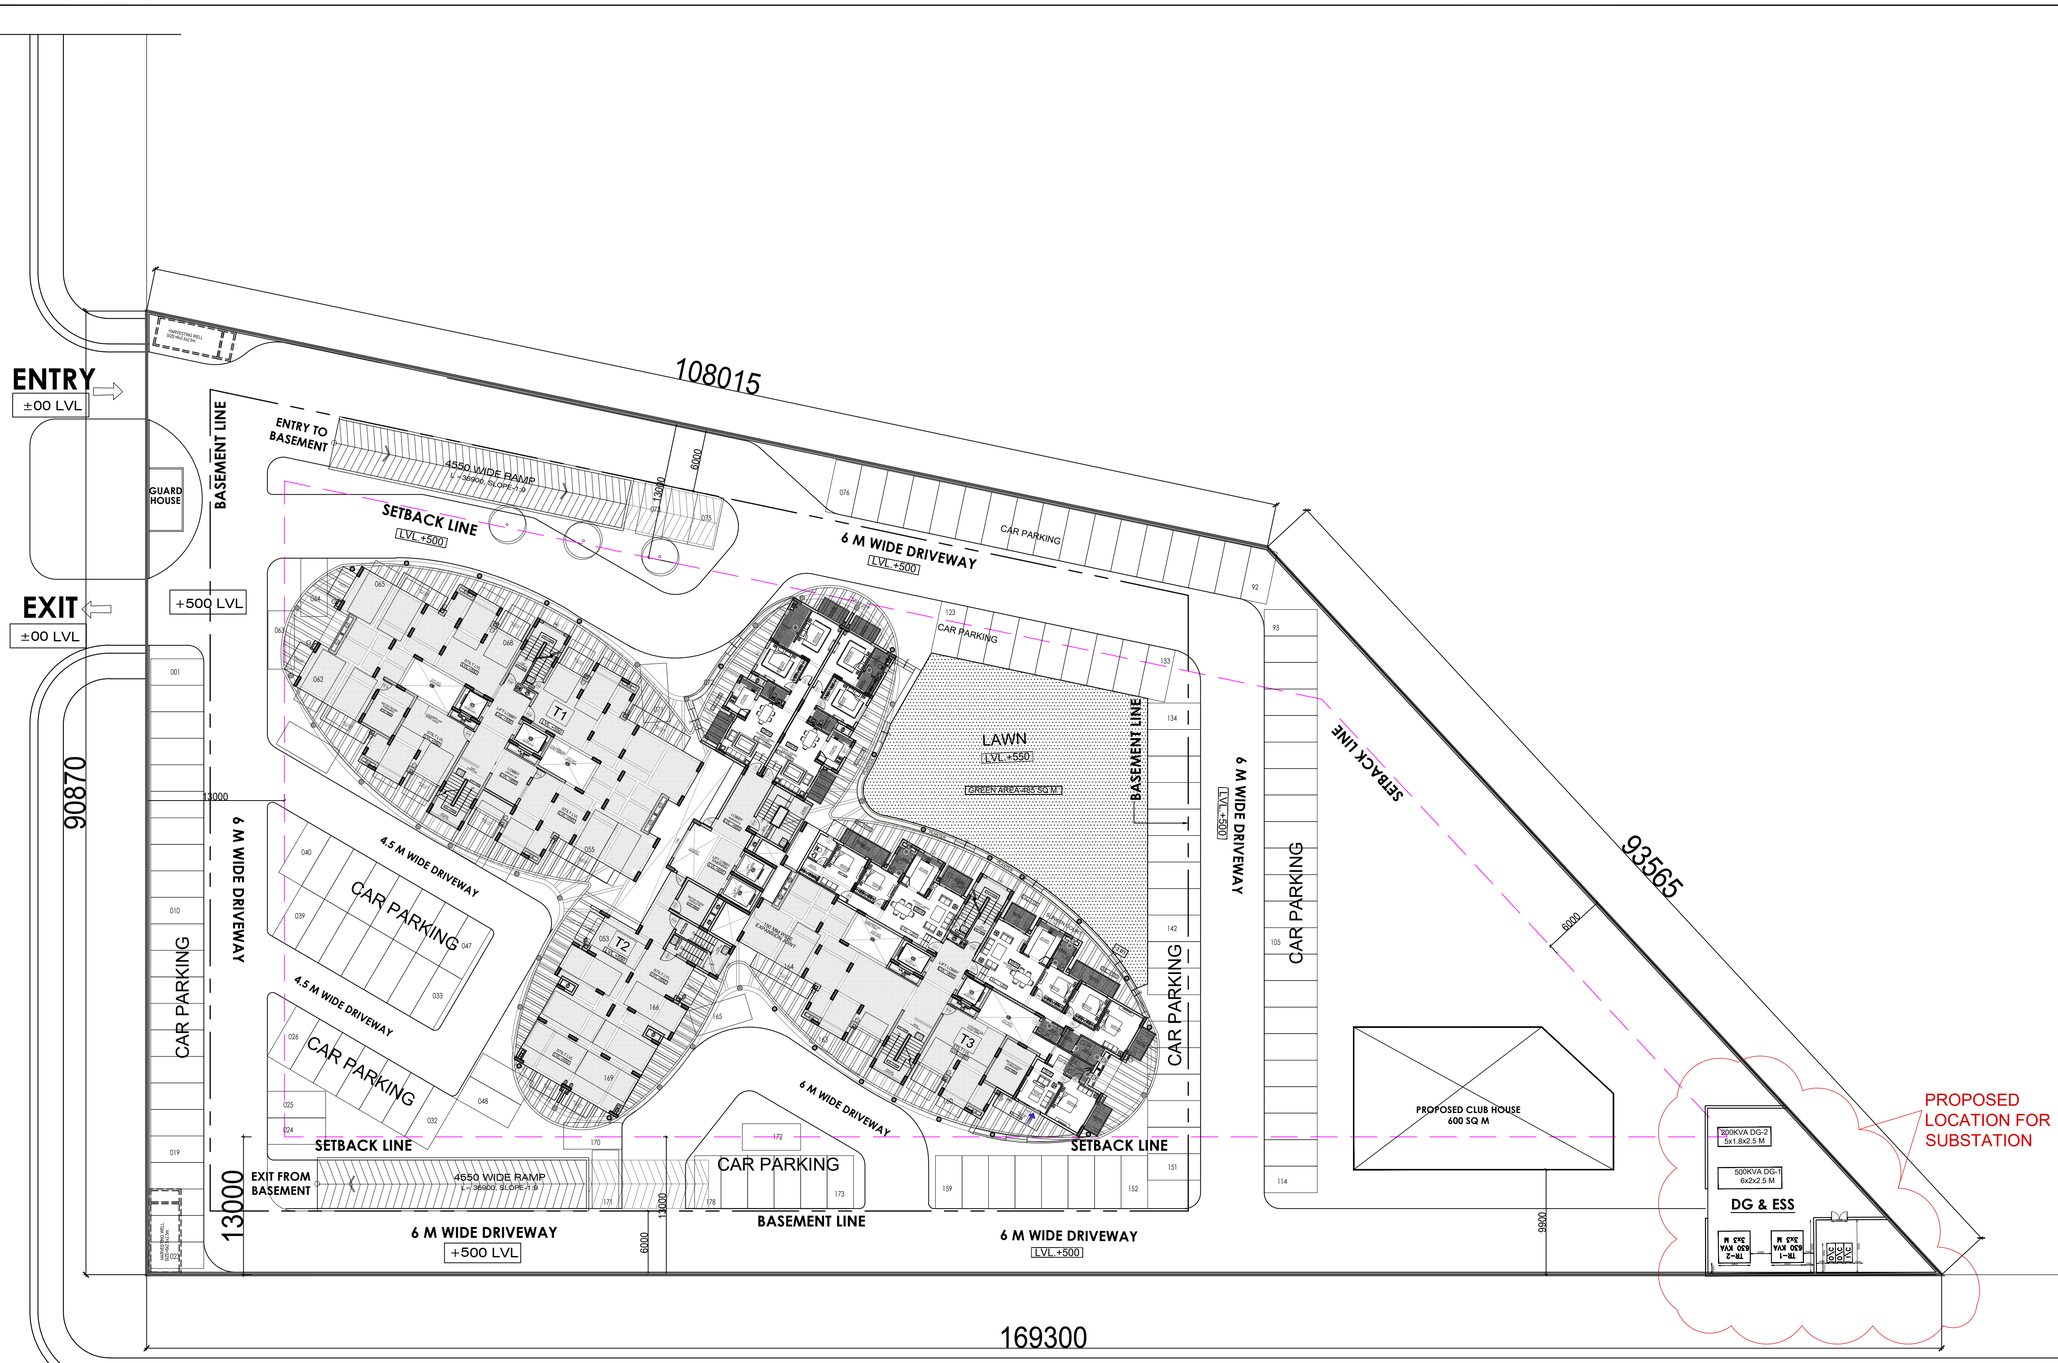

GENERAL NOTES

- ALL DIMENSIONS ARE IN MM, UNLESS OTHERWISE STATED.
- ONLY WRITTEN DIMENSIONS ARE TO BE FOLLOWED. DO NOT MEASURE THE DRAWING.
- ALL DRAWINGS ARE TO BE SIMULTANEOUSLY READ ALONG WITH RELEVANT SERVICES & CONSTRUCTION DRAWINGS, WHEREVER APPLICABLE.
- ALL MATERIAL FINISHES ARE TO BE EXPRESSEDLY APPROVED BY THE ARCHITECT &/OR THE RELEVANT CONSULTANTS.

LANDSCAPE

PLUMBING & FIRE

ELECTRICAL

STRUCTURAL

CE CON ENGG
NEW DELHI
E MAIL : - ssaabb@vsnl.com
TEL : - 98500 56948

OWNER

PROJECT: SSCPL HOUSING LUCKNOW

ARCHITECT

SIKKA ASSOCIATES ARCHITECTS
URBAN DESIGN | MASTERPLAN | ARCHITECTURE | INTERIORS | ENGINEERING | PROJECT MANAGEMENT
A: A-2/1, AFRICA AVENUE, SAFDARJUNG ENCLAVE, NEW DELHI, INDIA 110 029
T: +91.11.4323.5255 | F: +91.11.2628.4481 | E: saa@ssarcdu.net | W: www.ssarcdu.net

SEAL

ISSUED FOR

- INFORMATION & REVIEW
- TENDER
- SUBMISSION
- GFC
- AS BUILT

REVISIONS

#	DATE	DESCRIPTION
R1	30.06.2016	SITE AREA REVISED

SCALE	1:550@ A0
DATE ISSUED	2013/09/16
DRAWN BY	NAVIN
CHECKED BY	

DRAWING: **STILT LVL PLAN**

DWG NO.: SSCPL/A1-104