LEGENDS -

S.NO	SYMBOL	DESCRIPTION
1.		TELEPHONE POINT
2.		ELECTRICAL DISTRIBUTION BOARD
3.		METER PANEL
4.		EPABX BOX
5.		CAMERA
6.		TELEPHONE TAG BLOCK
7.		50mm DIA SLEEVE FOR CABLE ENTRY

CLIENT

M/s KUMAR RASTOGI INFRASTRUCTURE Private Limited,
Site Office :- Plot No. CP-11, Yamunapuram Commercial Scheme, Bulandshahr (Uttar Pradesh) 203001

PROJECT NAME

Proposed Commercial/ Residential Housing on Plot No. CP - 11 ,Yamunapuram Commercial Scheme, Bulandshahr, U.P

ARCHITECT

jsr
architecture. interiors. pmc
C-67, Defence colony New delhi

ELECTRICAL CONSULTANT

ENGINEERING CONSULTANCY & MANAGEMENT SERVICES

ELECTRICAL CONTRACTOR

POSCO POWER PROJECT
PLOT NO.33 SAI ENCLAVE
SECTOR-23, DWARKA
NEW DELHI- 110075
TEL: 011-65649719

DWG.TITLE:-
ELECTRICAL AS BUILT DRAWING LAYOUT
SEL TO 5TH FLOOR

☐ PRELIMINARY LAYOUT	☐ ADVANCE COPY
■ FOR APPROVAL	☐ ISSUE FOR CONSTRUCTION
☐ TENDER DRAWING	☐ REFERENCE DRAWING

DRAWN BY	NIGHT SMART	REV NO.	R1(10.07.18)
CHD BY	MR. ARIF	SCALE	1:100(A1)
FIN. YEAR	2016-17	JOB NO.	1214

DRAWING NO. ROHINI SMART/1214/3RD FLOOR /EL/NO-05

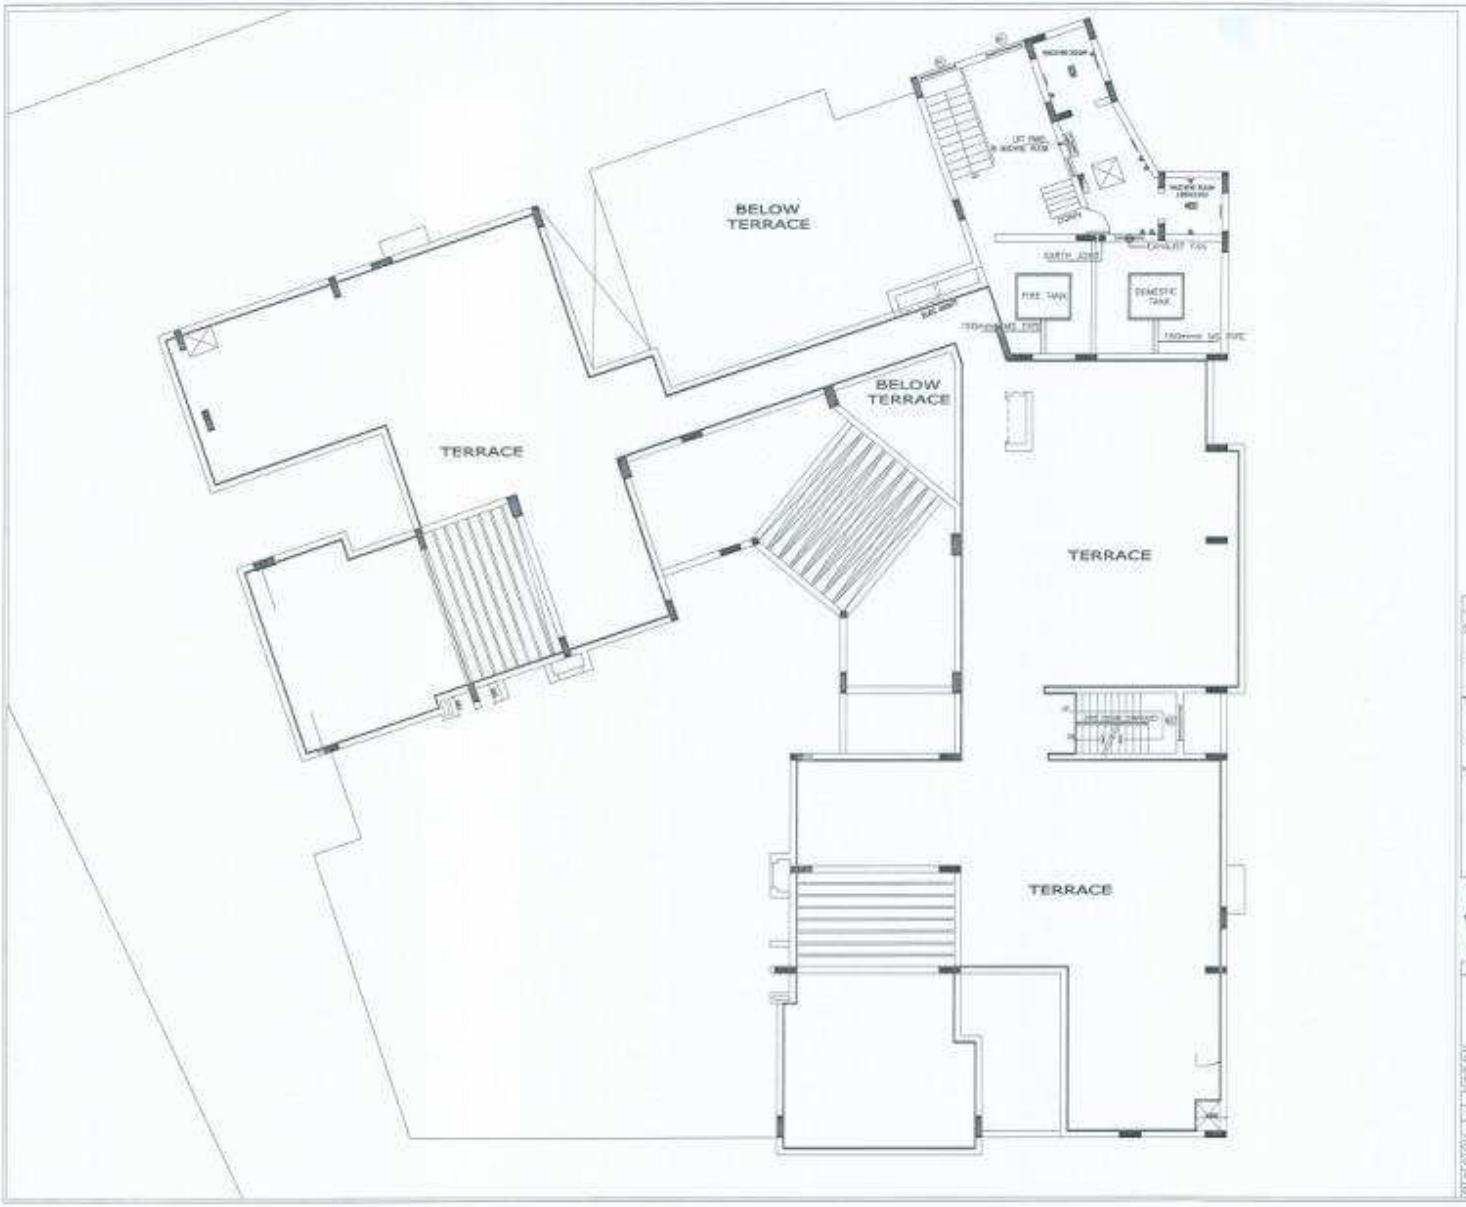

Authorised Signatory

CLIENT

M/s KUMAR RASTOGI INFRASTRUCTURE Private Limited,
Site Office :- Plot No. CP-11, Yamunapuram Commercial Scheme Bulandshahr (Uttar Pradesh) 203001

PROJECT NAME

Proposed Commercial/ Residential Housing on Plot No. CP - 11 ,Yamunapuram Commercial Scheme, Bulandshahr, U.P

ARCHITECT

jsr
architecture. Interiors. pmc
C-67, Defence colony New delhi
Phone-011-46080030, Email: csj1976@gmail.com

ELECTRICAL CONSULTANT

ENGINEERING CONSULTANCY & MANAGEMENT SERVICES
P-4/92, Ground Floor Lado Sarai Behind CNG Gas Pump In Delhi-30
E-Mail: ecms.delhi@gmail.com
Ph No. 011-42701084

ELECTRICAL CONTRACTOR

PEECO POWER PROJECT
PLOT NO.33 SAI ENCLAVE
SECTOR-23, DWARKA
NEW DELHI- 110075
TEL 011-65049719

DWG TITLE:-
ELECTRICAL AS BUILT DRAWING LAYOUT
TERRACE FLOOR PLAN

☐ PRELIMINARY LAYOUT	☐ ADVANCE COPY
■ FOR APPROVAL	☐ ISSUE FOR CONSTRUCTION
☐ TENDER DRAWING	☐ REFERENCE DRAWING

DRAWN BY	MOHIT RAWAT	REV NO.	02(20.05.16)
CHK BY	MR. KPP	SCALE	1:75(A1)
FIN. YEAR	2016-17	JOB NO.	1219

DRAWING NO. RESIDENCE QUARTER/EOWS/TYP FLOOR /01/A1-02

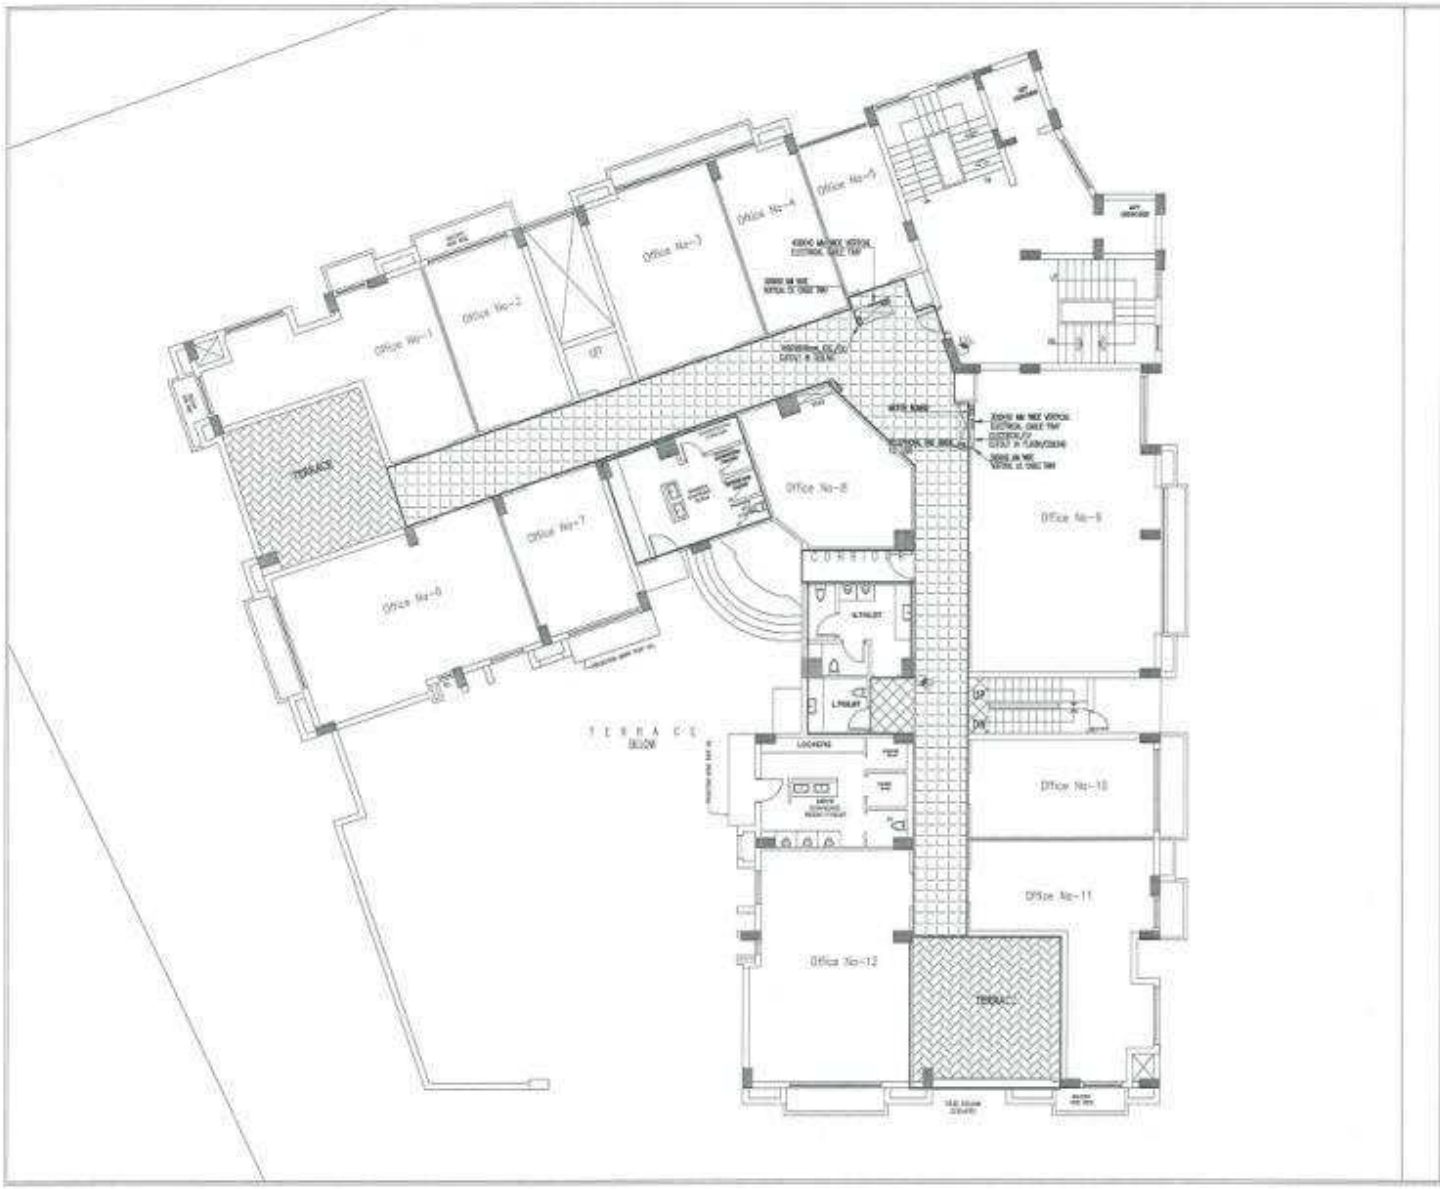

LEGENDS:-

S.NO	SYMBOL	DESCRIPTION
1.		TELEPHONE POINT
2.		ELECTRICAL DISTRIBUTION BOARD
3.		METER PANEL
4.		OPEN BOX
5.		CAMERA
6.		TELEPHONE TAG SLIDER
7.		32mm. DIA SLEEVE FOR CABLE ENTRY

CLIENT

M/s KUMAR RANTOGI INFRASTRUCTURE Private Limited,
Site Office :- Plot No. CP-11, Yamunapuram Commercial Scheme, Bulandshahr
(Uttar Pradesh) 203001

PROJECT NAME

Proposed Commercial/ Residential Housing on Plot No. CP - 11 ,Yamunapuram Commercial Scheme, Bulandshahr, U.P

ARCHITECT

jsr
architecture, interiors, pmc
C-67, Defence colony New delhi

ELECTRICAL CONSULTANT

ENGINEERING CONSULTANCY & MANAGEMENT SERVICE

ELECTRICAL CONTRACTOR

PIECO POWER PROJECT
PLOT NO.83 SAI ENCLAVE
SECTOR-23, DWARKA
NEW DELHI- 110075
TEL 011-65669719

DWG.TITLE:-
ELECTRICAL AT BASEMENT FLOOR
FIRST FLOOR

☐ PRELIMINARY LAYOUT	☐ ADVANCE COPY
■ FOR APPROVAL	☐ ISSUED FOR CONSTRUCTION
☐ TENDER DRAWING	☐ REFERENCE DRAWING

DRAWN BY	MOHIT PANDE	REV NO.	ISSUE U.P. (R)
CHD BY	MR. ARIF	SCALE	1:75(A1)
DW. YEAR	2016-17	JOB NO.	1216

DRAWING NO. ROHTAS SUMMIT/ESMC/1ST FLOOR (EL/BO-1)

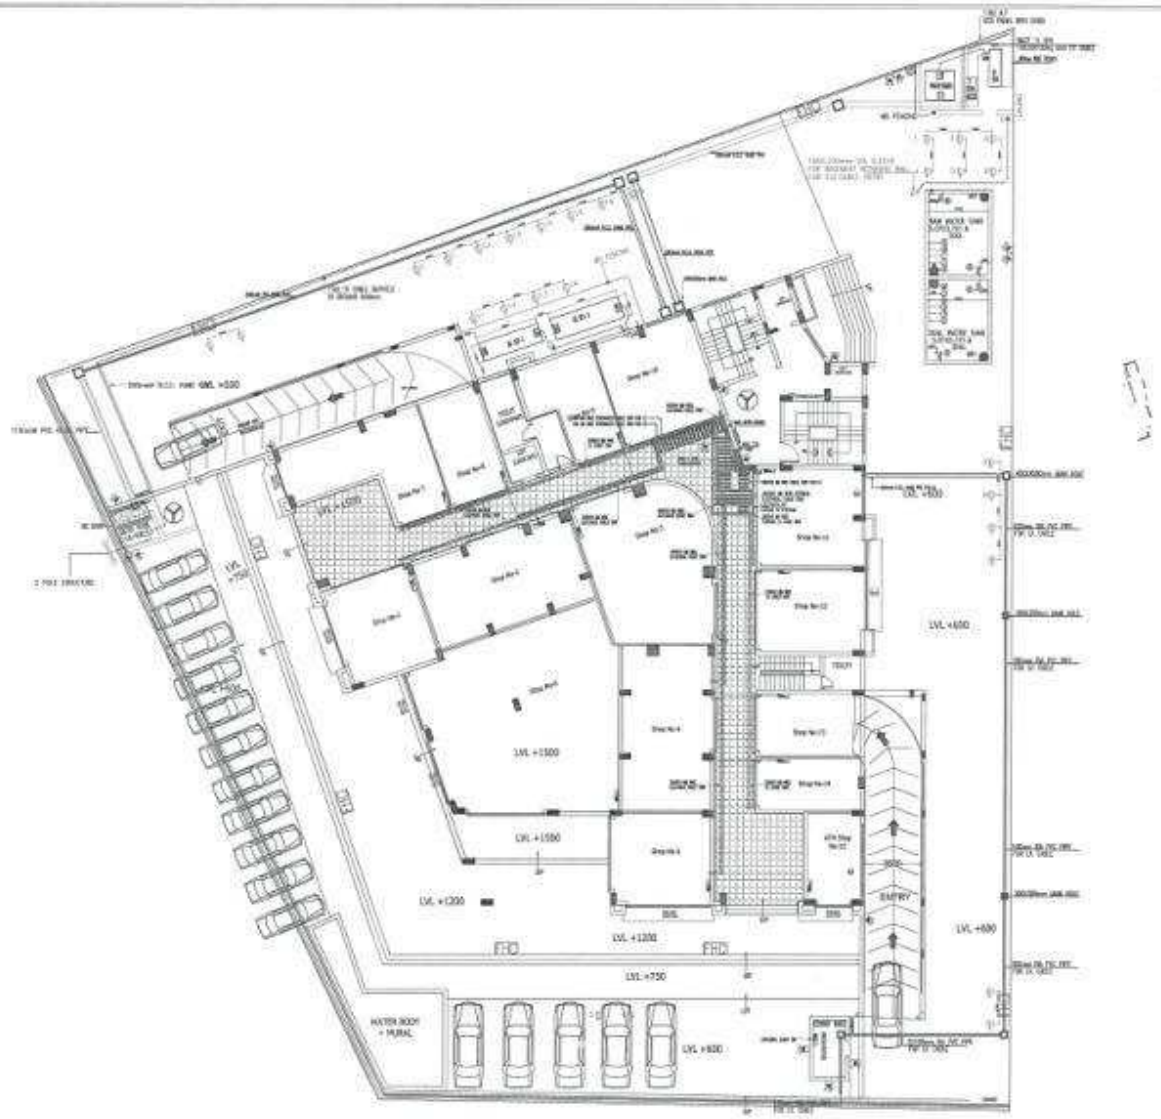

GROUND FLOOR PLAN

LEGENDS –

S.NO	SYMBOL	DESCRIPTION
1.		TELEPHONE POINT
2.		ELECTRICAL DISTRIBUTION BOARD
3.		METER PANEL
6.		TELEPHONE TAG BLOCK
7.		32mm DIA SLEEVE FOR CABLE DI

SYMBOL	EQUIPMENT NAME	MATERIAL	QTY
[illegible]	HT METER	[illegible]	[illegible]
[illegible]	TRANSFORMER NEUTRAL	COPPER	[illegible]
[illegible]	TRANSFORMER BODY	[illegible]	[illegible]
[illegible]	LT PANEL (LT PANEL)	[illegible]	[illegible]
[illegible]	LIFT	[illegible]	[illegible]
[illegible]	DG-1 NEUTRAL	COPPER	[illegible]
[illegible]	DG-1 BODY	[illegible]	[illegible]
[illegible]	[illegible]	[illegible]	[illegible]
[illegible]	[illegible]	[illegible]	[illegible]

CLIENT

M/s KUMAR RASTOGI INFRASTRUCTURE Private Limited,
Site Office – Plot No. CP-11,Yamunapuram Commercial Scheme Bulandshahr (Uttar Pradesh) 203001

PROJECT NAME

Proposed Commercial/ Residential Housing on Plot No. CP - 11 ,Yamunapuram Commercial Scheme, Bulandshahr, U.P

ARCHITECT

jsr.
architecture. interiors. pmc
C-67 , Defence colony New delhi
Phone-011-40500500, Email: [illegible]

ELECTRICAL CONSULTANT

ENGINEERING CONSULTANCY & MANAGEMENT SERVICES
F-420, Ground Floor Lado Sarai
Behind Civil Gas Pump, N.Delhi-30
E-mail: [illegible]
Ph.No. 91-[illegible]

ELECTRICAL CONTRACTOR

FIECO POWER PROJECT
PLOT NO.05 SAI ENCLAVE
SECTOR-23, DWARKA
NEW DELHI- 110075
TEL: 011-65649718

DWG TITLE :-
ELECTRICAL AS BUILT DRAWING
GROUND FLOOR

☐ PRELIMINARY LAYOUT	☐ ADVANCE COPY
■ FOR APPROVAL	☐ GOOD FOR CONSTRUCTION
☐ TENDER DRAWING	☐ REFERENCE DRAWING

DRAWN BY	[illegible]	REV NO.	[illegible]
CHD BY	[illegible]	SCALE	1:100(A0)
FIN YEAR	2016-17	JOB NO.	[illegible]

DRAWING NO. [illegible]

SERVICE FLOOR PLAN

NOTES

1. ALL DIMENSION ARE IN mm.
2. DO NOT SCALE ANY DIMENSION.

LEGEND	DESCRIPTION	MTG HEIGHT (mm)
	[illegible]	AS SHOWN
	[illegible]	[illegible]
	[illegible]	[illegible]
	[illegible]	[illegible]
	[illegible]	[illegible]
	[illegible]	[illegible]
	[illegible]	[illegible]
	[illegible]	[illegible]
	[illegible]	[illegible]
	[illegible]	[illegible]
	[illegible]	[illegible]
	[illegible]	[illegible]
	[illegible]	[illegible]
	[illegible]	[illegible]
	[illegible]	[illegible]
	[illegible]	[illegible]
	[illegible]	[illegible]
	[illegible]	[illegible]
	[illegible]	[illegible]
	[illegible]	[illegible]

No.	REVISION	DATE

Structural Engineer


Authorised Signatory

M/s KUMAR BASTOGI INFRASTRUCTURE Private Limited,
Site Office :- Plot No. CP-11, Yamunapuram Commercial Scheme Bulandshahr (Uttar Pradesh) 203001

PROJECT

Proposed Commercial / Residential Housing on Plot No. CP-11, Yamunapuram Commercial Scheme, Bulandshahr, U.P.

DRAWING TITLE

SERVICE FLOOR PLAN
(BETWEEN GROUND & 1st FLOOR)

ARCHITECT

jsr architects
jsr architecture, interiors, pmc
C-87, Defence colony New delhi
Phone: 011-[illegible], Email: [illegible]

Scale	N.T.S	North N
Date	12-07-13	
Drawn	Manoj	
Checked		
DRG. NO.	E-104	REVISION

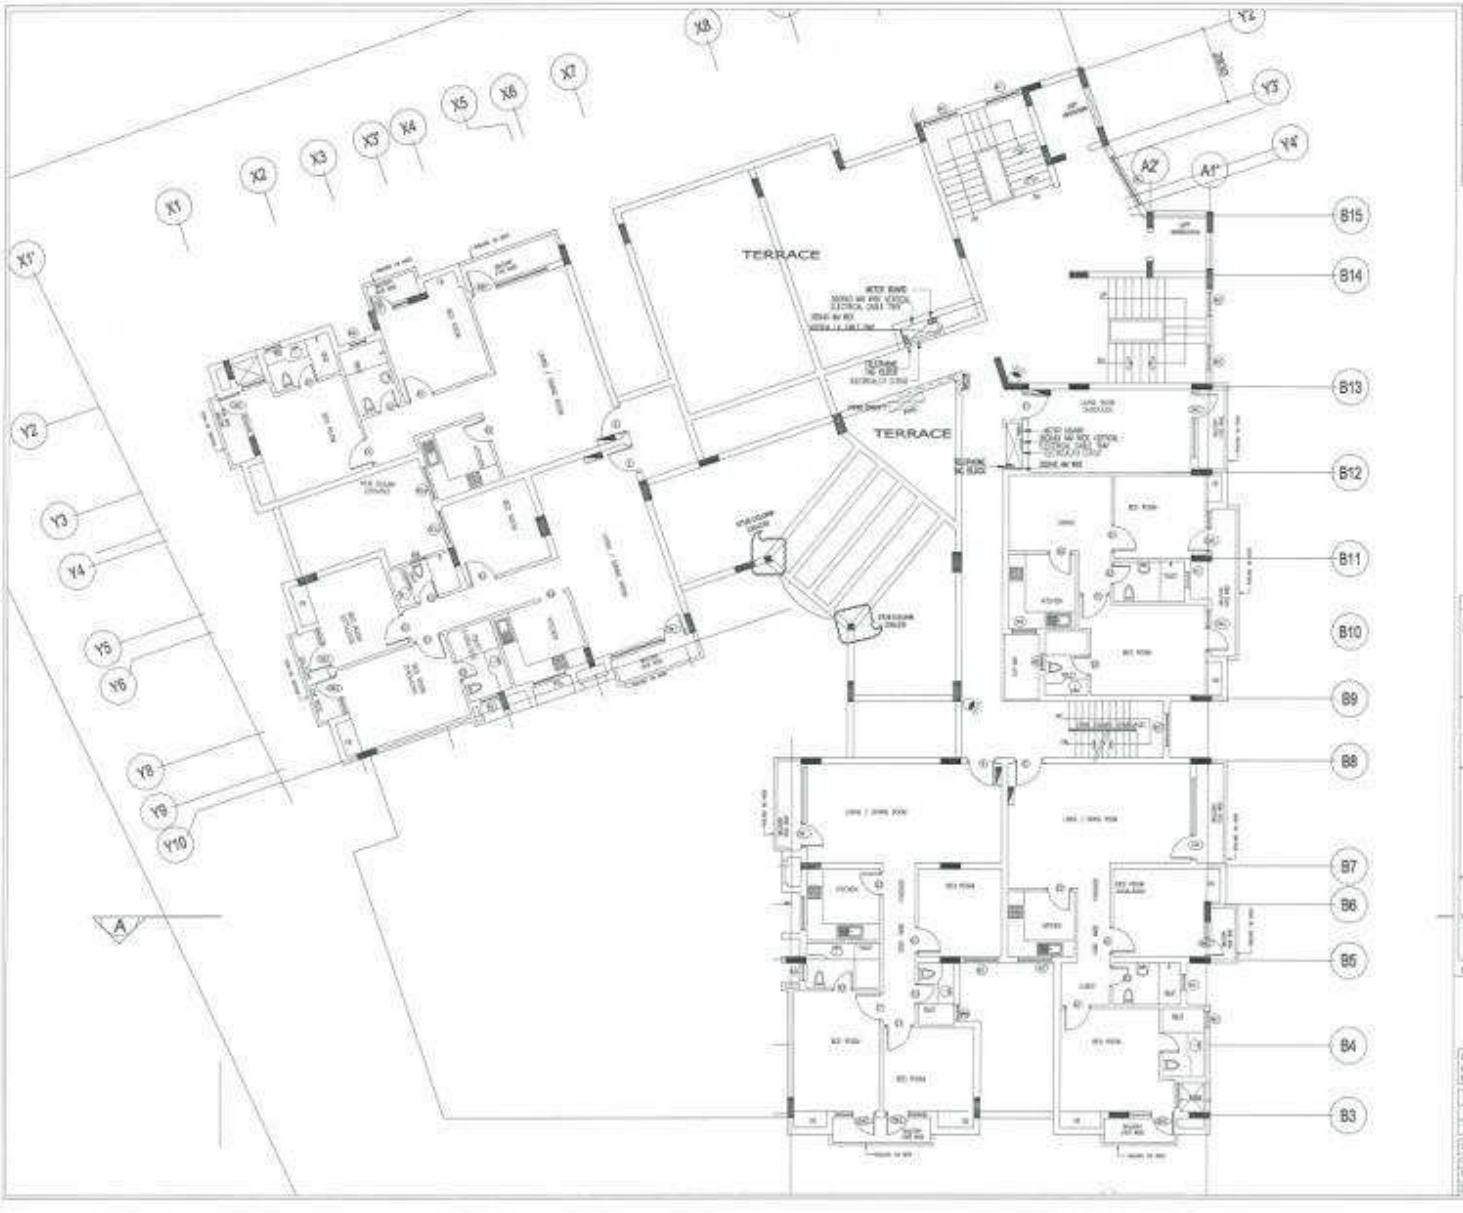

LEGENDS :-

S.NO	SYMBOL	DESCRIPTION
1.		TELEPHONE POINT
2.		ELECTRICAL DISTRIBUTION BOARD
3.		METER PANEL
4.		CEILING BOX
5.		CAMERA
6.		TELEPHONE TAG BLOCK
7.		32mm DIA SLEEVE FOR CABLE ENTRY

For Kumar Rastogi Infrastructure Pvt. Ltd.
Authorised Signatory

CLIENT :
M/s KUMAR RASTOGI INFRASTRUCTURE Private Limited,
Site Office :- Plot No. CP-11, Yamunapuram Commercial Scheme, Bulandshahr (Uttar Pradesh) 203001

PROJECT NAME :
Proposed Commercial/ Residential Housing on Plot No. CP - 11 , Yamunapuram Commercial Scheme, Bulandshahr, U.P

ARCHITECT :
jsr.
architecture. interiors. pmc
C-47, Defence colony New delhi
Phone- 011-40500501, Email- csj1974@gmail.com

ELECTRICAL CONSULTANT :
ENGINEERING CONSULTANCY & MANAGEMENT SERVICE
F-420, Ground Floor Lado Sarai Behind CNG Gas Pump, N.Delhi-30
e-mail: emsl_delhi@gmail.com
Ph. No. 011-40570334

ELECTRICAL CONTRACTOR :
PIECO POWER PROJECT
PLOT NO.39 NAI ENCLAVE
SECTOR-21, DWARKA
NEW DELHI- 110075
TEL: 011-65648719

DWG TITLE :

☐ PRELIMINARY LAYOUT	☐ ARRANGE COPY
■ FOR APPROVAL	☐ GOOD FOR CONSTRUCTION
☐ TENDER DRAWING	☐ REFERENCE DRAWING



FIRST FLOOR PLAN

NOTES

1. ALL DIMENSION ARE IN mm.
2. DO NOT SCALE ANY DRAWING

LEGEND	DESCRIPTION	NOT A PART OF WORK

LEGENDS :-

S.NO	SYMBOL	DESCRIPTION
1.		TELEPHONE POINT
2.		ELECTRICAL DISTRIBUTION BOARD
3.		METER PANEL
6.		TELEPHONE PAIR BLOCK
7.		20mm DIA SLEEVE FOR CABLE ENTRY


CLIENT

M/s KUMAR RASTOGI INFRASTRUCTURE Private Limited,
Site Office :- Plot No. CP-11, Yamunapuram Commercial Scheme, Bulandshahr (Uttar Pradesh) 203001

PROJECT NAME

Proposed Commercial/ Residential Housing on Plot No. CP - 11 ,Yamunapuram Commercial Scheme, Bulandshahr, U.P

ARCHITECT

jsr.
architecture. interiors. pmc
C-67 , Defence colony New delhi
Phone-011-46560200, Email: rajjr99@gmail.com

ELECTRICAL CONSULTANT

ENGINEERING CONSULTANCY & MANAGEMENT SERVICES
F-1/82, Ground Floor Lado Sarai
Behind CNG Gas Pump N.Delhi-30
e-mail: emsindia1997@gmail.com
Ph No 011-42701004

ELECTRICAL CONTRACTOR

PIECO POWER PROJECT
PLOT NO.30 SAI ENCLAVE
SECTOR-23, DWARKA
NEW DELHI- 110075
TEL 011-65649719

DWG TITLE :-
ELECTRICAL AS BUILT DRAWING LAYOUT
SECOND FLOOR

☐ PRELIMINARY LAYOUT	☐ ADVANCE COPY
■ FOR APPROVAL	☐ ISSUE FOR CONSTRUCTION
☐ TENDER DRAWING	☐ REFERENCE DRAWING

DRAWN BY	MS-F RAM/	REV NO	R2(03.01.18)
CHD BY	MR. ARJ/	SCALE	1:75MM
FIN. DATE	2016-17	JOB NO.	1212

DRAWING NO. RGNTCS SUMMIT/ENG/2ND FLOOR /ELAS-04

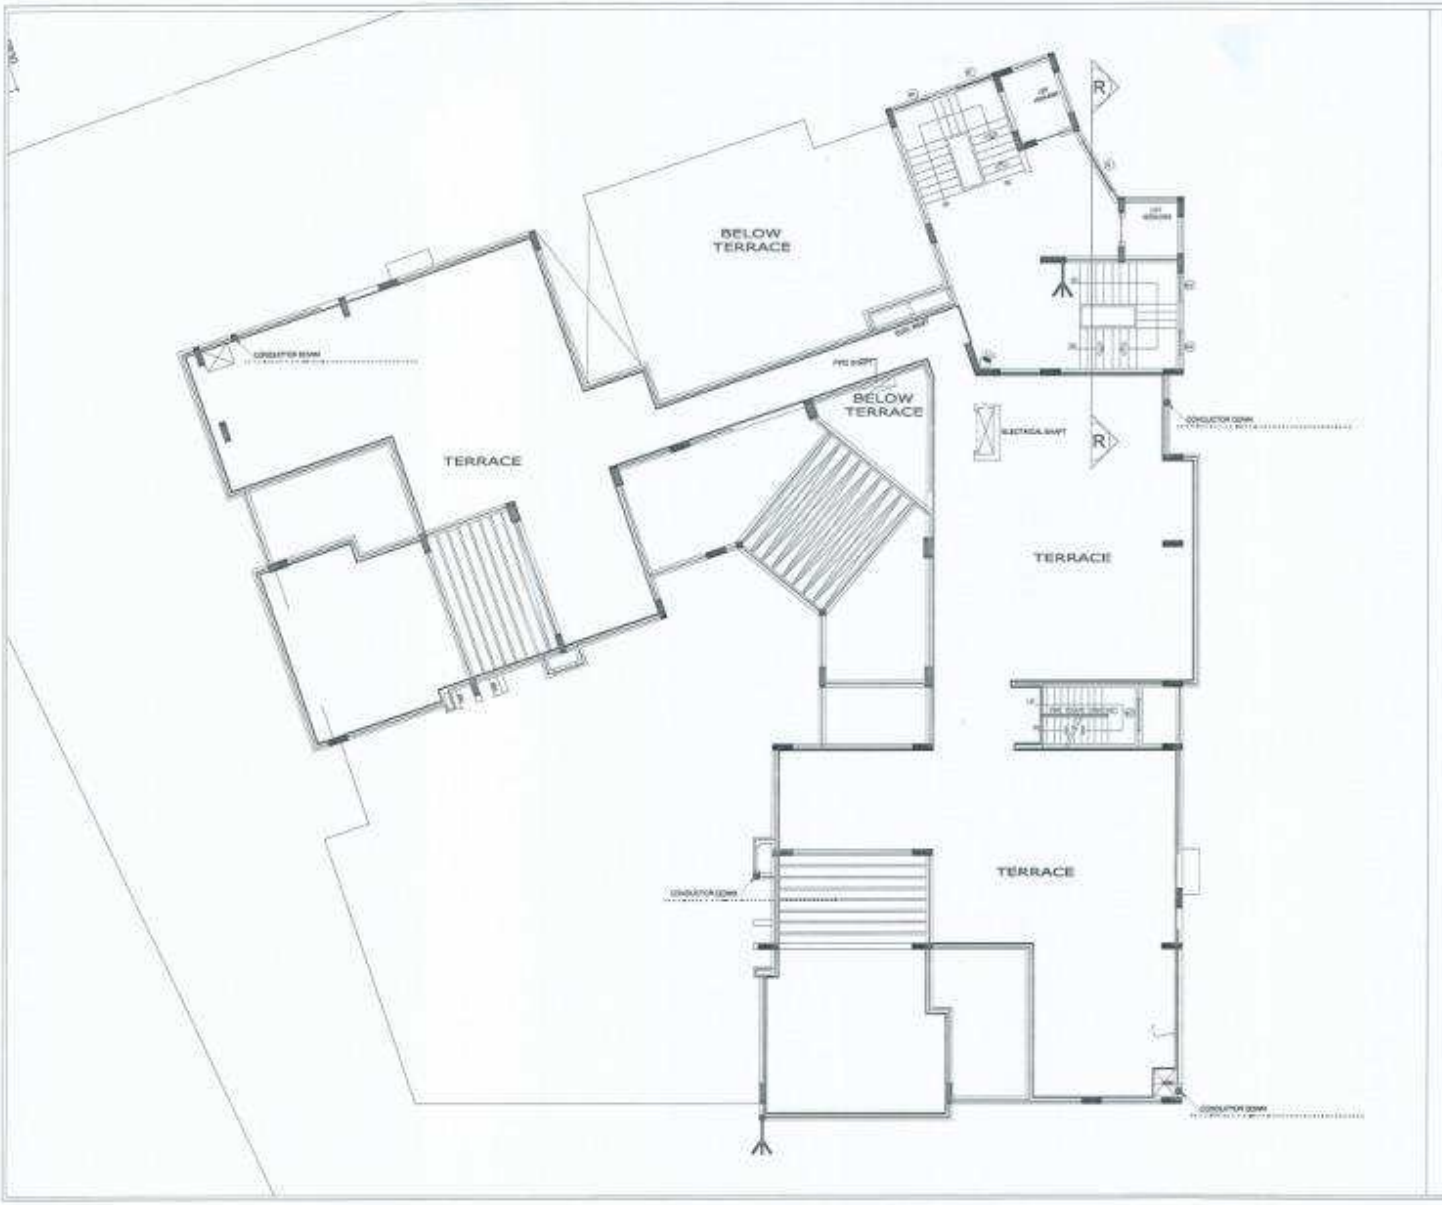

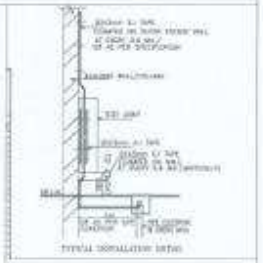

For Kumar Rastogi Infrastructure Pvt. Ltd.
Authorised Signatory

CLIENT
M/s KUMAR RASTOGI INFRASTRUCTURE Private Limited,
Site Office :- Plot No. CP-11, Yamunapuram Commercial Scheme Bulandshahr
(Uttar Pradesh) 203001

PROJECT NAME
Proposed Commercial/ Residential Housing on Plot No. CP - 11 ,Yamunapuram Commercial Scheme, Bulandshahr, U.P

ARCHITECT
jsr
architecture. Interiors. pmc
C-67 , Defence colony New delhi
Phone: 011-40500200, Email: arch1974@gmail.com

ELECTRICAL CONSULTANT
ECMS
ENGINEERING CONSULTANCY & MANAGEMENT SERVICES
F-232, Ground Floor Lado Sarai
Behind CNG Gas Pump N-Delhi-30
e-mail: ecms.tech2@gmail.com
Ph.No. 011-42510004

ELECTRICAL CONTRACTOR
FUDCO POWER PROJECT
PLOT NO.30 SAI ENCLAVE
SECTOR-25, DWARKA
NEW DELHI- 110075
TEL: 011-85640719

DWG TITLE :-
ELECTRICAL AT ROOF DRAWING LAYOUT
TERRACE FLOOR PLAN

☐ PRELIMINARY LAYOUT	☐ REVISED COPY
■ FOR APPROVAL	☐ ISSUE FOR CONSTRUCTION
☐ TENDER DRAWING	☐ REFERENCE DRAWING

DRAWN BY	ROHIT SHARMA	REV NO.	R2/01/04/10
CHD BY	MR. JAIN	SCALE	1:75(A1)
FIN. YEAR	2016-17	JOB NO.	1279

DRAWING NO. ROHIT SHARMA/EDWG/TYP FLOOR /ELL/00-06

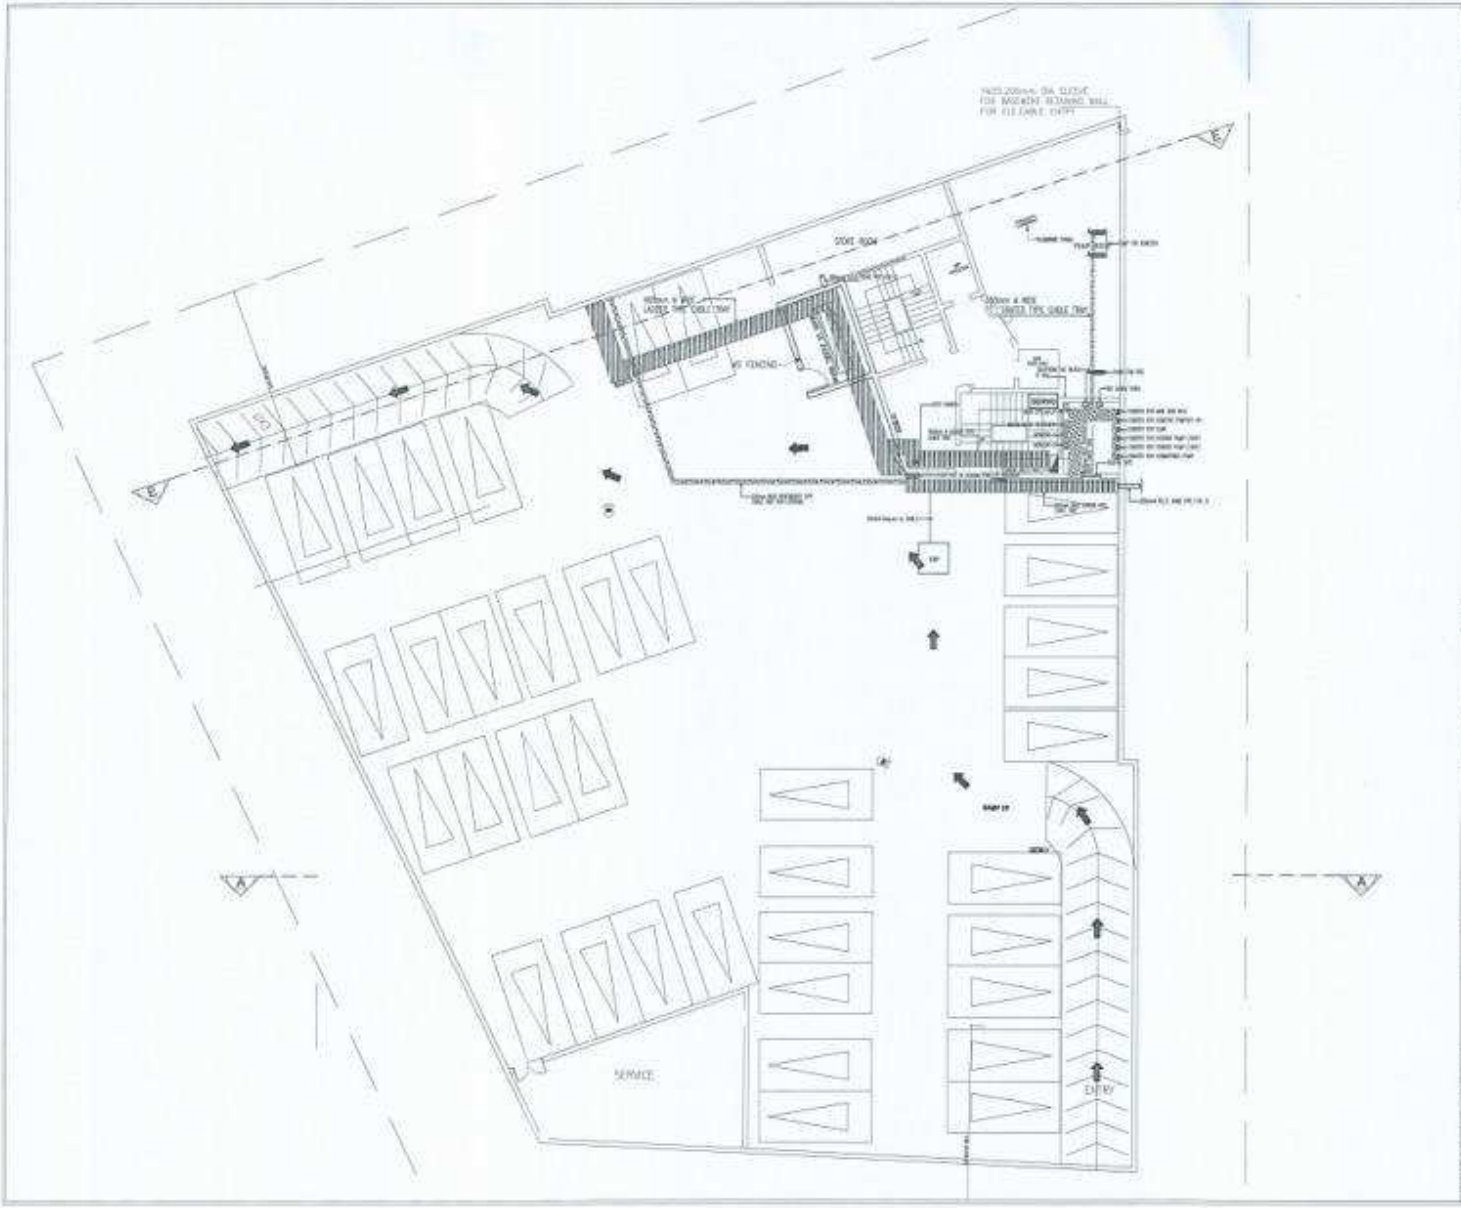

LEGENDS:-

S.NO	SYMBOL	DESCRIPTION
1.		TELEPHONE POINT
2.		ELECTRICAL DISTRIBUTION BOARD
3.		METER PANEL
4.		STMER BOX
5.		CAMERA
6.		TELEPHONE TAG BLOCK
7.		32mm DIA SLEEVE FOR CABLE ENT

CLIENT

M/s KUMAR KASTOGI INFRASTRUCTURE Private Limited,
Site Office :- Plot No. CP-11,Yamunapuram Commercial Scheme,Bulandshahr (Uttar Pradesh) 203001

PROJECT NAME

Proposed Commercial/ Residential Housing on Plot No. CP - 11 ,Yamunapuram Commercial Scheme, Bulandshahr, U.P

ARCHITECT

jsr
architecture. interiors. pmc
C-67, Defence colony New delhi
Phone 011-40566100, Email : mail@jsrindia.com

ELECTRICAL CONSULTANT

ENGINEERING CONSULTANCY & MANAGEMENT SERVICE
F-202, Ground Floor Lado Sarai
Behind CNG Gas Pump N.Delhi-30
e-mail: ecms.delhi@gmail.com
Ph.No. 011-4679 1004

ELECTRICAL CONTRACTOR

FIECO POWER PROJECT
PLOT NO.53 SAI ENCLAVE
SECTOR-25, DWARKA
NEW DELHI- 110075
TEL: 011-45649719

FACILITY:-
ELECTRICAL RISER DRAWING
BASEMENT

☐ PRELIMINARY LAYOUT	☐ ADVANCE COPY
■ FOR APPROVAL	☐ GOOD FOR CONSTRUCTION
☐ TENDER DRAWING	☐ REFERENCE DRAWING

DRAWN BY	AKANT PANDAY	REV NO.	02,03,01,02
CKD BY	MR. MR	SCALE	1:75(A1)
FIN. YEAR	2016-17	JOB NO.	1216

DRAWING NO. 1516/KC SUMMIT/CON/BASEMENT/EL/NO-01

PRODUCED BY AN AUTODESK EDUCATIONAL PRODUCT

GROUND FLOOR PLAN

S.NO.	LEGENDS
1	SOLAR STUD LIGHT
2	POST TOP LAMP
3	POLE LIGHTS
4	TSP FP MCB ISOLATOR BOX
5	CONTROL LP FOR DIMMING POLE LIGHTS
6	NORMAL LIGHT LOOPING
7	FLOOD LIGHT

For Kumar Rastogi Infrastructure Pvt. Ltd.
Authorised Signatory

CLIENT

M/s KUMAR RASTOGI INFRASTRUCTURE Private Limited,
Site Office :- Plot No. CP-11,Yamunapuram Commercial Scheme Bulandshahr (Uttar Pradesh) 203001

PROJECT NAME

Proposed Commercial Residential Housing on Plot No. CP - 11 ,Yamunapuram Commercial Scheme, Bulandshahr, U.P

ARCHITECT

jsr.
architecture. interiors. pmc
C-67 , Defence colony New delhi
Phone-011-4008140, Email: mail@jsrdesigns.com

ELECTRICAL CONSULTANT

ENGINEERING CONSULTANCY & MANAGEMENT SERVICE
F-4/22, Ground Floor Lado Sarai
Behind Civil Gas Pump, Mehrauli
Email: [illegible]@gmail.com
Ph.No. [illegible]

ELECTRICAL CONTRACTOR

FIECO POWER PROJECT
PLOT NO.55 SAI ENCLAVE
SECTOR-23, DWARKA
NEW DELHI- 110075
TEL: 011-65649719

SUBJECT :-
EXTERNAL LIGHTING AS BUILT LAYOUT

☐ PRELIMINARY LAYOUT	☐ ADVANCE COPY
■ FOR APPROVAL	☐ GOOD FOR CONSTRUCTION
☐ TENDER DRAWING	☐ AS BUILT DRAWING

DRAWN BY	MOHIT ARORA	REV. NO.	R0(17.06.15)
CHD BY	MR. ARIF	SCALE	1:750(A1)
FIN. YEAR	2016-17	JOB NO.	1210

DRAWING NO. FIECO/SAI ENCLAVE/DWARKA/EL/R0-02

PRODUCED BY AN AUTODESK EDUCATIONAL PRODUCT